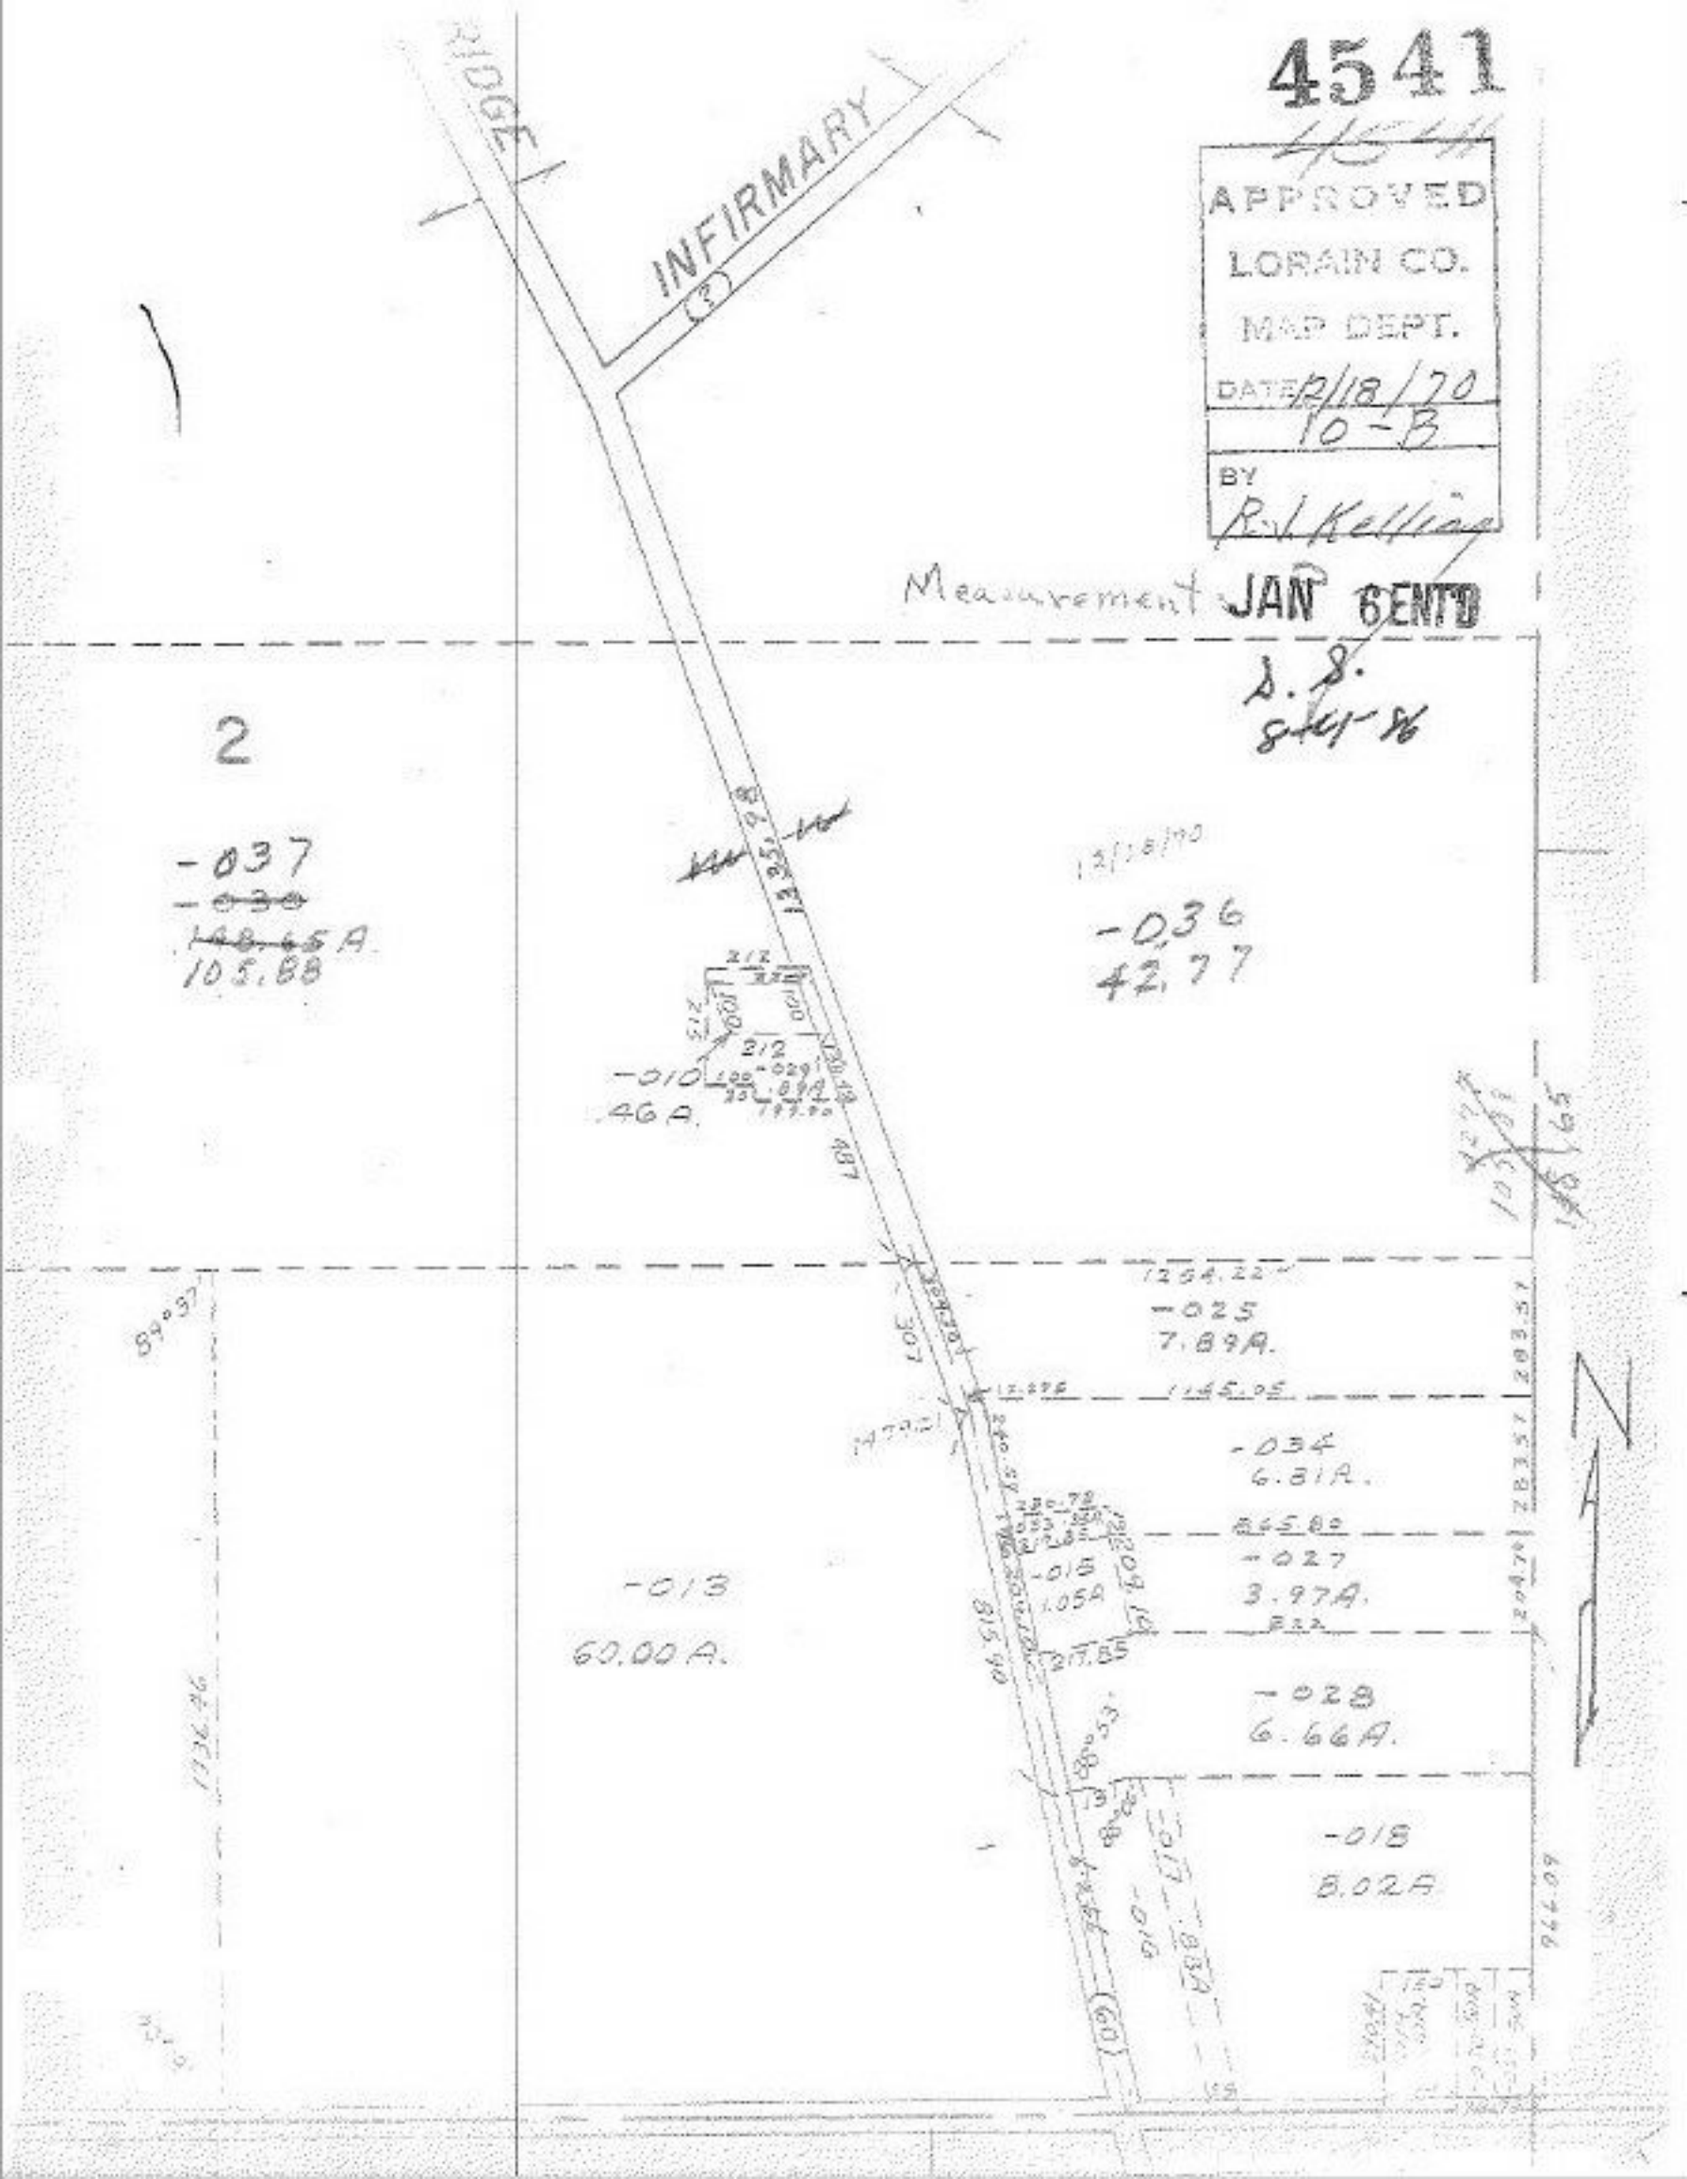
4541
APPROVED
LORAIN CO.
MAP DEPT.
DATE 12/18/70
10-B
BY
R. J. Kellian
JAN 6 ENTD
INFIRMARY
RIDGE
Measurement
S. S.
2
-037
105.68
12/18/70
-036
42.77
-010
.46 A.
-013
60.00 A.
-025
7.89A.
-034
6.81A.
-027
3.97A.
-028
6.66A.
-015
8.02A.
-015
1.05A
89°37'
1134.46
1264.22
1145.05
283.57
845.80
204.71
815.90
217.85
88°53'
497
1279.21
1235.98
60.776