


#A548

7-00-016B

SEE 7-00-016-A

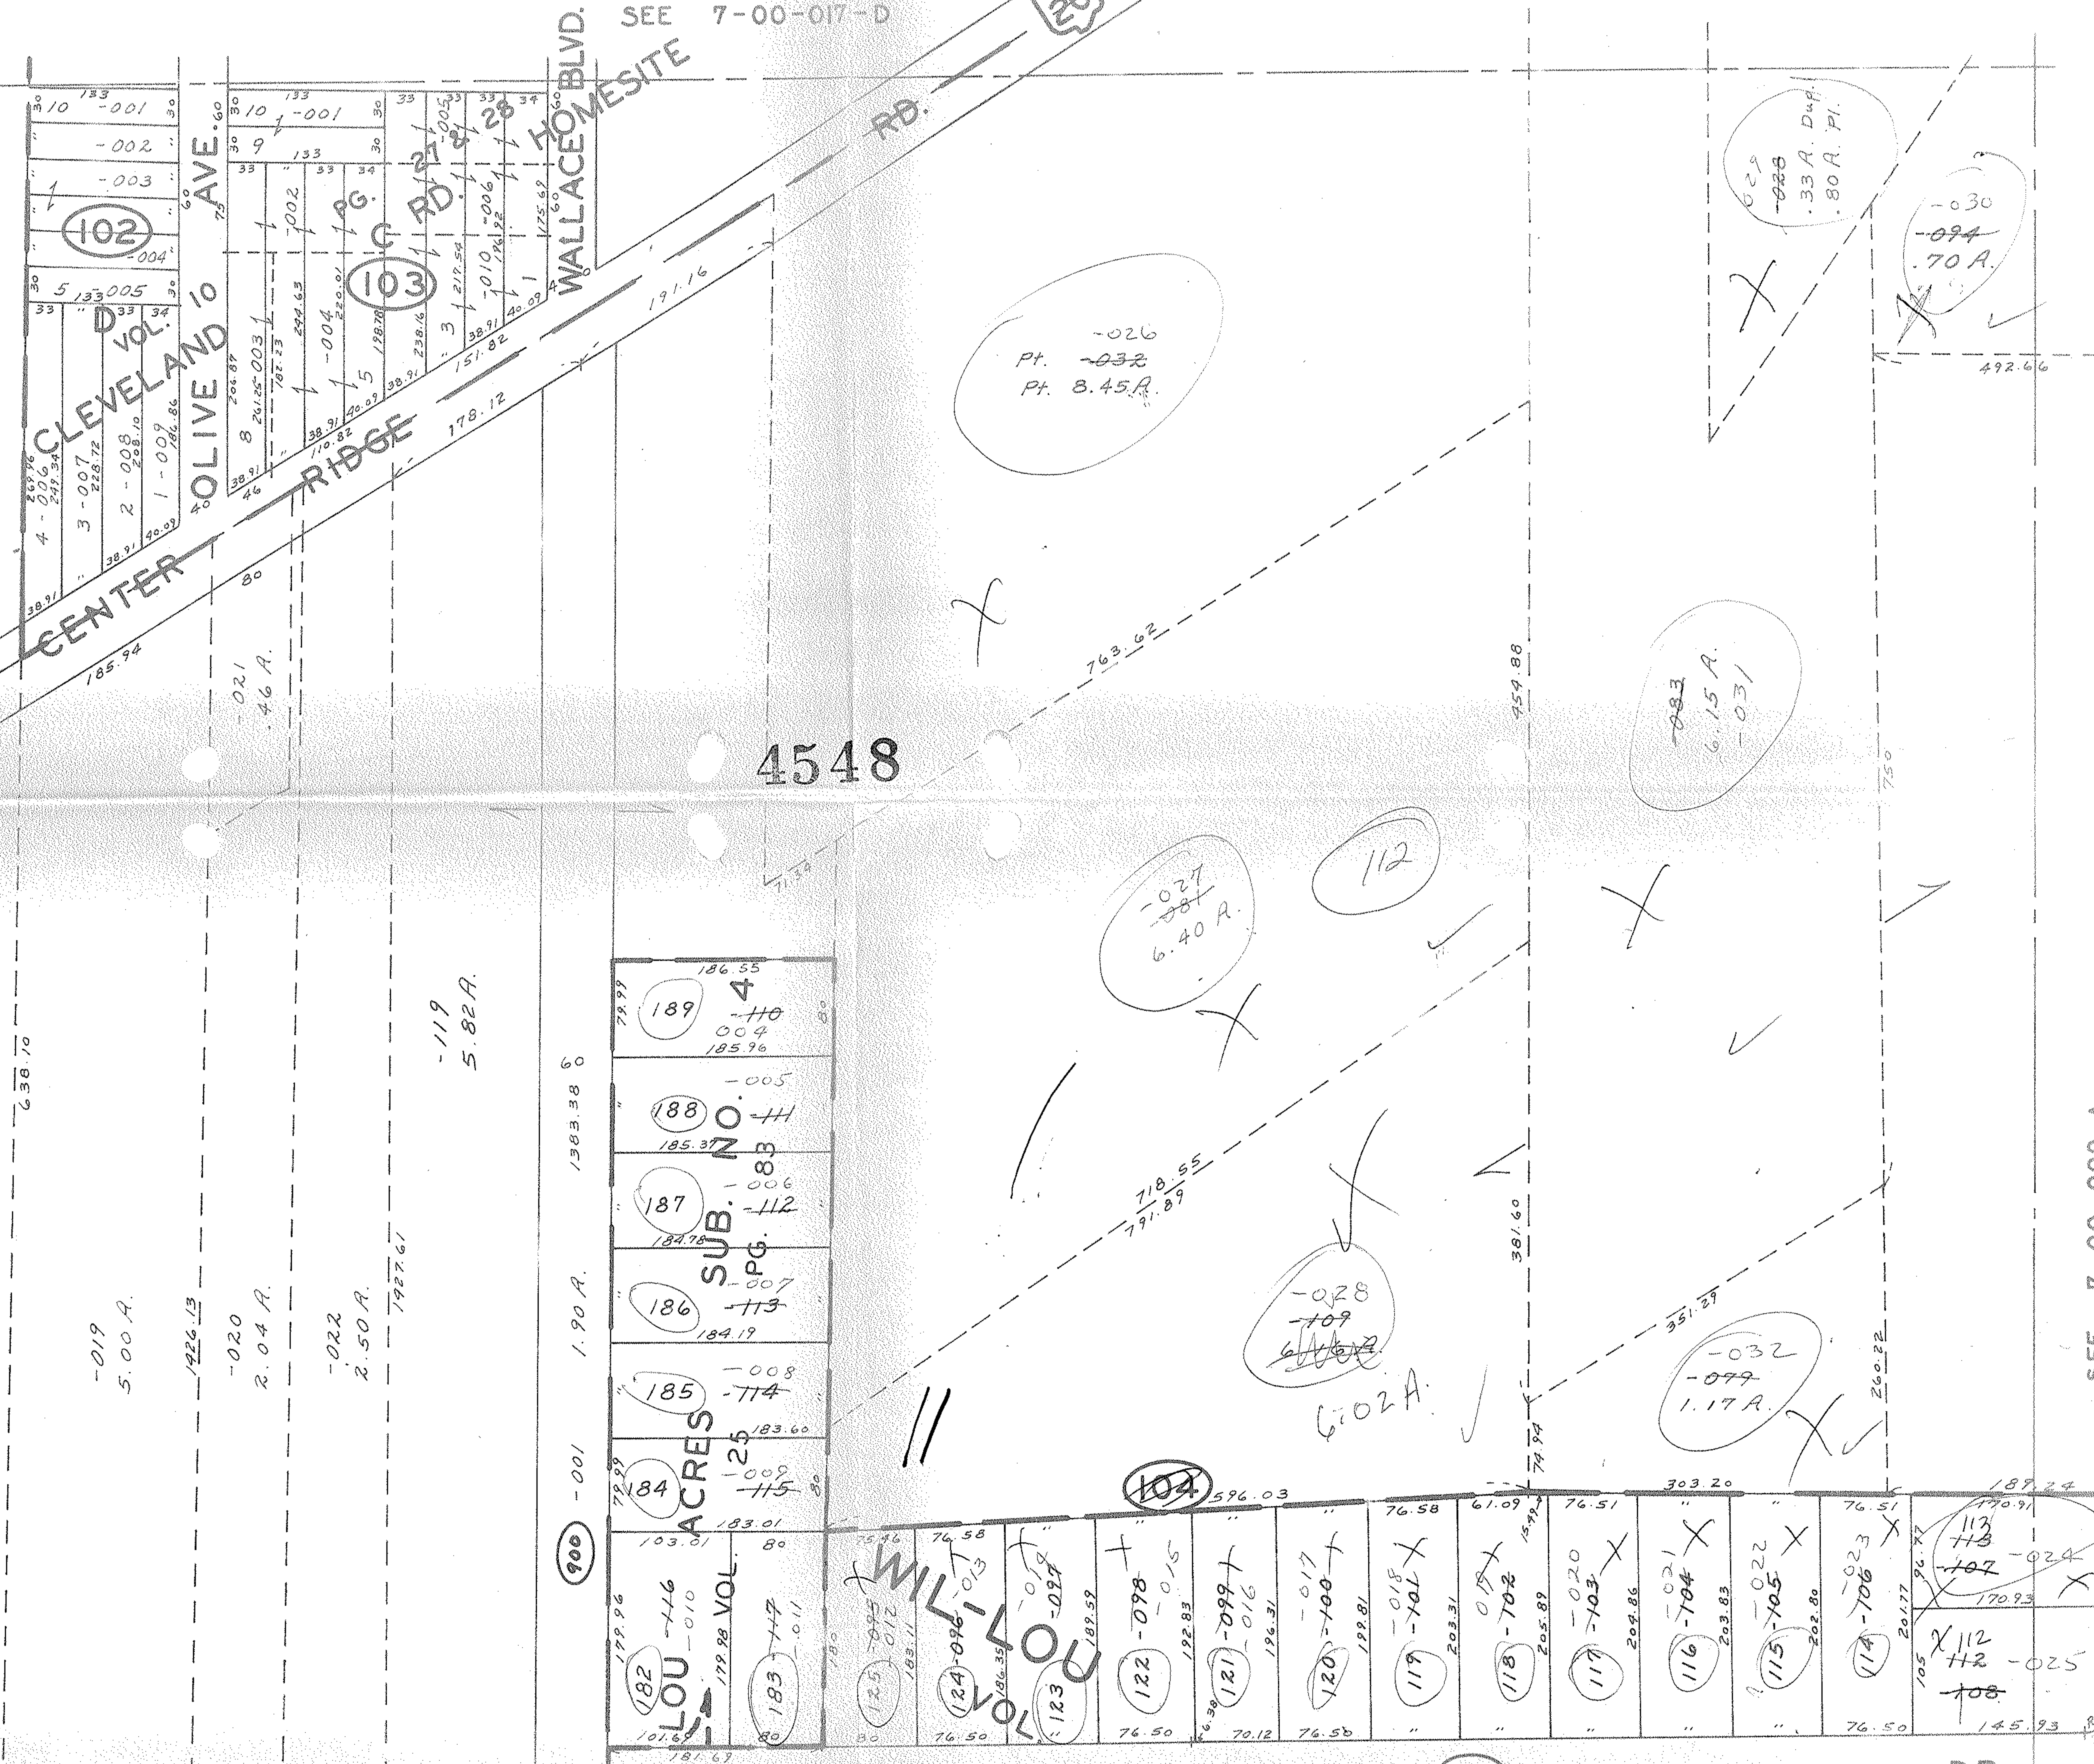

4548

SEE 7-00-009-A

