APPROVED
ORAIN CO.
MAP DEPT.
DATE 12/22/70
7-00-038-B
BY
JR.V. Hellwig

4552

4552
AE 2
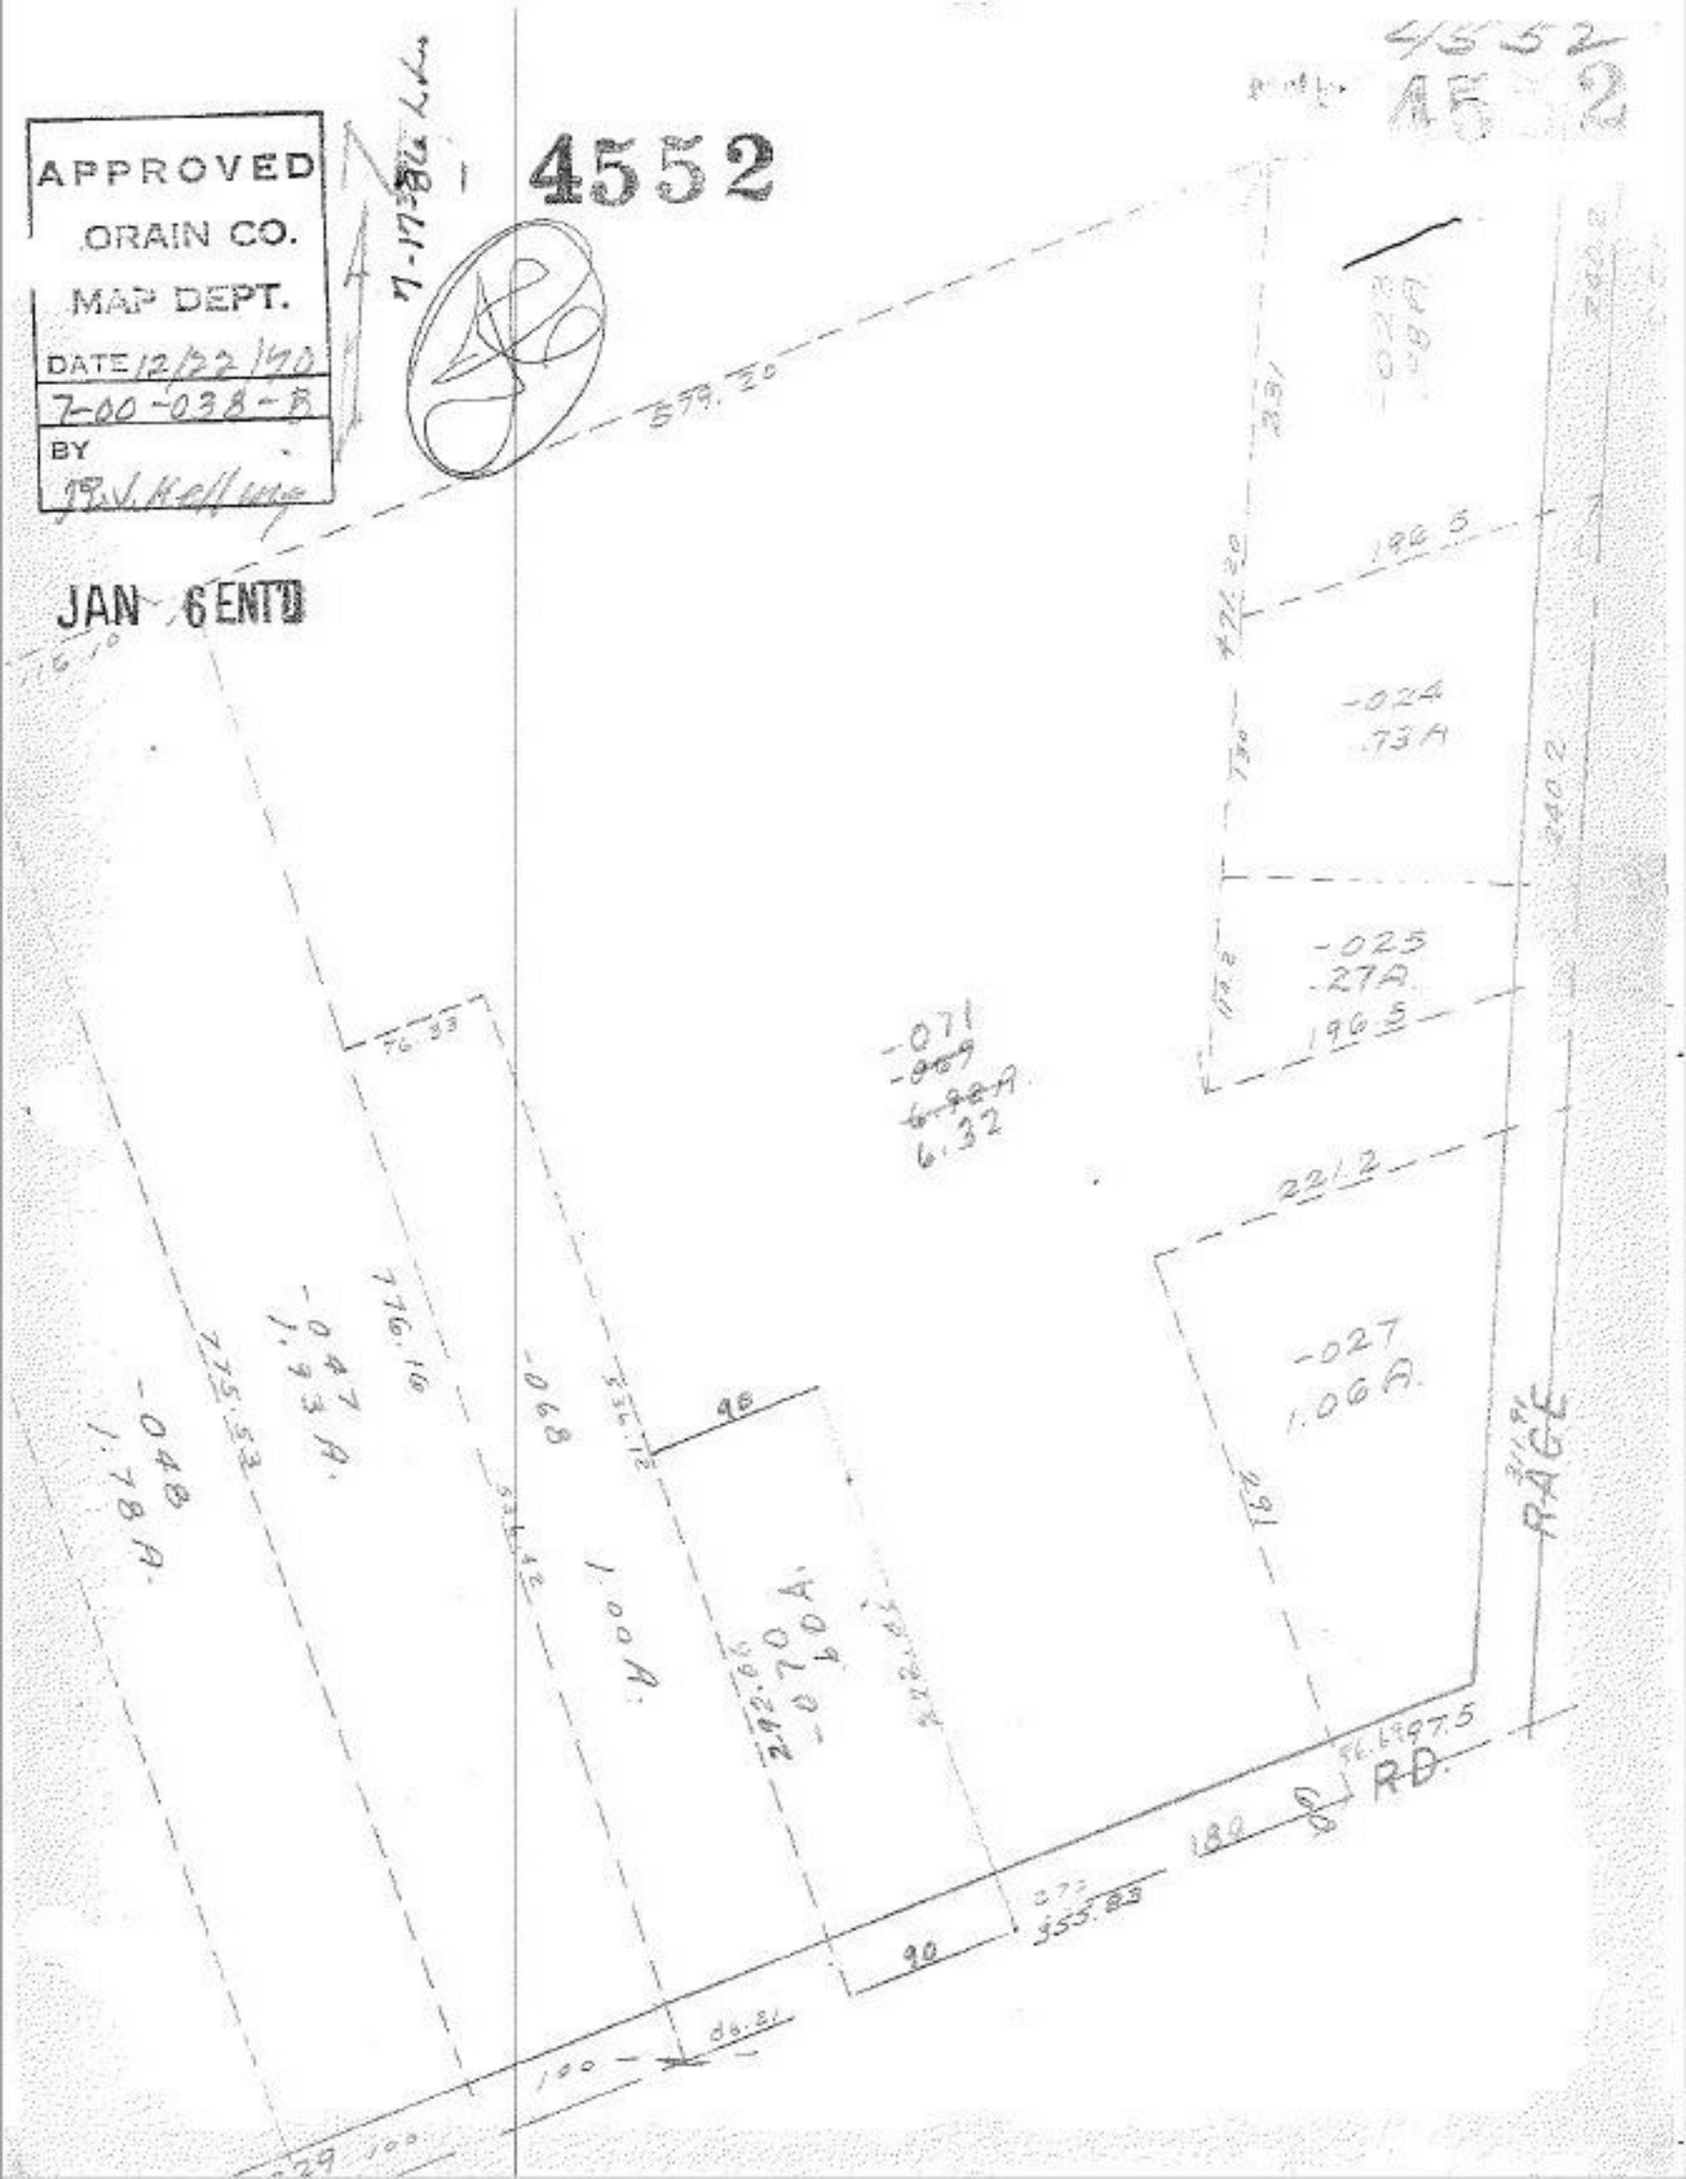
JAN 6 ENT'D