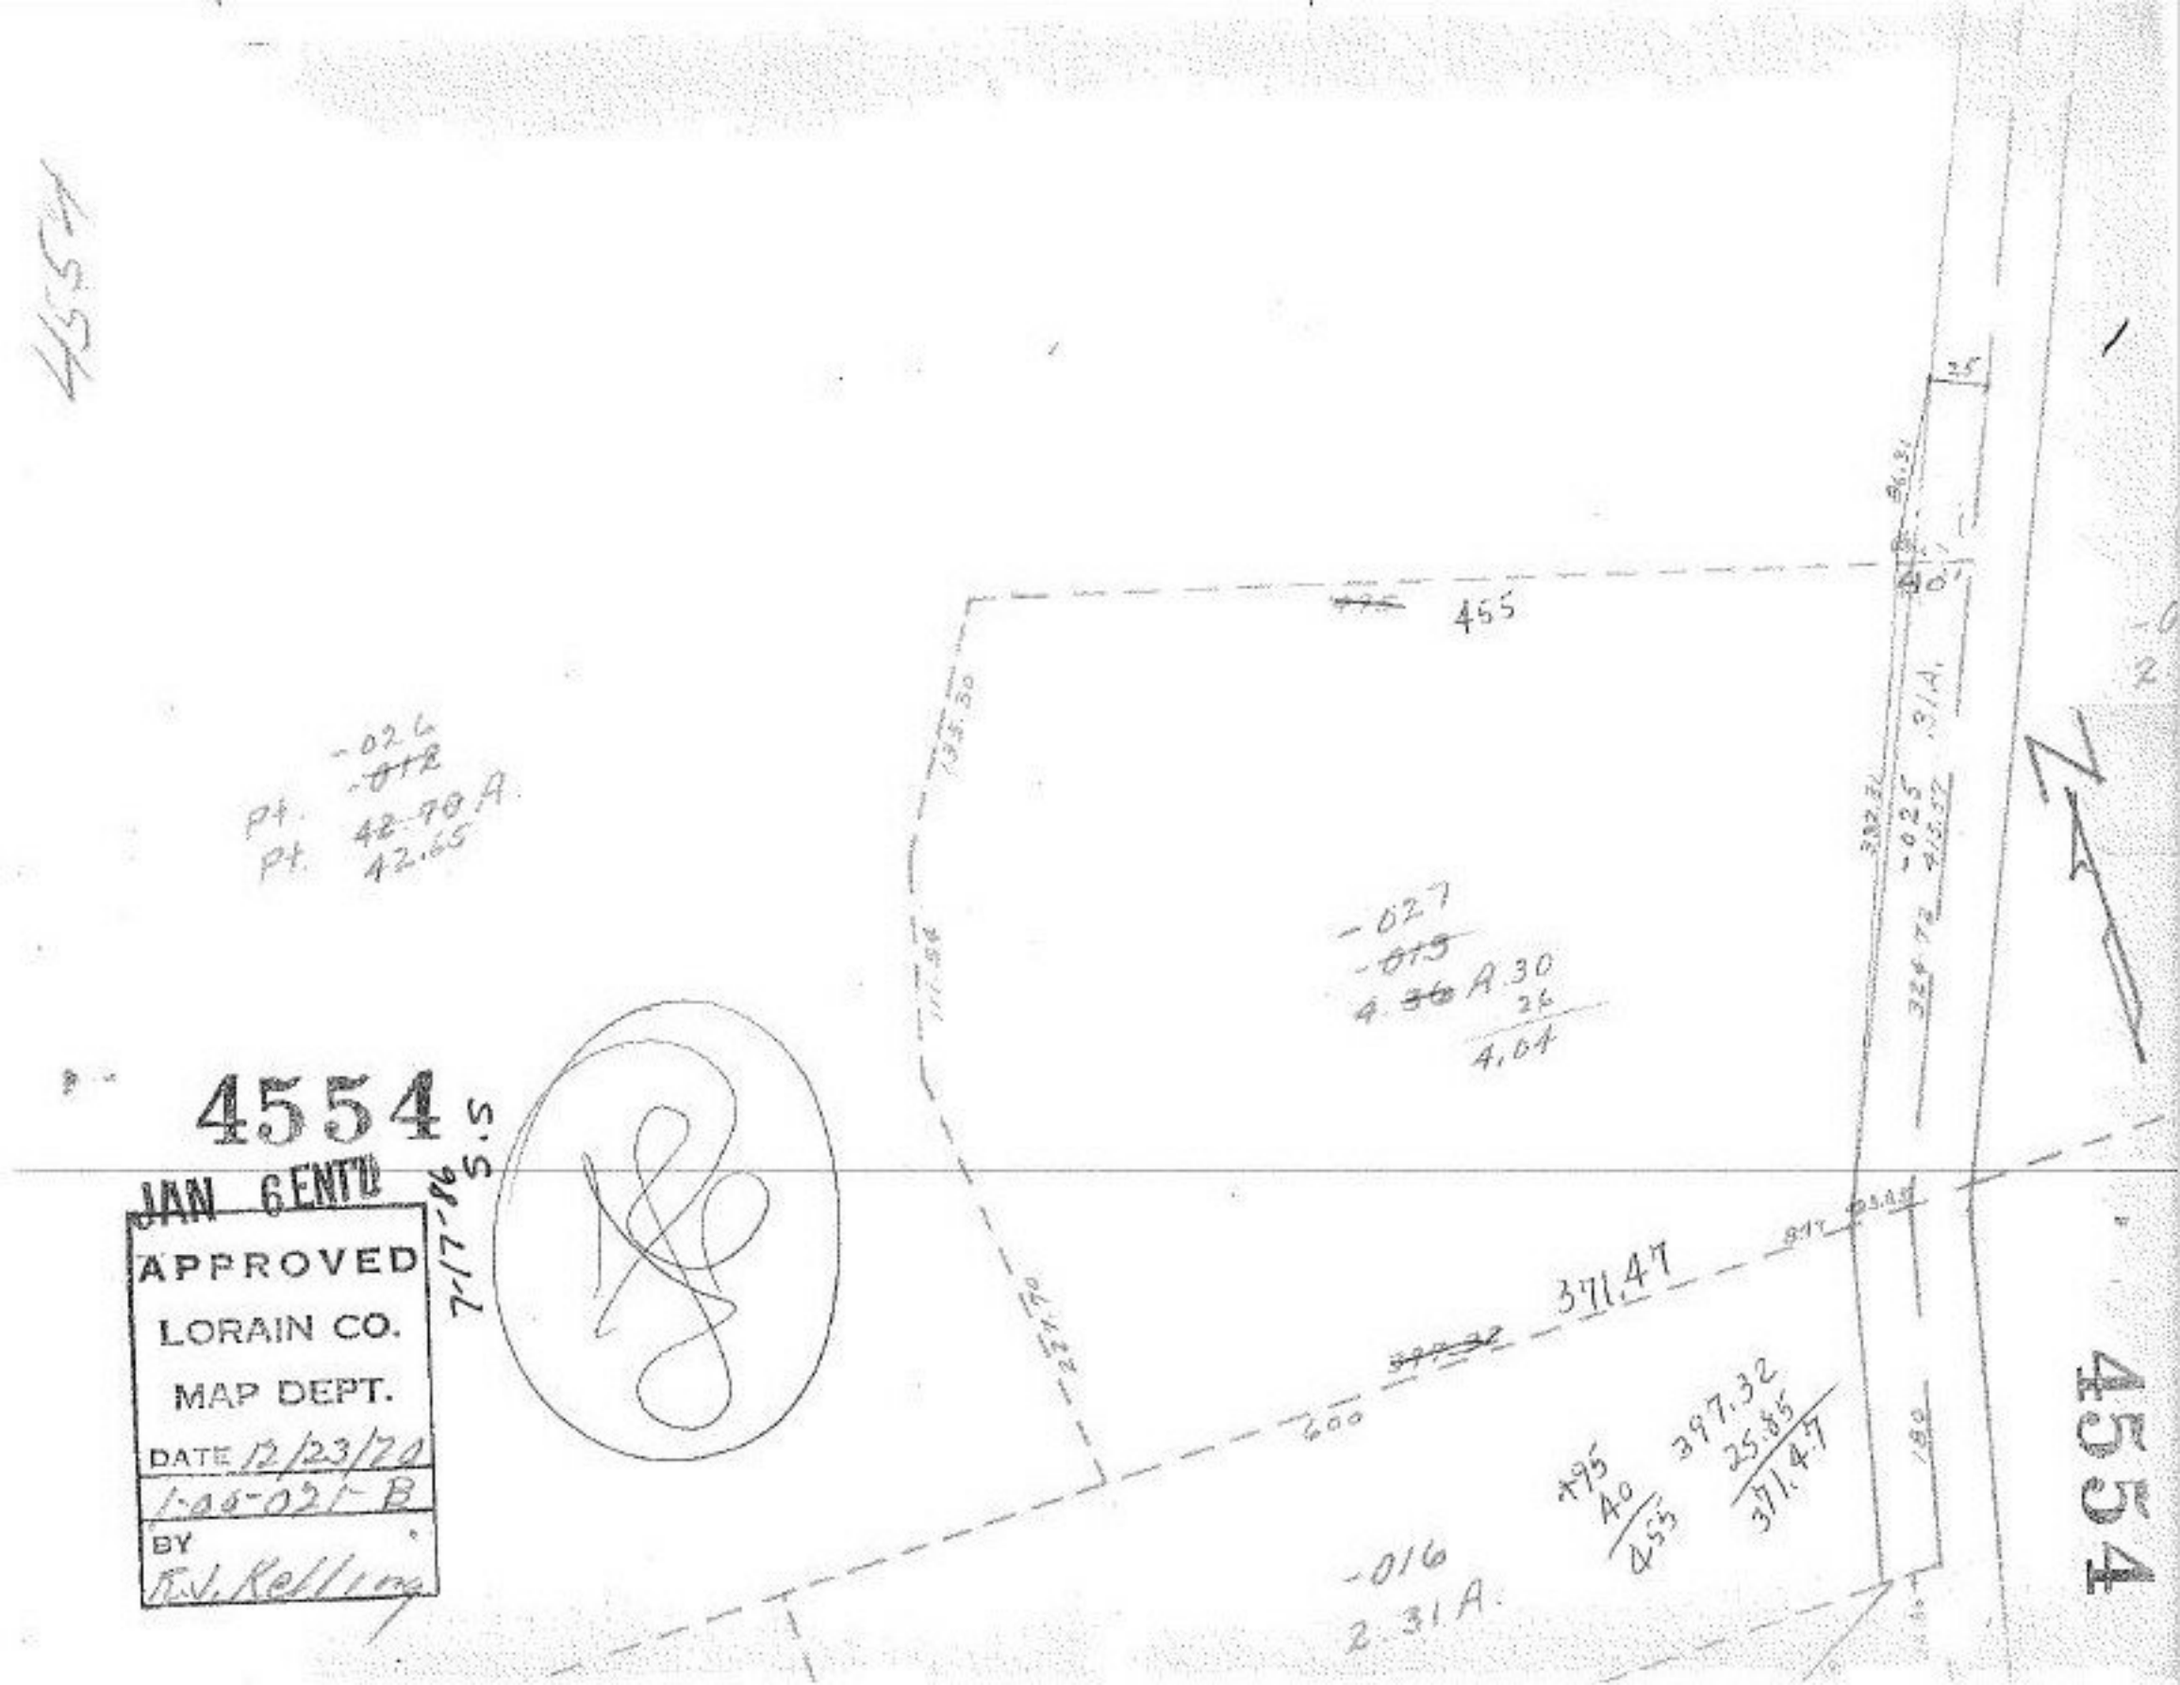
4554
455
-026
-012
Pt. 42.70 A.
Pt. 42.65
-027
-015
4.30 A.30
26
4.04
4554
JAN 6 ENTD
APPROVED
LORAIN CO.
MAP DEPT.
DATE 12/23/70
1-26-021-B
BY
R.V. Kelling
7-17-96 S.S.
371.47
397.32
25.85
371.47
-016
2.31 A.
4554