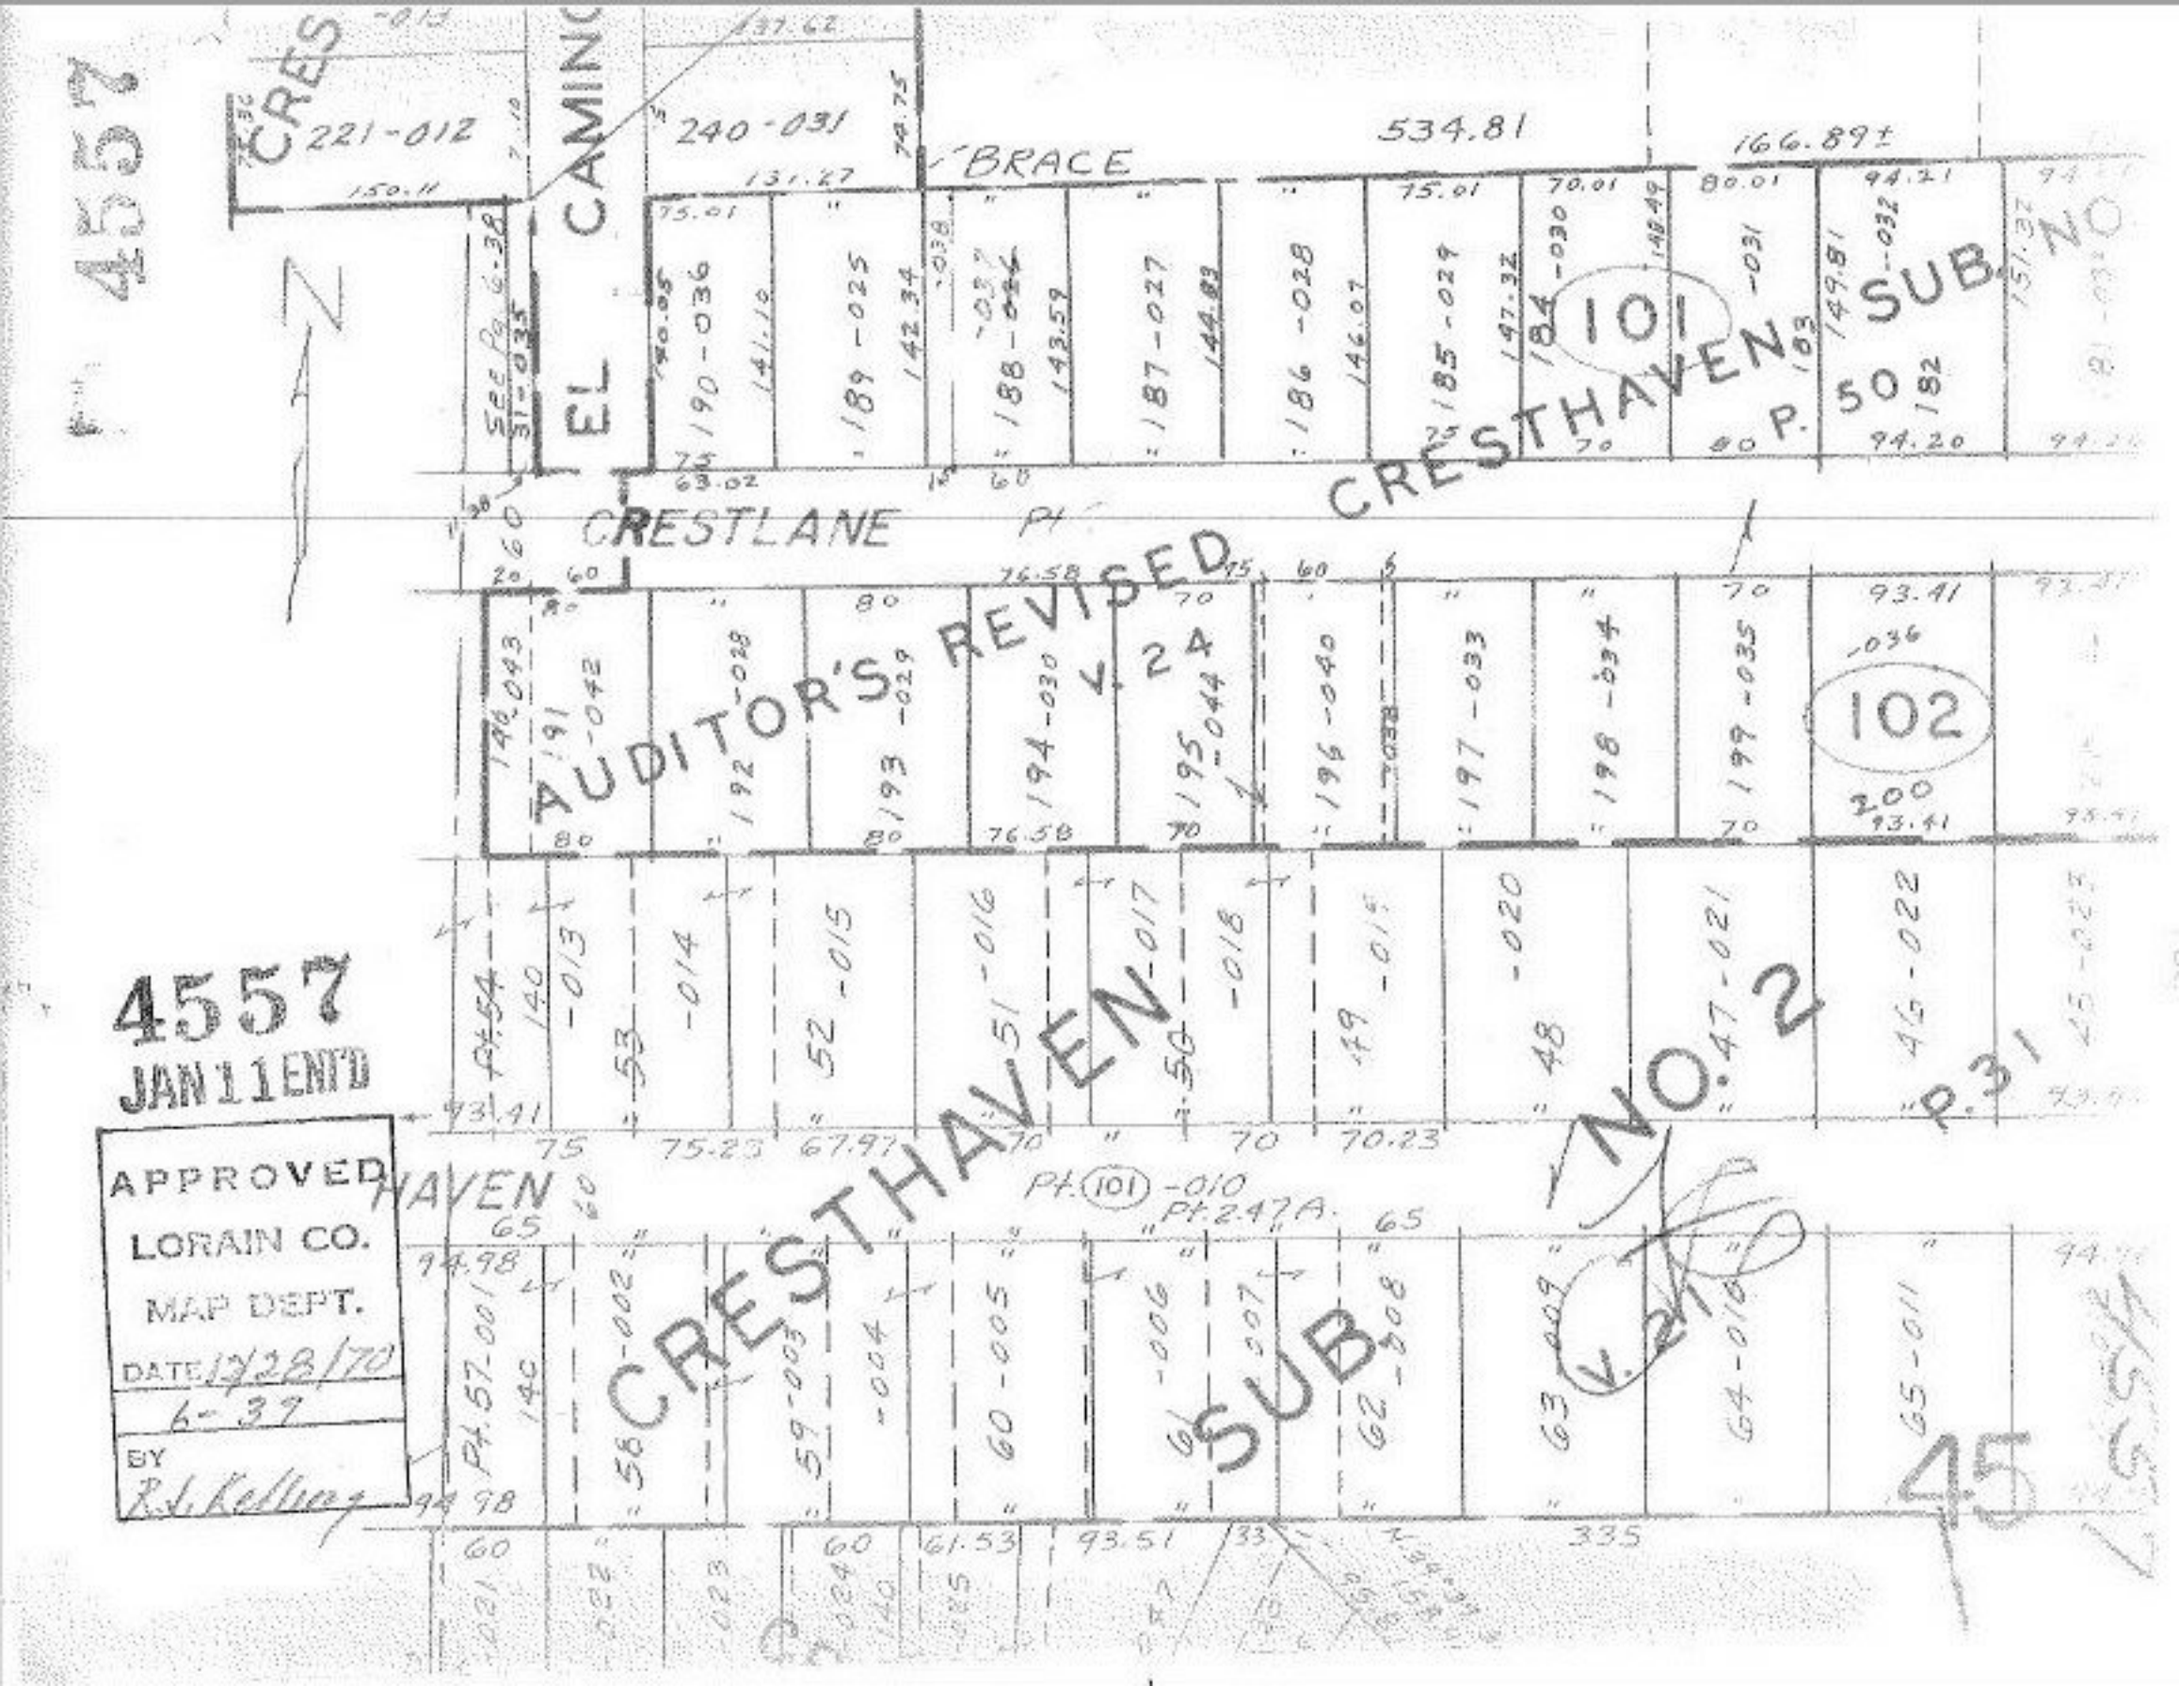
4557
CRES
221-012
240-031
EL CAMINO
BRACE
534.81
166.89±
CRESTHAVEN
NO. 10
SUB
P. 50 182
CRESTLANE PL
AUDITOR'S REVISED
4 24
102
P. 31
CRESTHAVEN
NO. 2
SUB
4557
JAN 11 END
APPROVED
LORAIN CO.
MAP DEPT.
DATE 1/28/70
6-37
BY
R. L. Kelley