4558

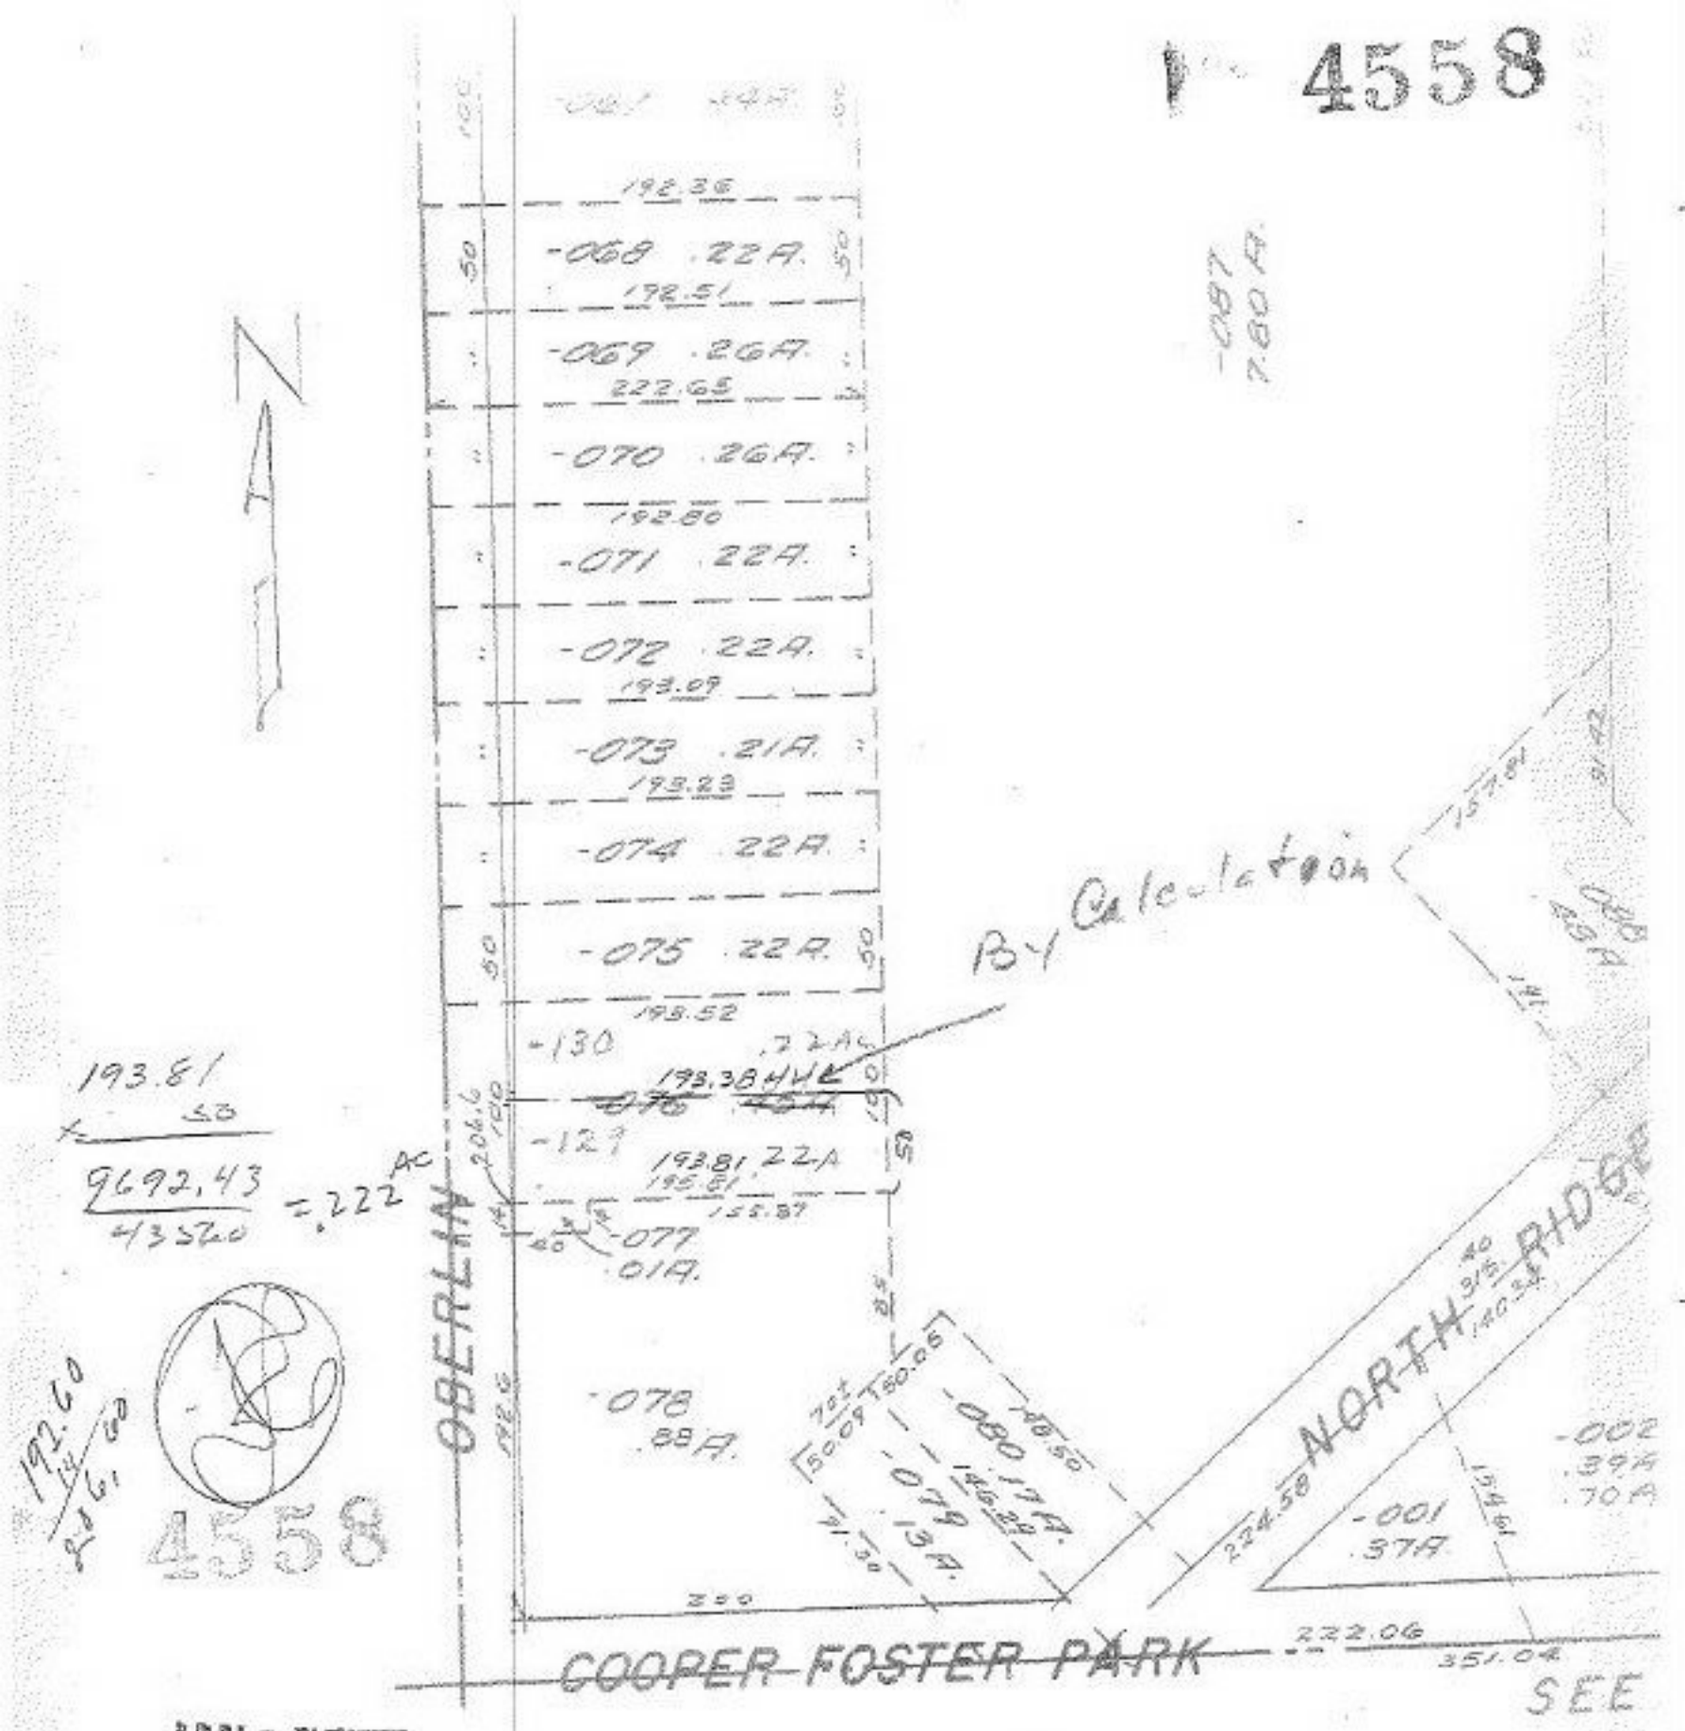

JAN 27 ENT'D

7-17-86
S.S

BLACK RIVER TWP.

SCALE: 1" = 100'