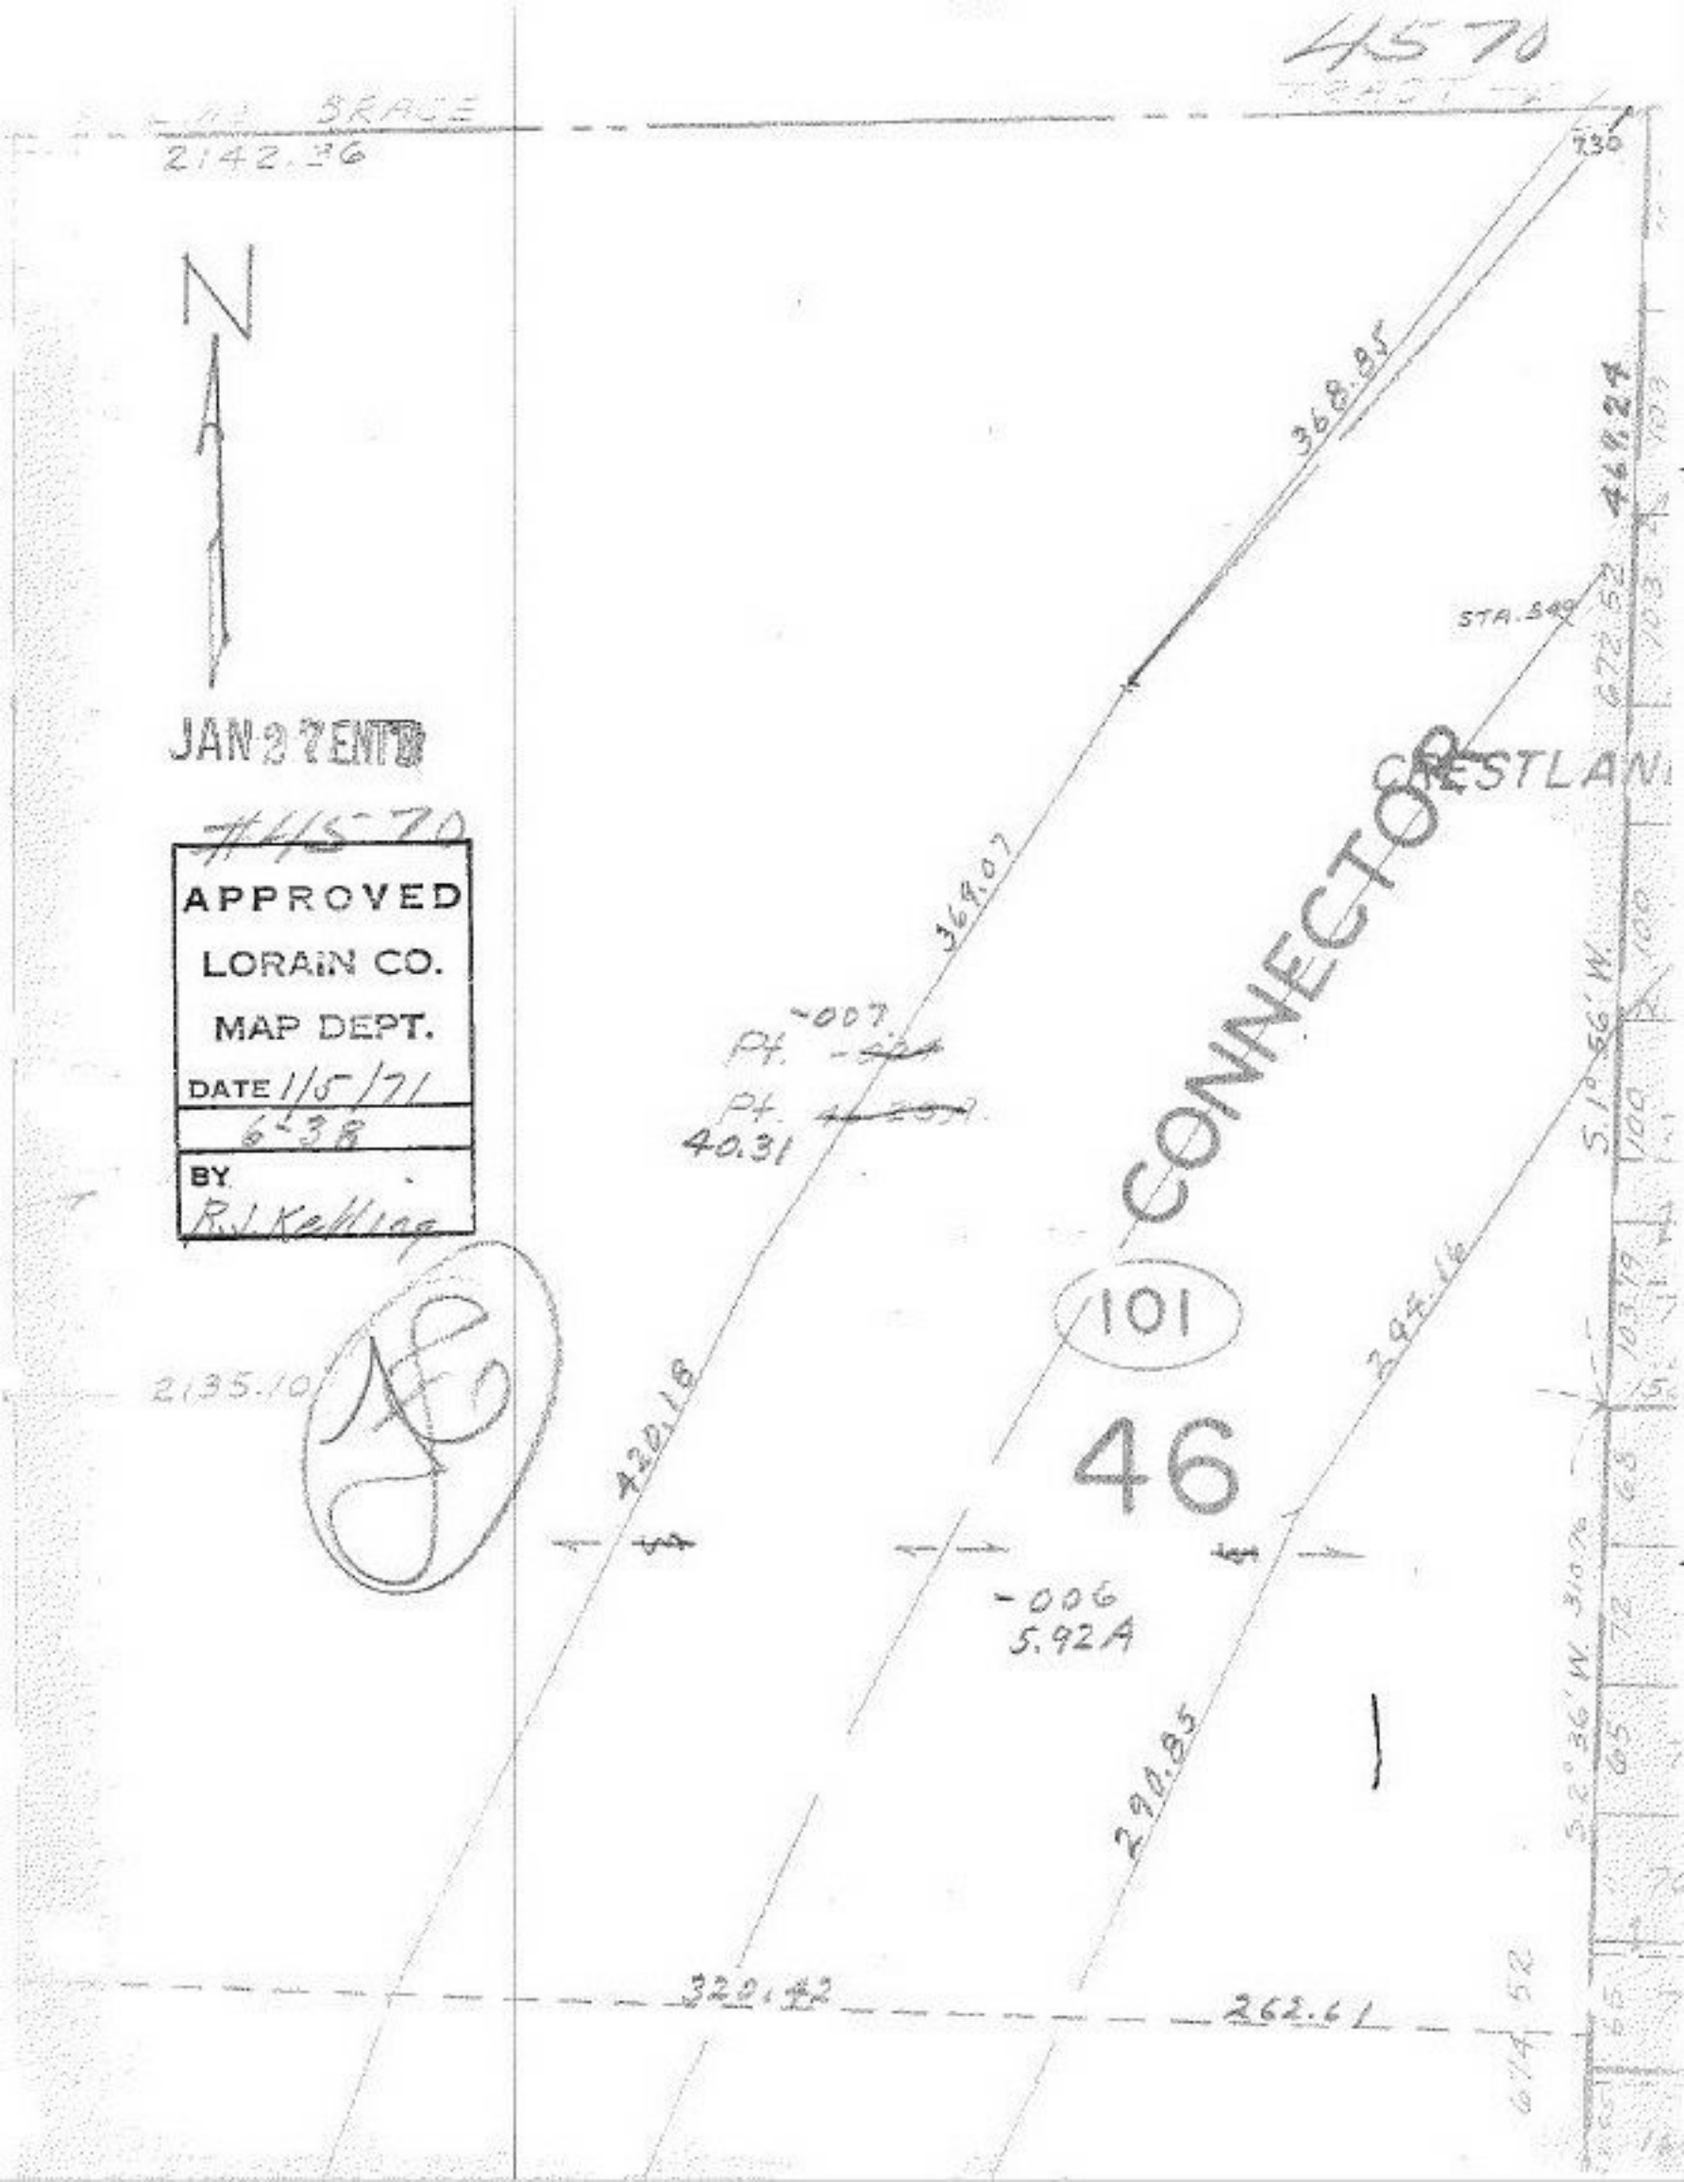
4570
BRACE
2142.36
N
JAN 27 ENTD
#4570
APPROVED
LORAIN CO.
MAP DEPT.
DATE 1/5/71
6-38
BY
R.J. Kelling
368.85
369.07
STA. 549
CRESTLAN
CONNECTOR
-007
Pt.
Pt.
40.31
101
46
2135.10
420.18
294.16
-006
5.92A
290.85
320.42
262.61
S.1° 56' W.
S.2° 36' W.
469.24
672.52
674.52