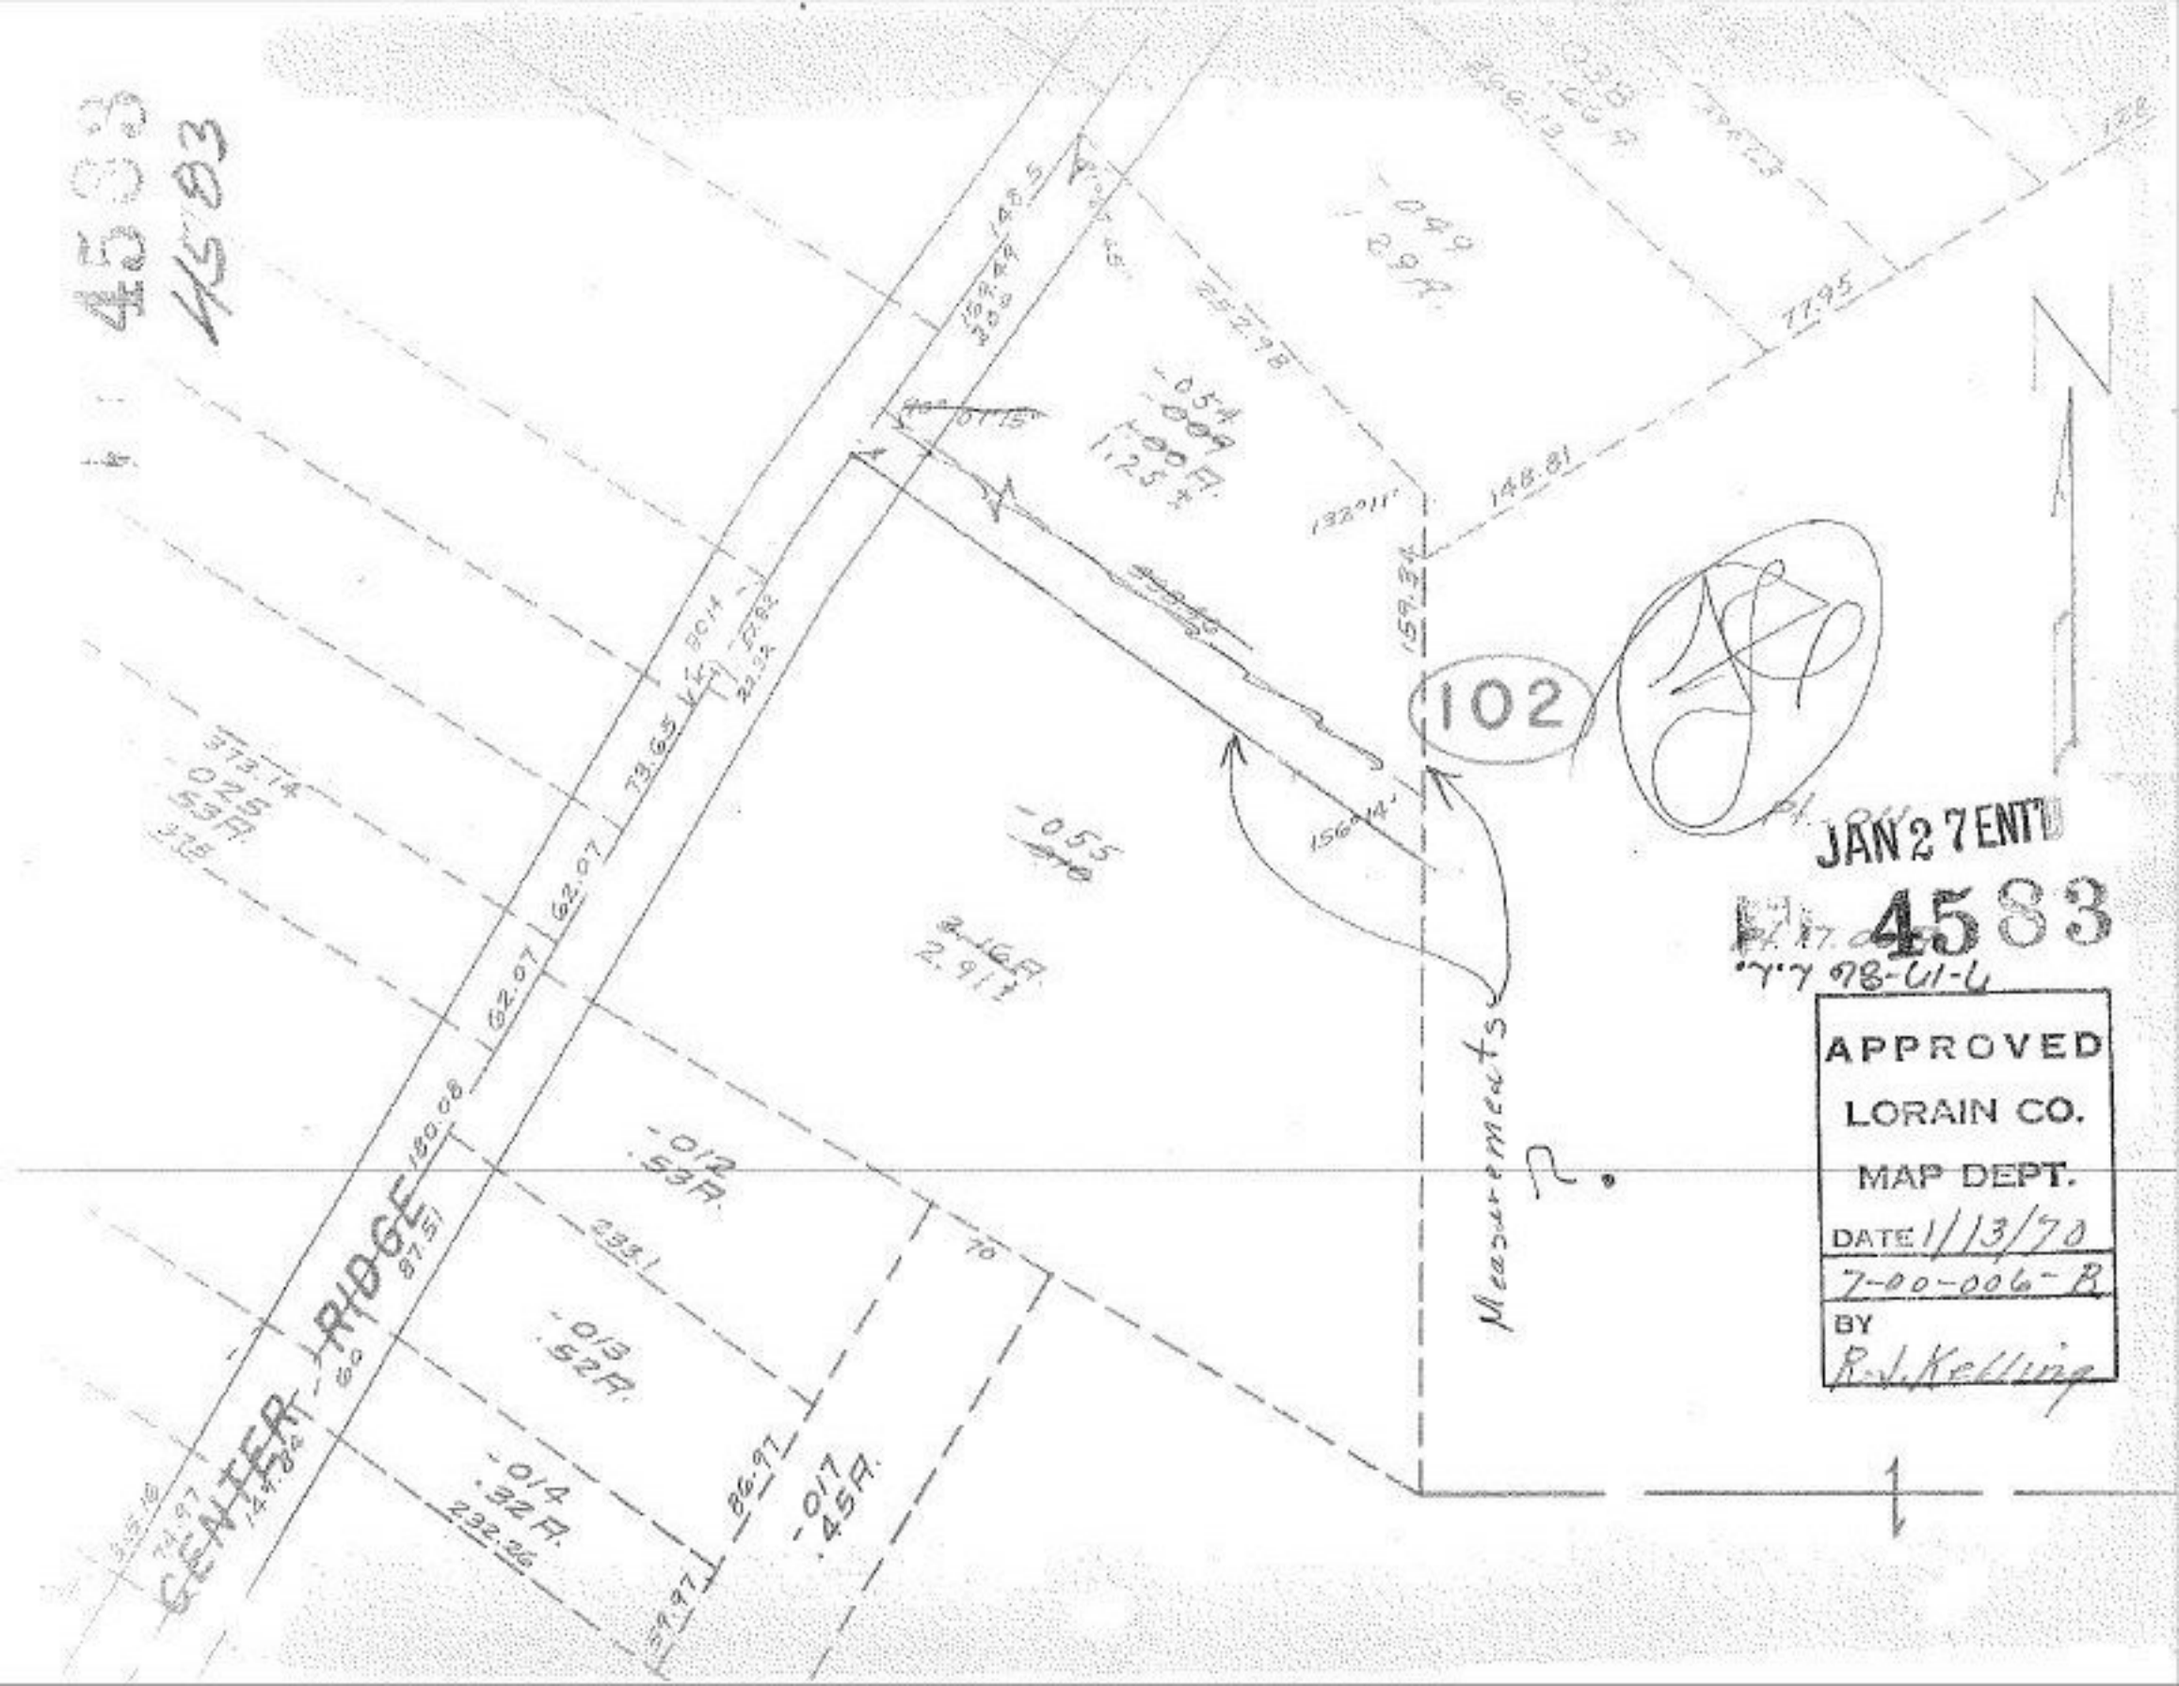
4583
W.S. 83
CENTER RIDGE
102
Measurements
JAN 27 ENT'D
4583
APPROVED
LORAIN CO.
MAP DEPT.
DATE 1/13/70
7-00-006-R
BY
R.J. Kelling