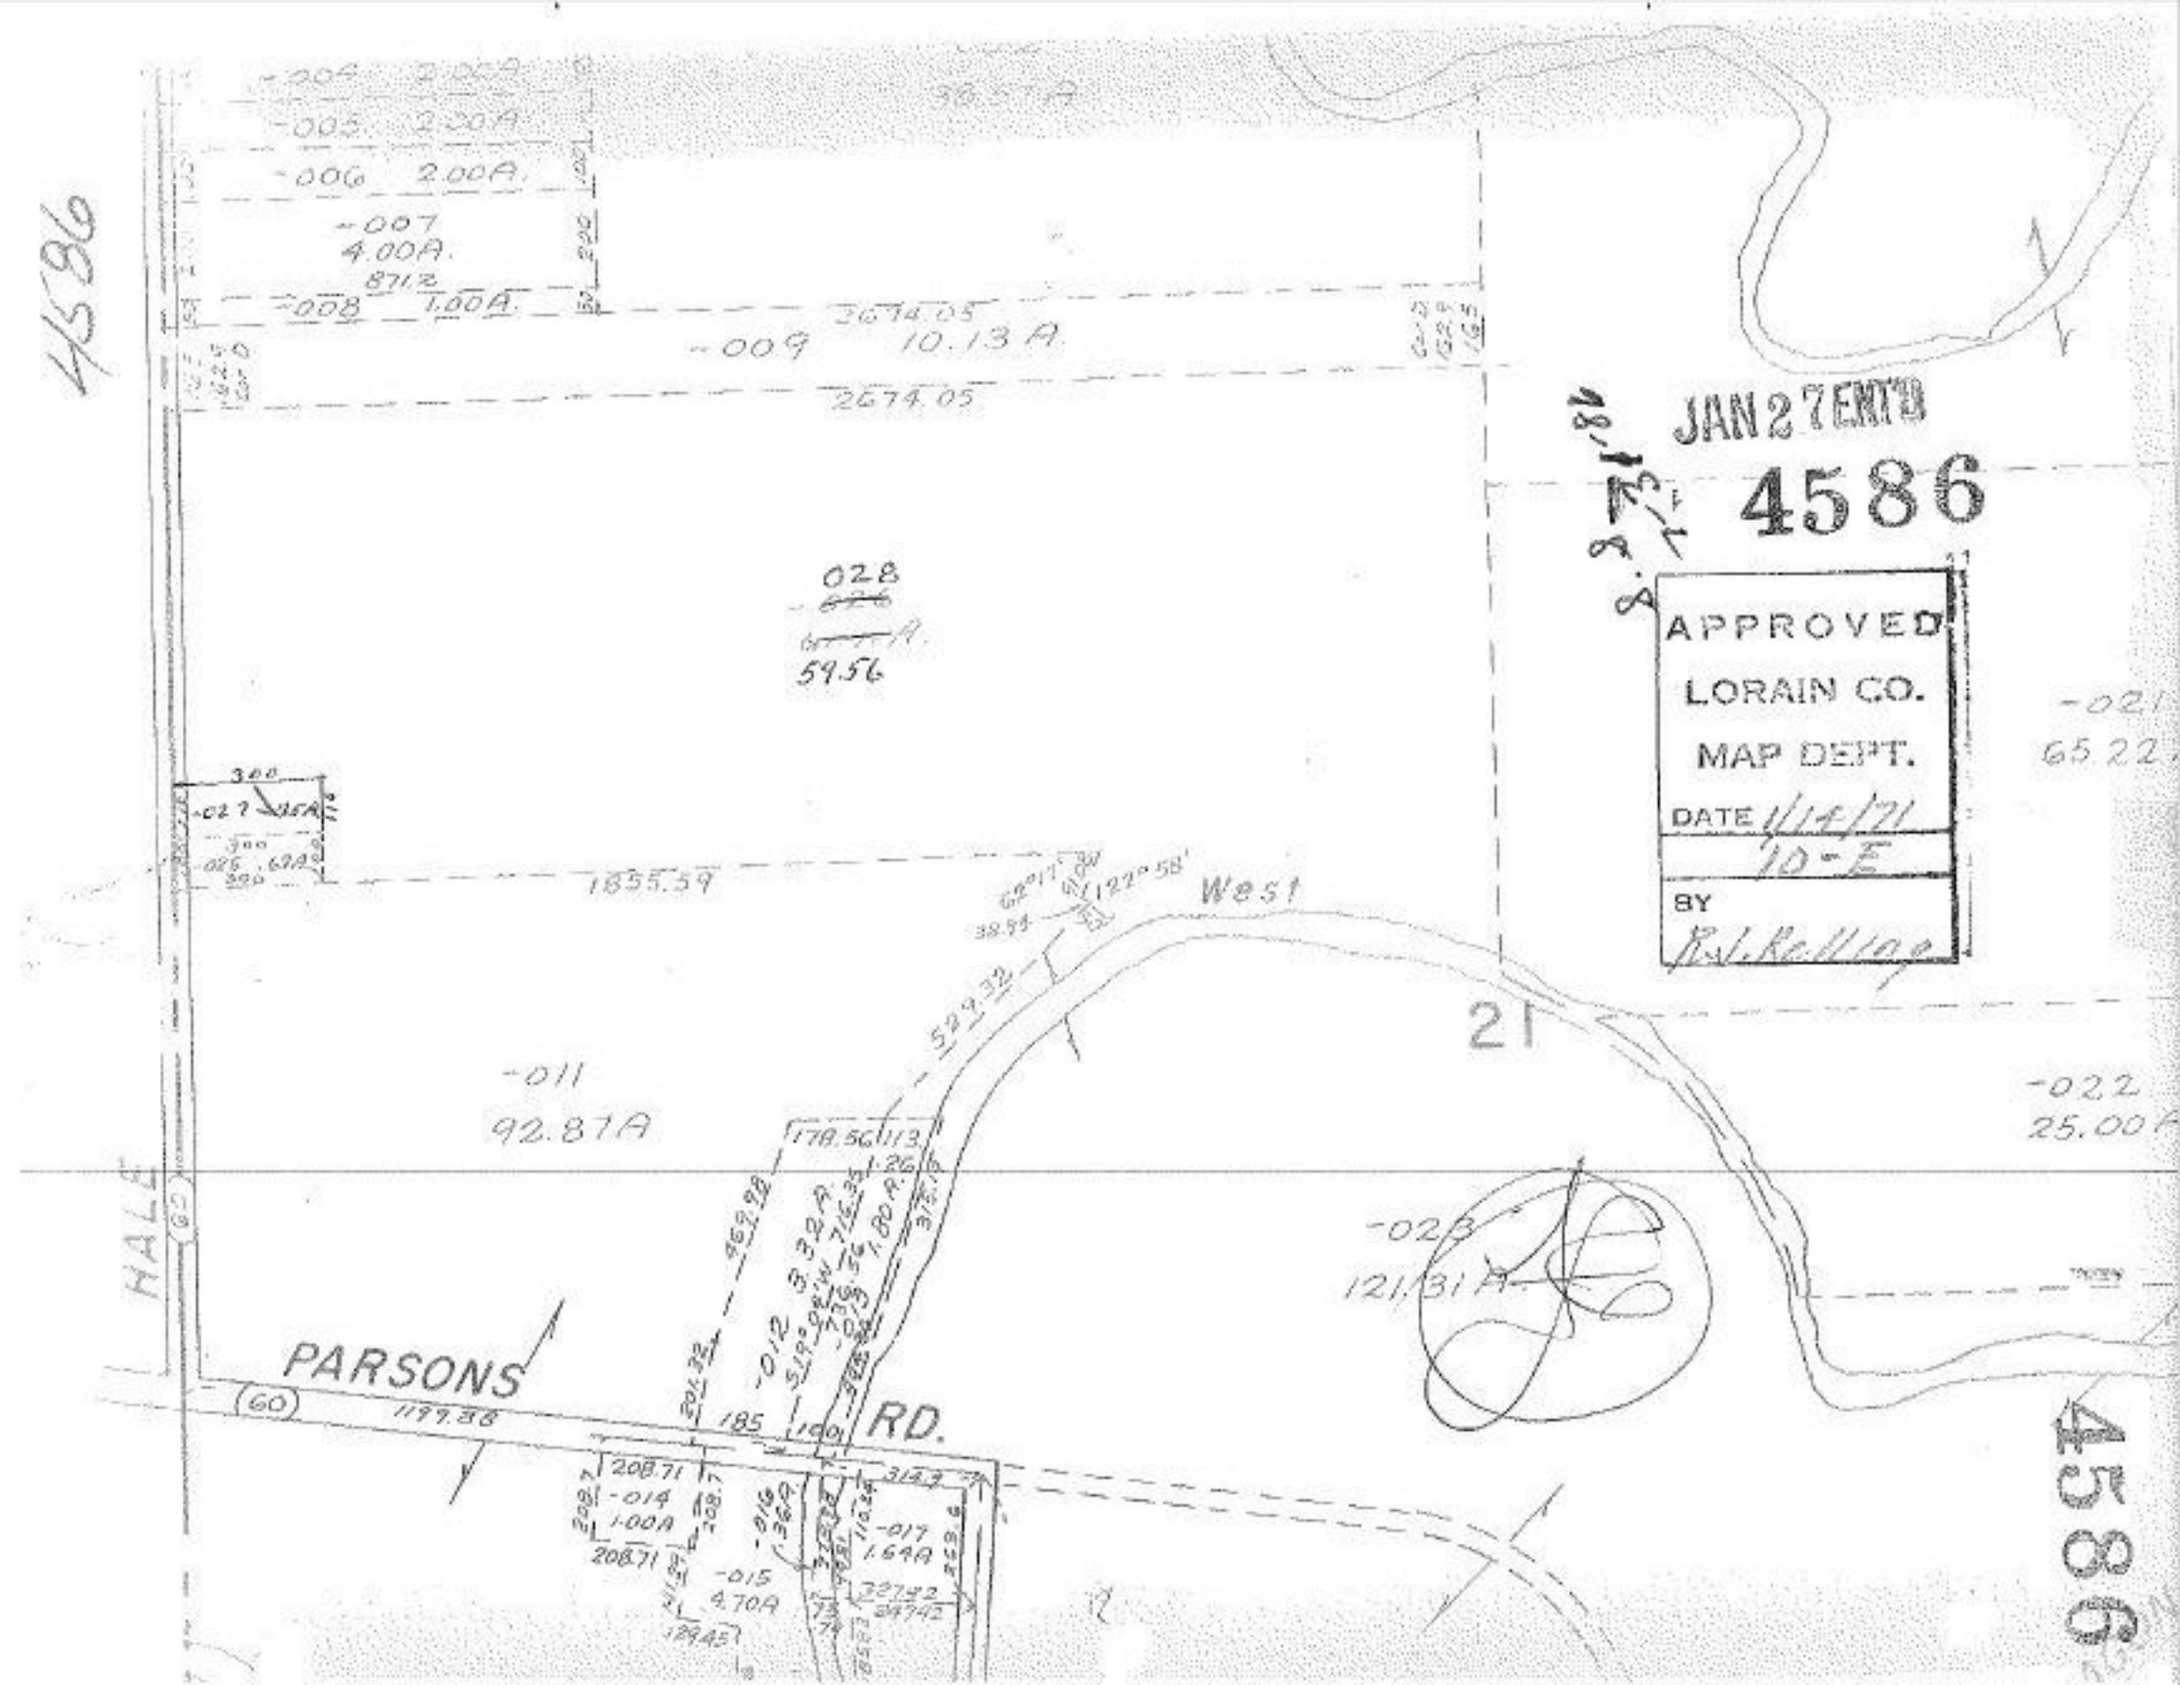

4586
JAN 27 ENT'D
4586
APPROVED
LORAIN CO.
MAP DEPT.
DATE 1/14/71
10-E
BY
-004 2.00A
-005 2.00A
-006 2.00A
-007
4.00A
871.2
-008 1.00A
2674.05
-009 10.13 A
2674.05
028
59.56
1855.59
West
21
-011
92.87A
-022
25.00A
-023
121.31A
-021
65.22
HALE
PARSONS
RD.
1199.38
-014
1.00A
-015
4.70A
-017
1.64A
4586