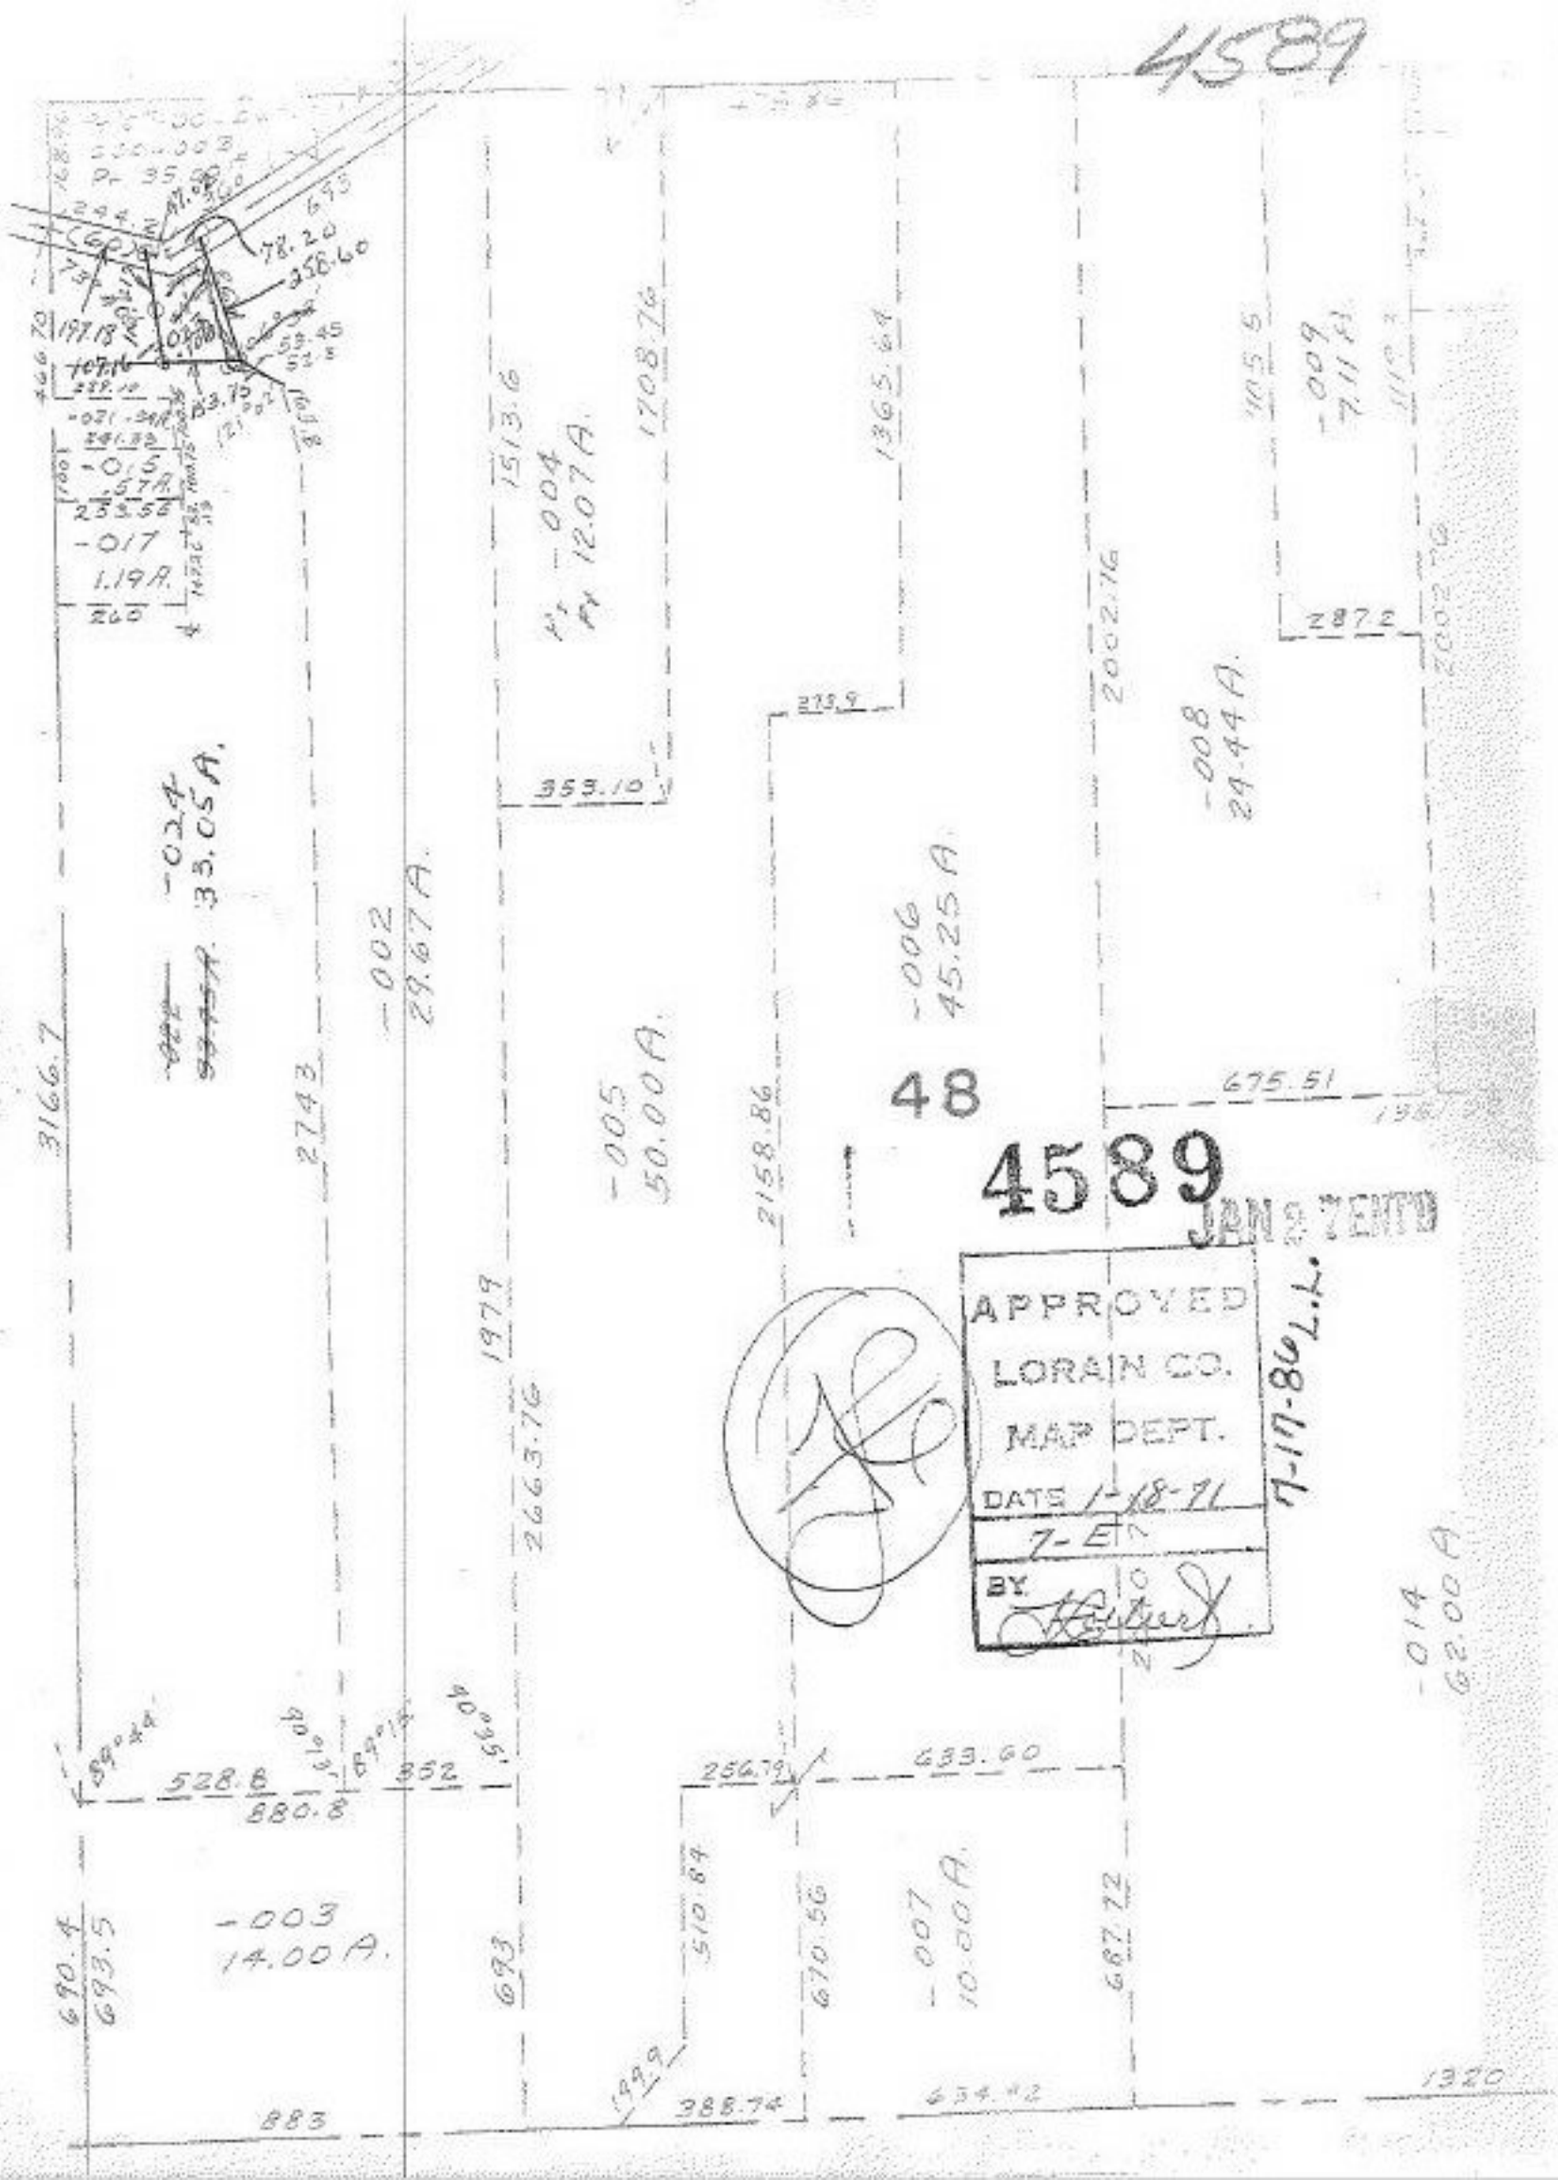
4589
48
4589
JAN 27 ENT'D
APPROVED
LORAIN CO.
MAP DEPT.
DATE 1-18-71
7-E
BY
7-17-86 L.L.
-004
12.07 A.
-005
50.00 A.
-006
45.25 A.
-007
10.00 A.
-008
24.44 A.
-009
7.11 A.
-014
62.00 A.
-002
29.67 A.
-003
14.00 A.
-024
33.05 A.
-017
1.19 A.
-015
.57 A.
3166.7
2743
1979
2663.76
1513.6
1708.76
1365.64
2002.76
2158.86
675.51
287.2
353.10
273.9
528.8
880.8
352
256.79
633.60
510.84
670.56
687.72
690.4
693.5
693
883
388.74
634.42
1320
78.20
358.60
197.18
107.16
53.45
53.75
-024
-017
1.19 A.
260