4594
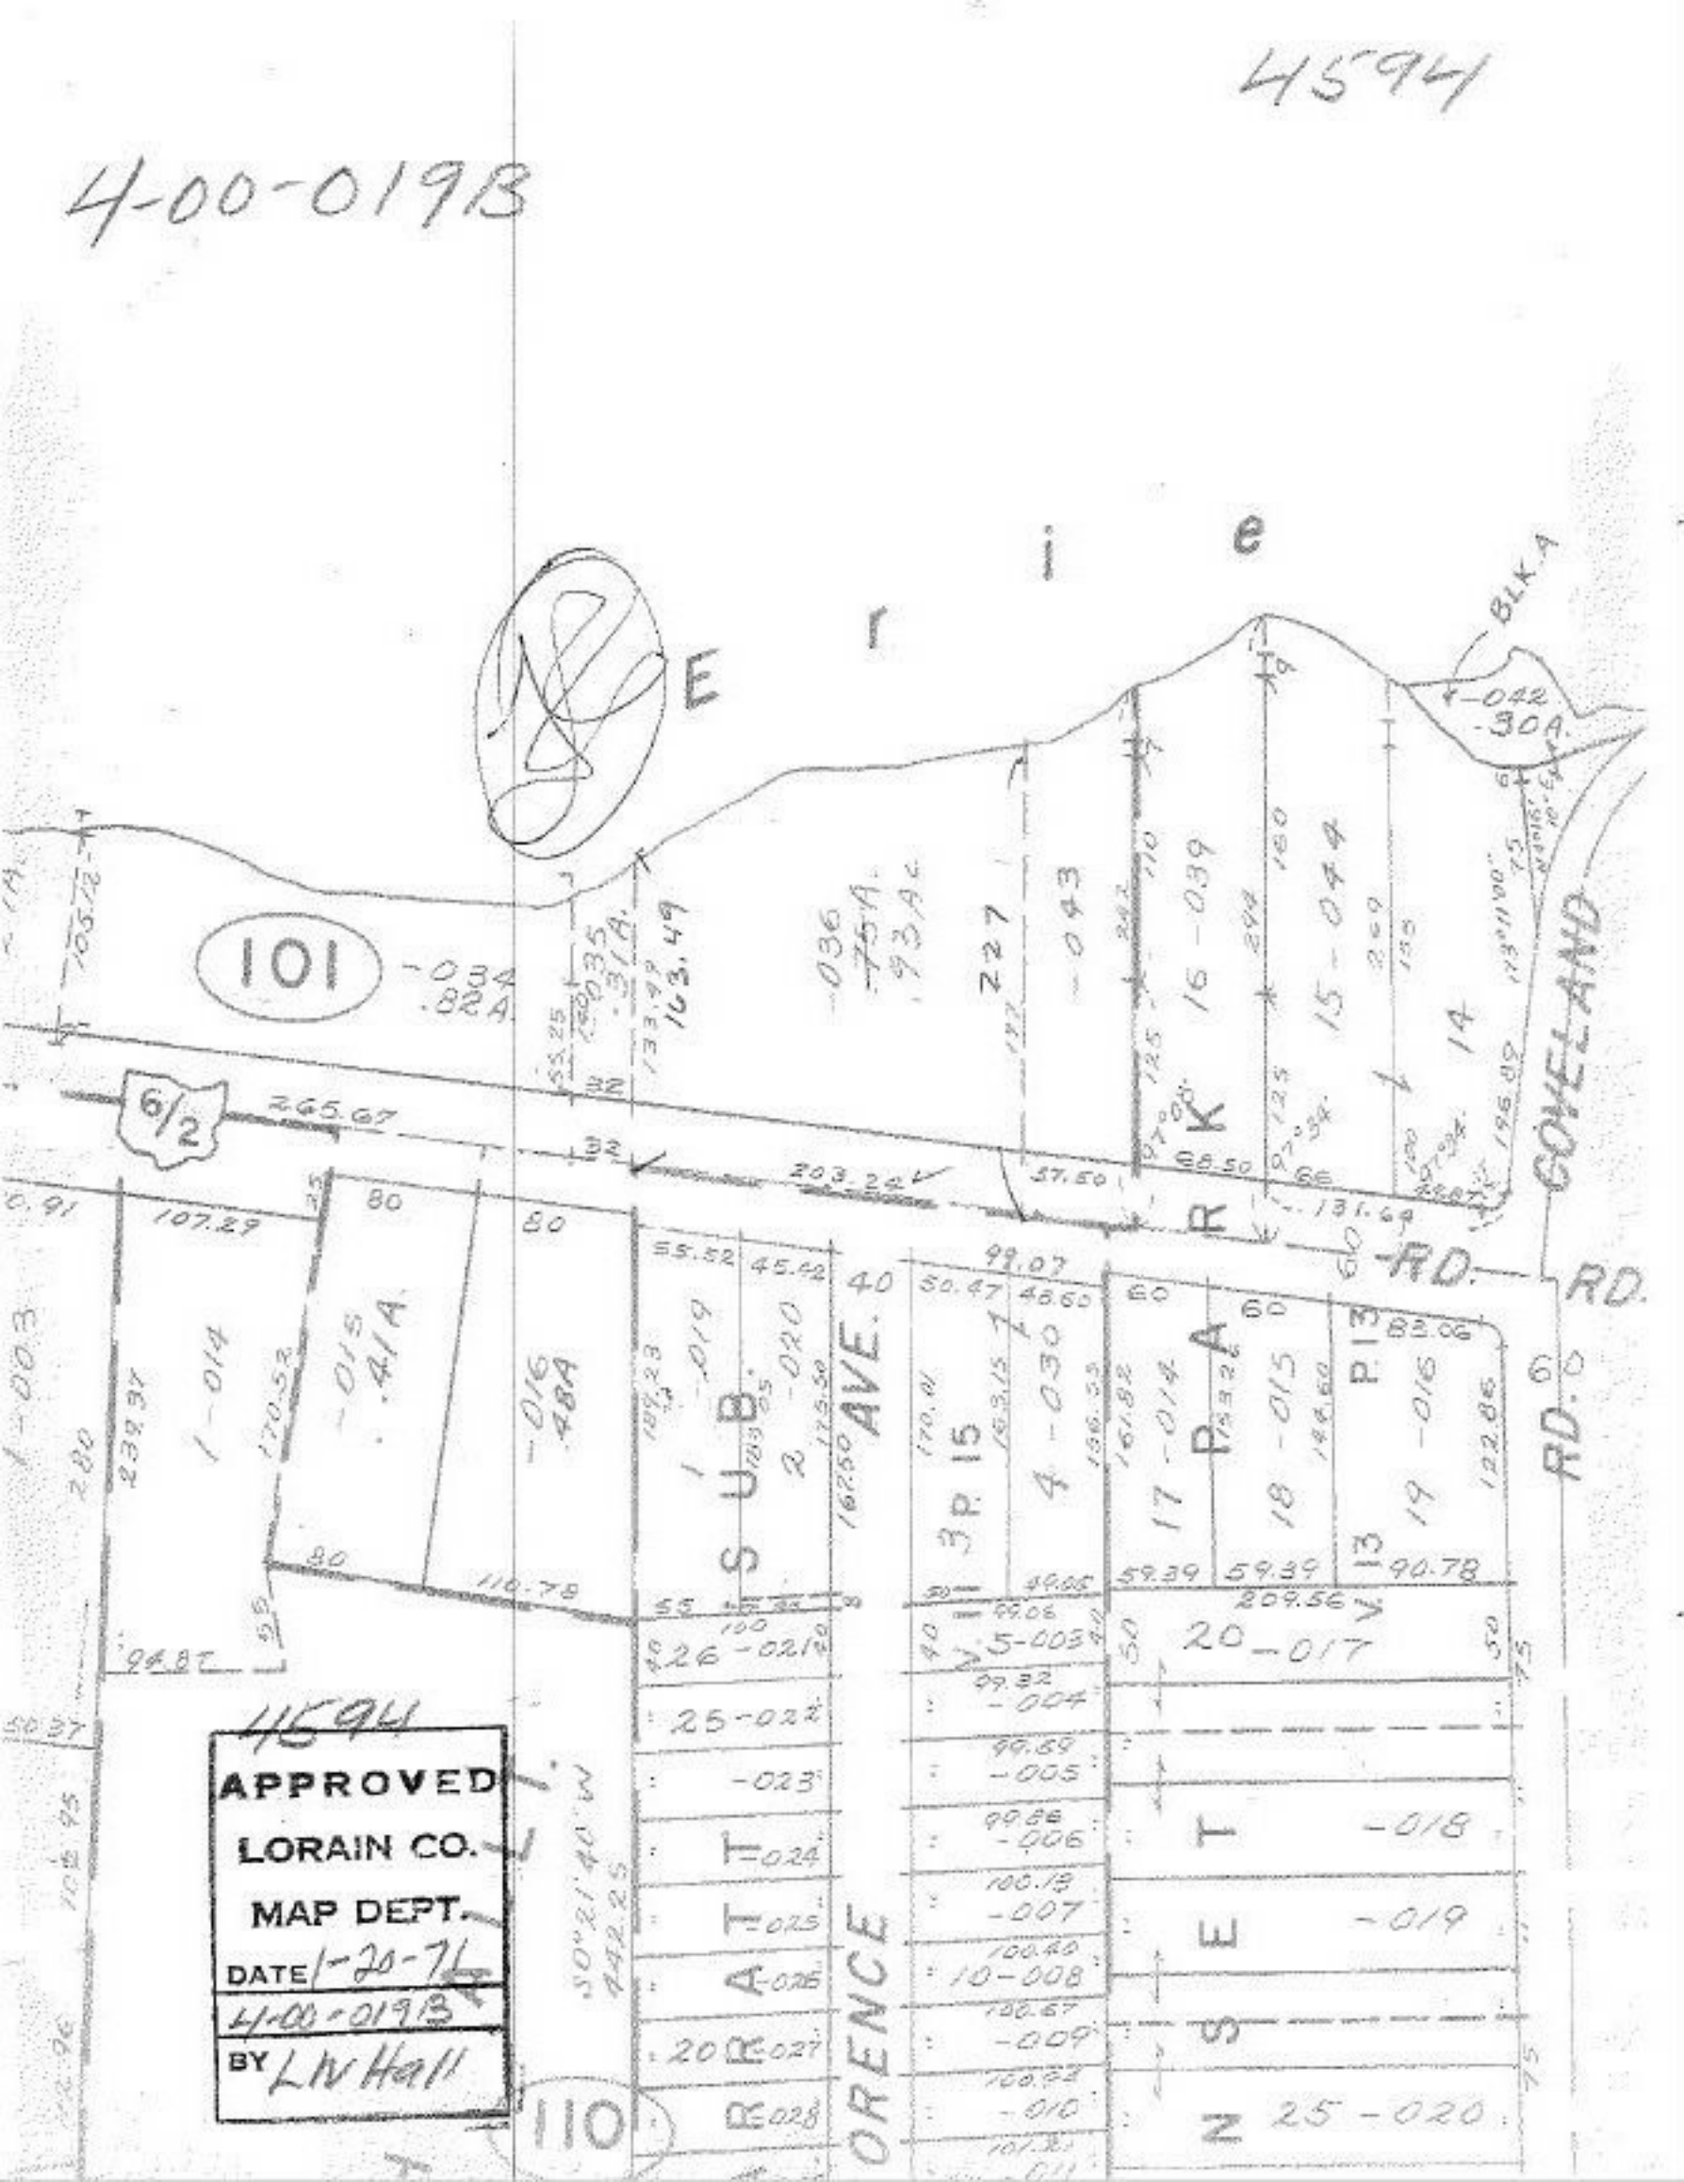
4-00-0193