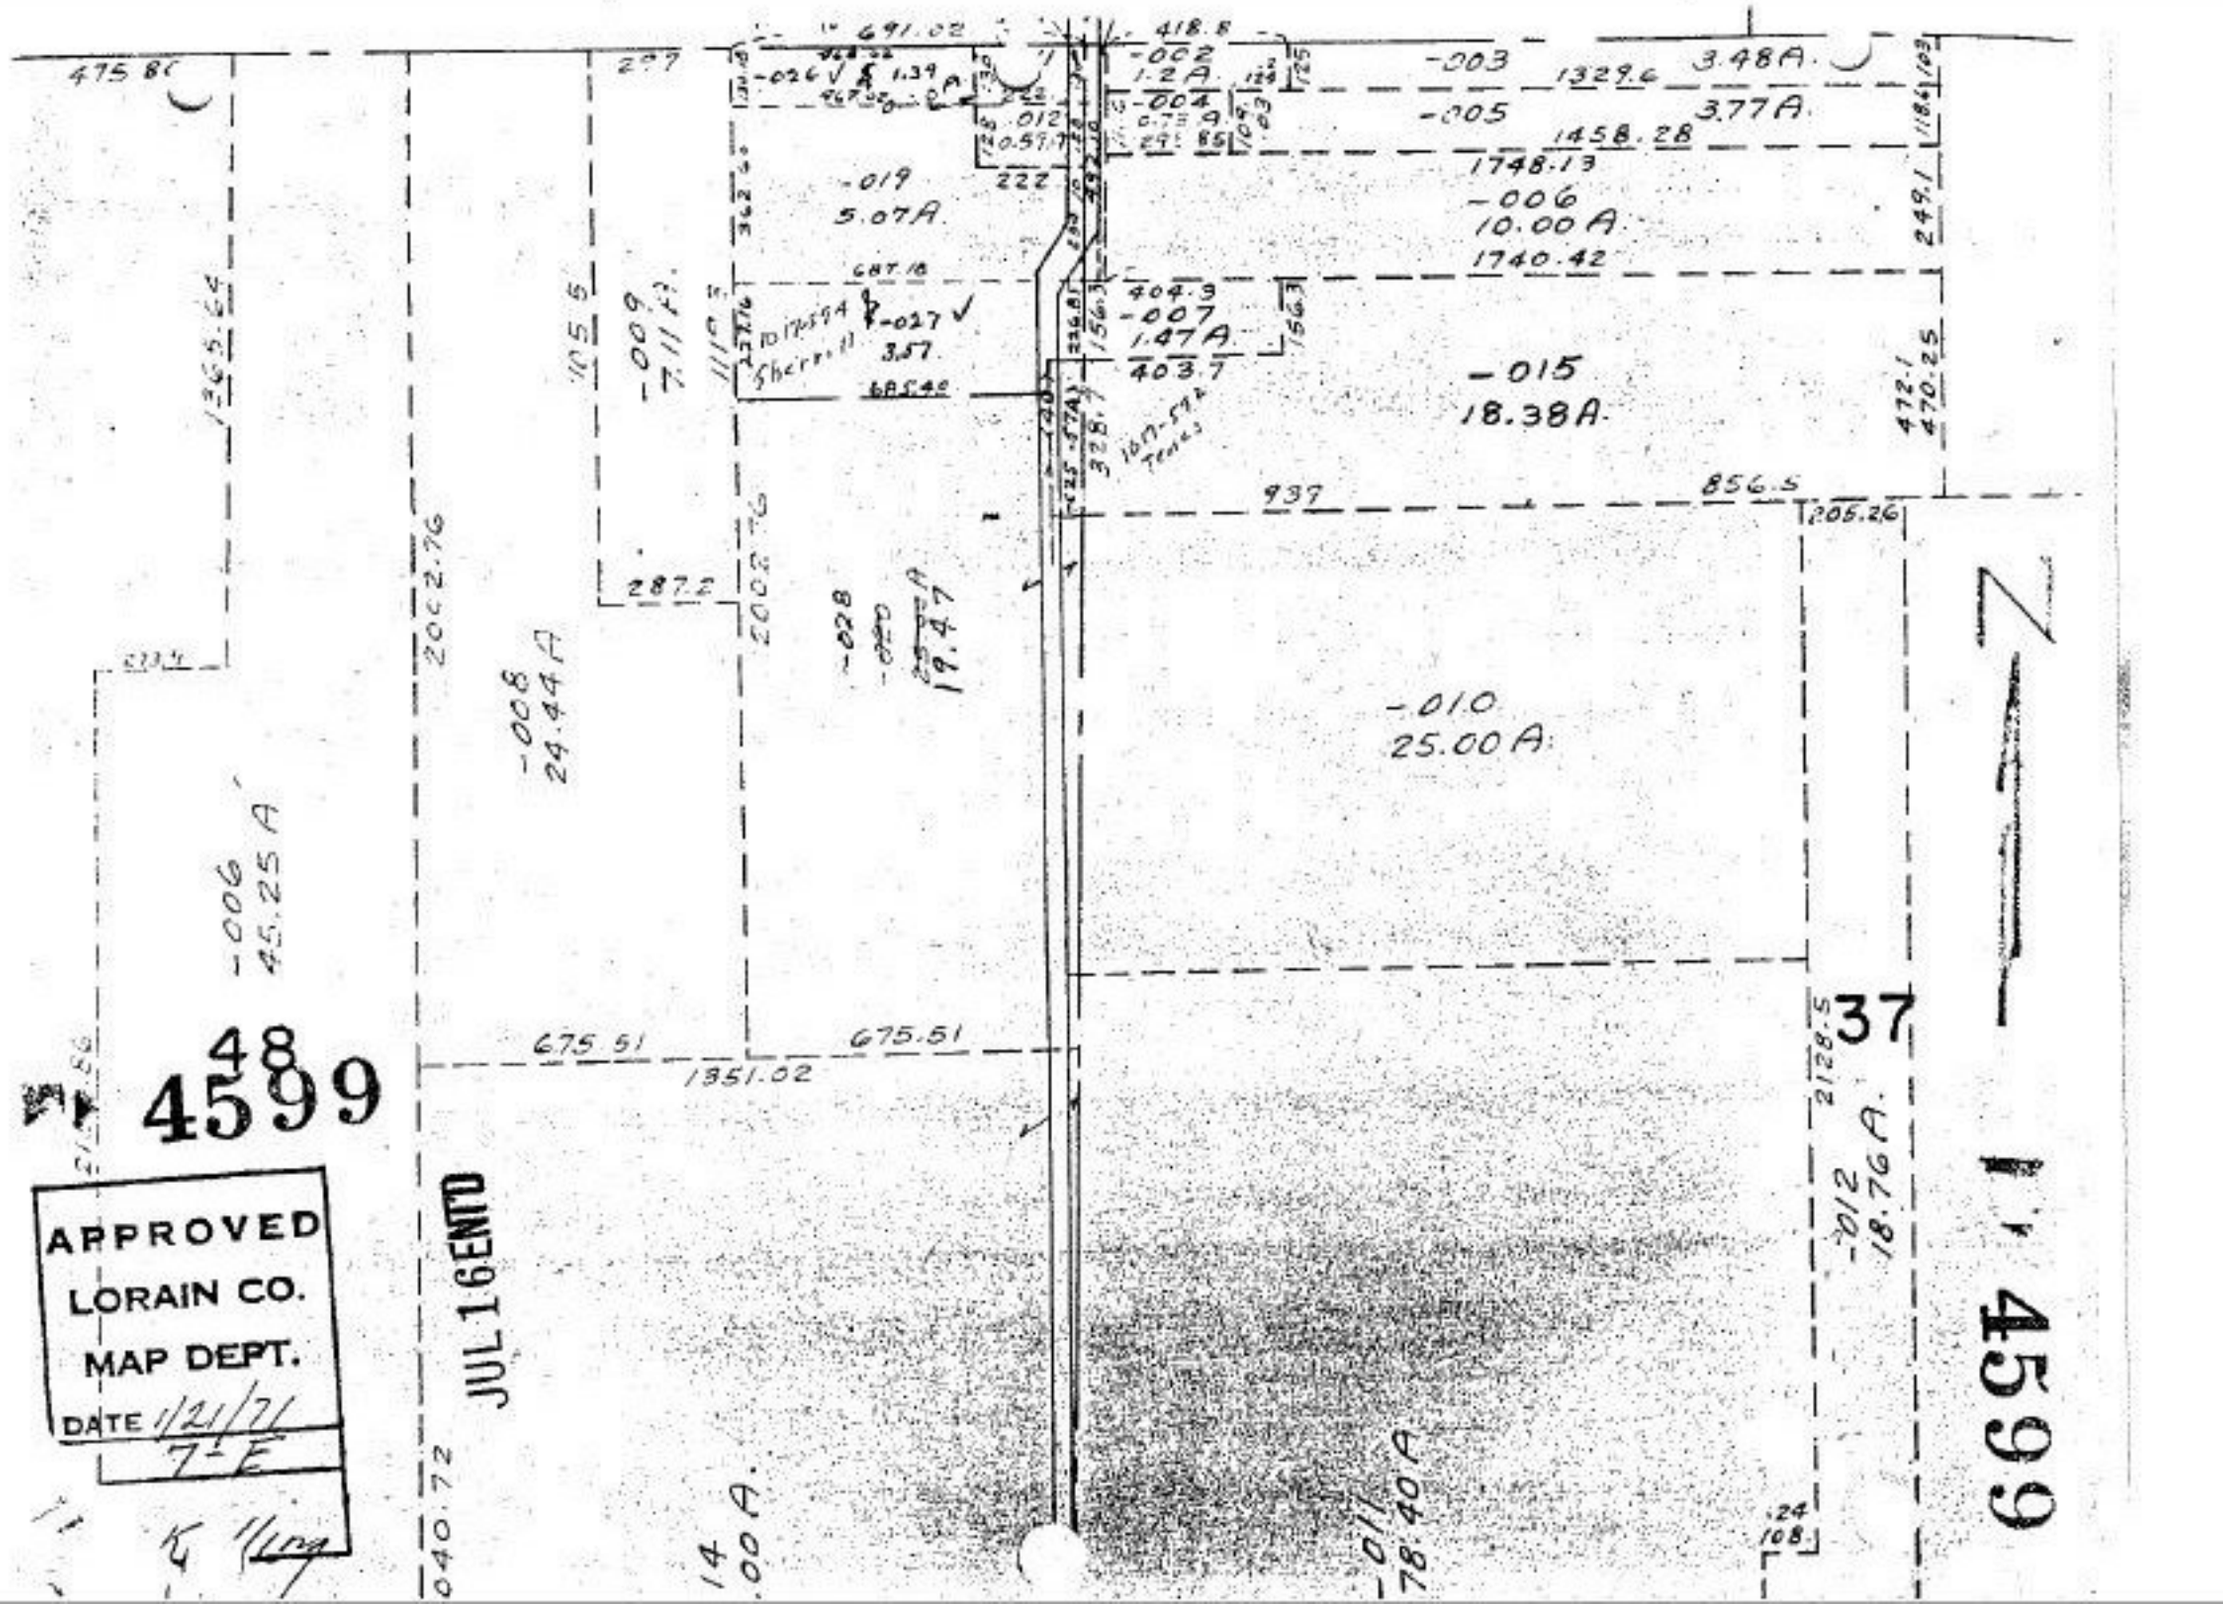

691.02
418.8
-002
1.2A
-003
1329.6
3.48A
-005
3.77A
1458.28
1748.13
-006
10.00A
1740.42
-019
5.07A
-007
1.47A
403.7
-015
18.38A
856.5
205.26
-010
25.00A
-009
7.11A
-008
24.44A
-006
45.25A
2002.76
287.2
675.51
1351.02
37
-012
18.76A
-011
78.40A
48
4599
APPROVED
LORAIN CO.
MAP DEPT.
DATE 1/21/71
7-E
JUL 16 ENT'D
4599