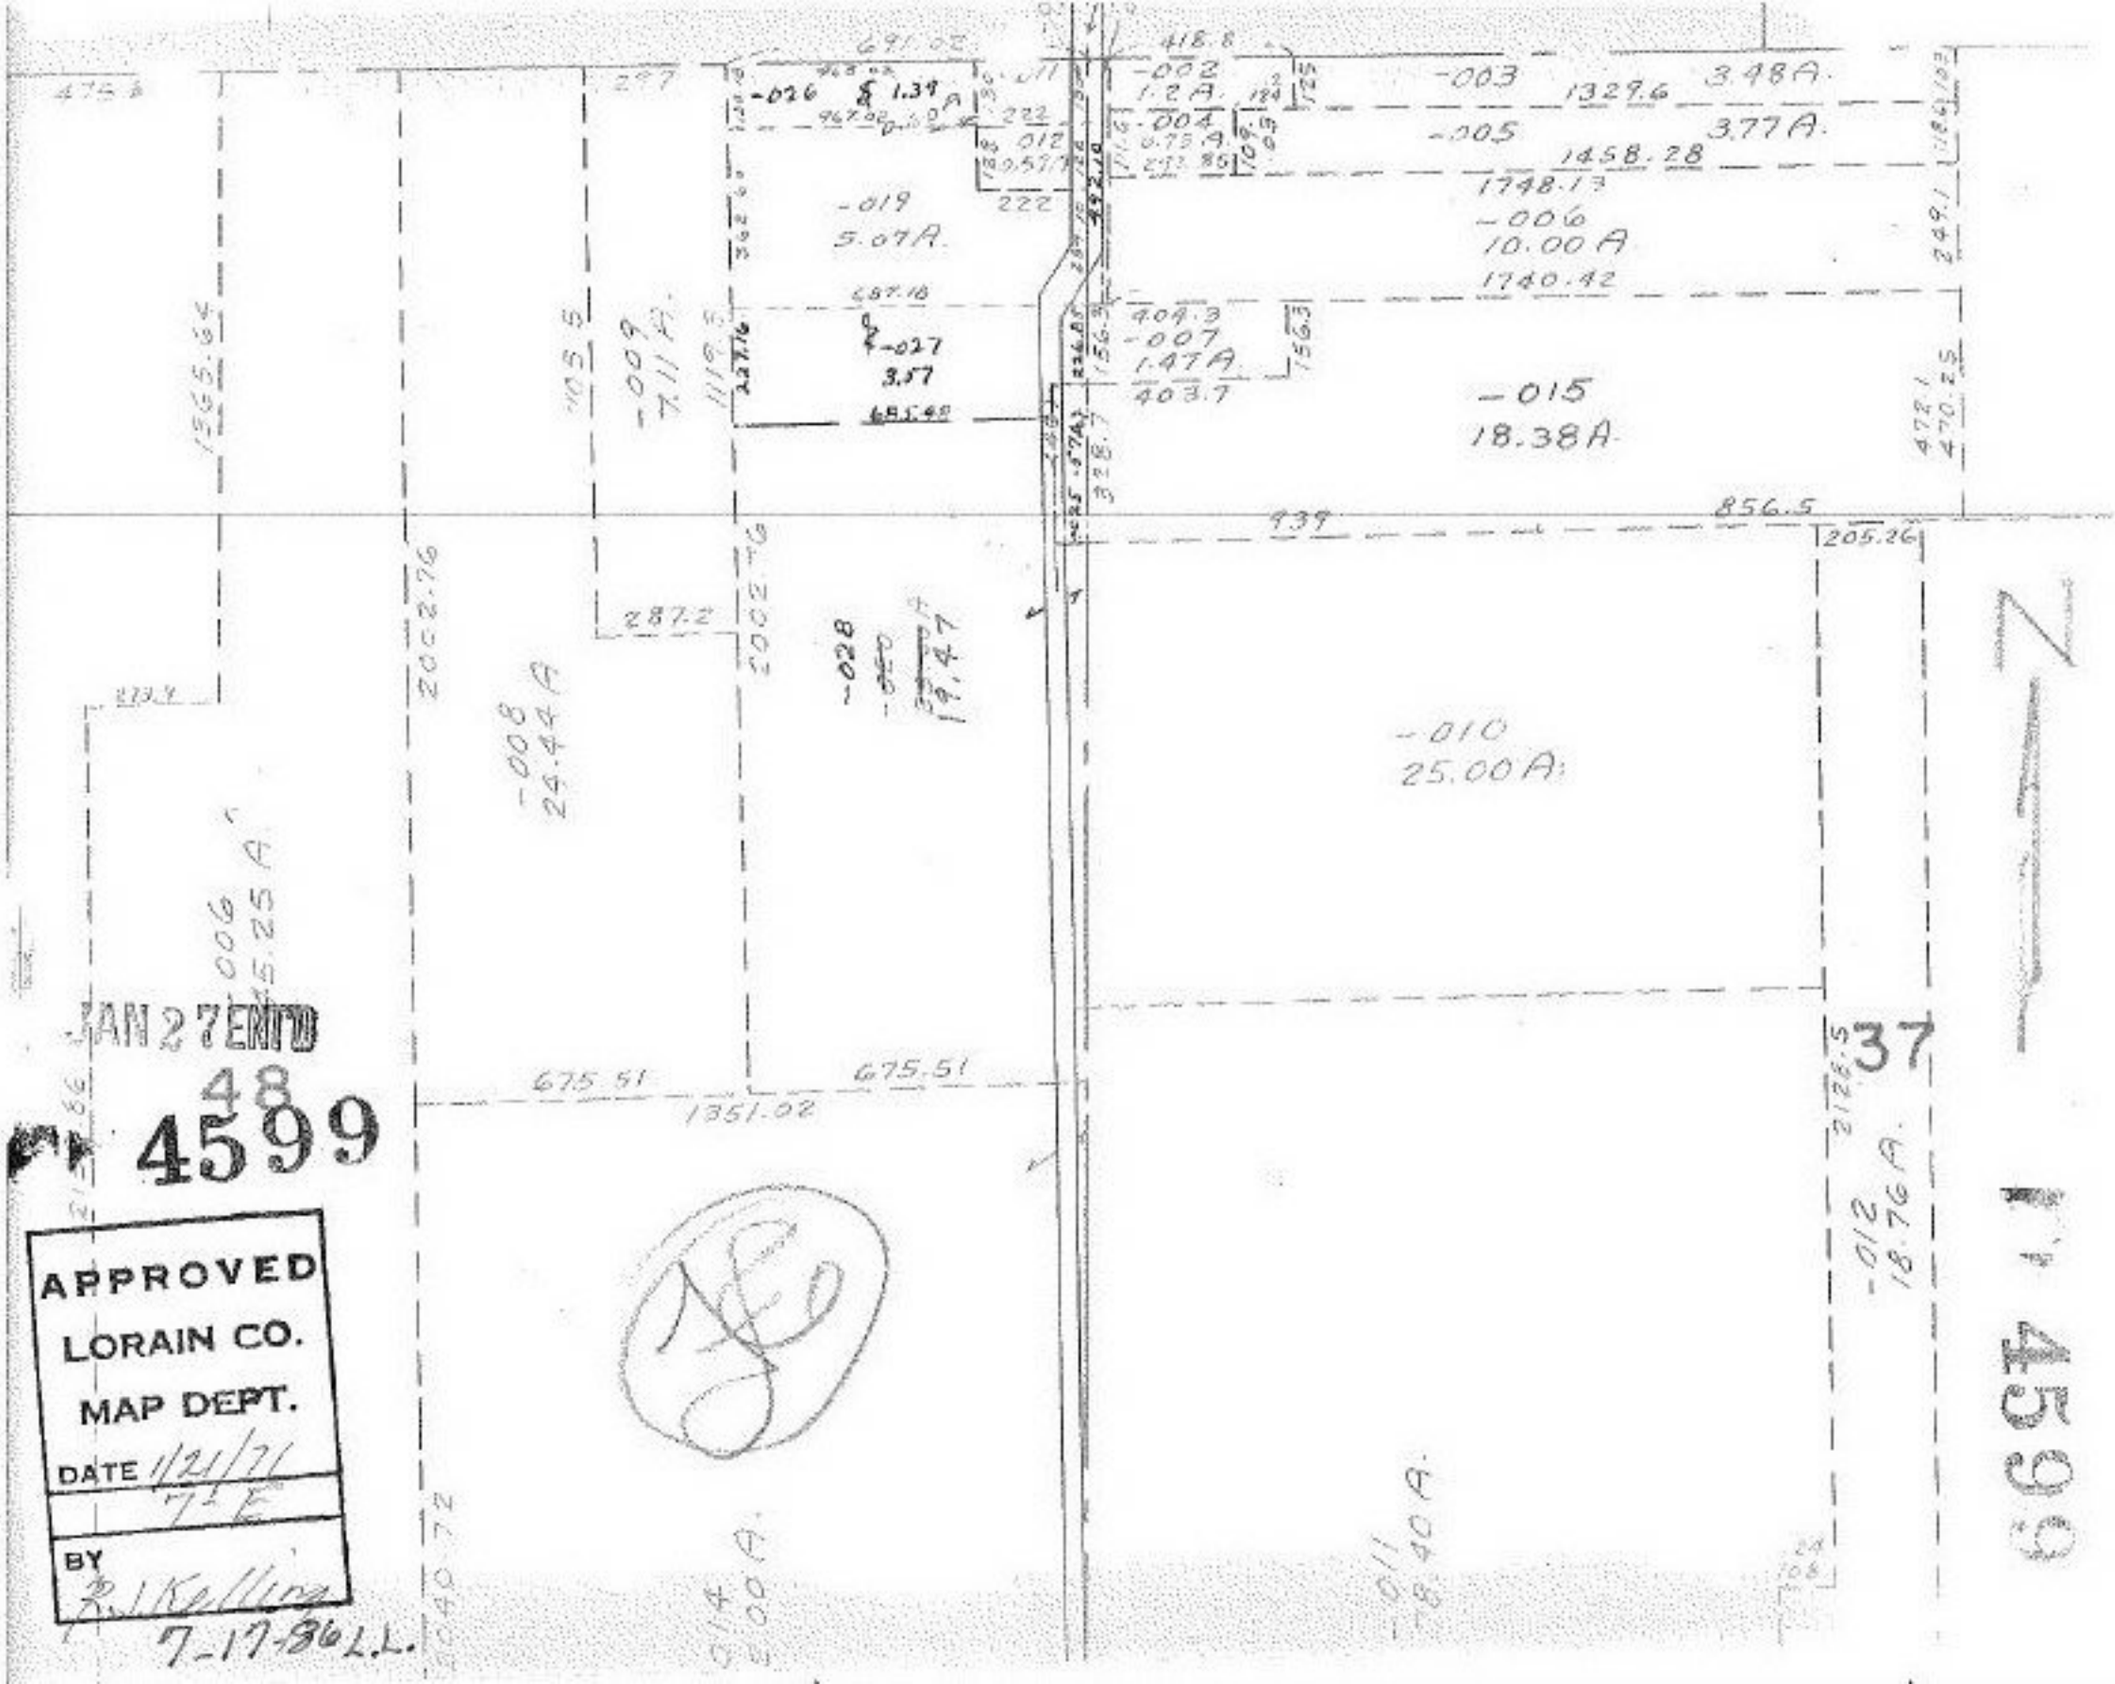
-026 & 1.39 A
-002 1.2 A.
-003 1329.6 3.48 A.
-004 0.75 A.
-005 3.77 A.
1458.28
1748.13
-006 10.00 A
1740.42
-019 5.07 A.
-009 7.11 A.
-027 3.57
-007 1.47 A
-015 18.38 A.
-008 24.44 A.
-028
-010 25.00 A.
-012 18.76 A.
-011 18.40 A.
-014 A.
675.51
1351.02
856.5
937
205.26
2126.5
2002.76
1365.64
1040.72
JAN 27 ENTD
48
4599
APPROVED
LORAIN CO.
MAP DEPT.
DATE 1/21/71
7-17-86 L.L.
37
