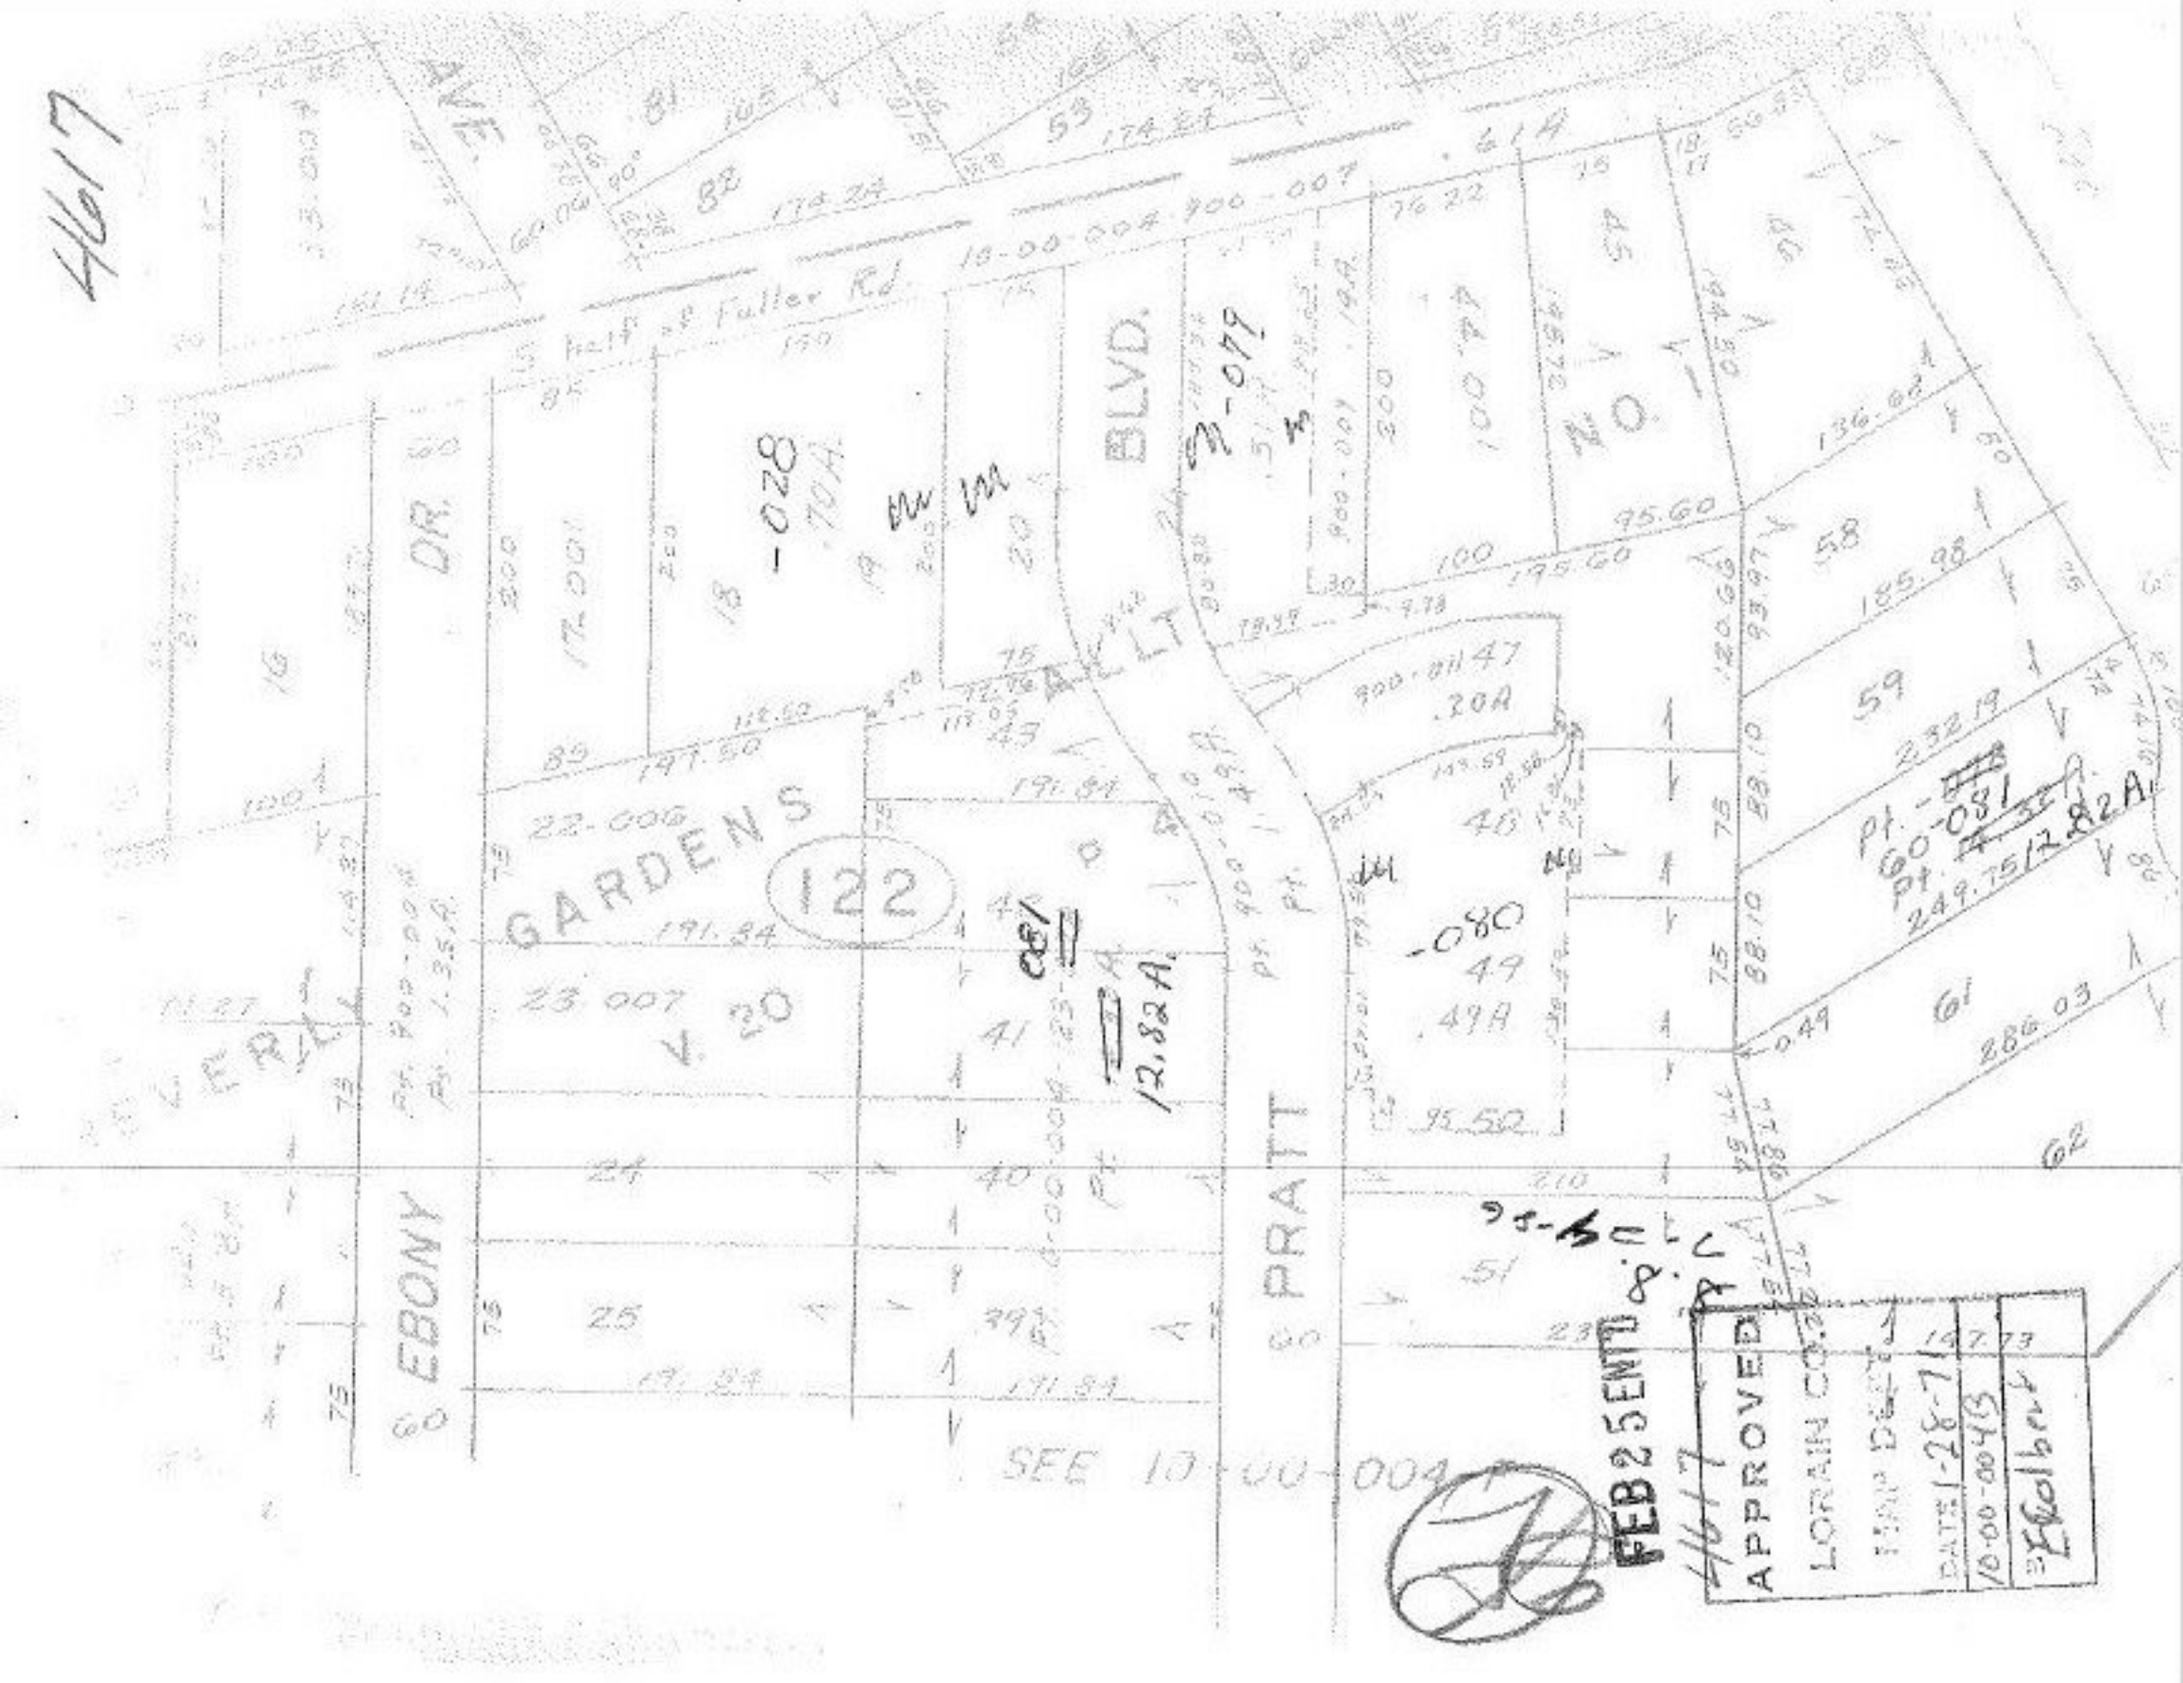
4617
AVE.
S. half of Fuller Rd.
10-00-004-900-007
BLVD.
NO.
DR.
GARDENS
122
V. 20
EBONY
PRATT
-028
-079
-080
-081
12.82 A.
SEE 10-00-004
FEB 25 ENT'D
APPROVED
LORAIN CO.
MAP DEPT.
DATE 1-28-71
10-00-004B
Ecolbert