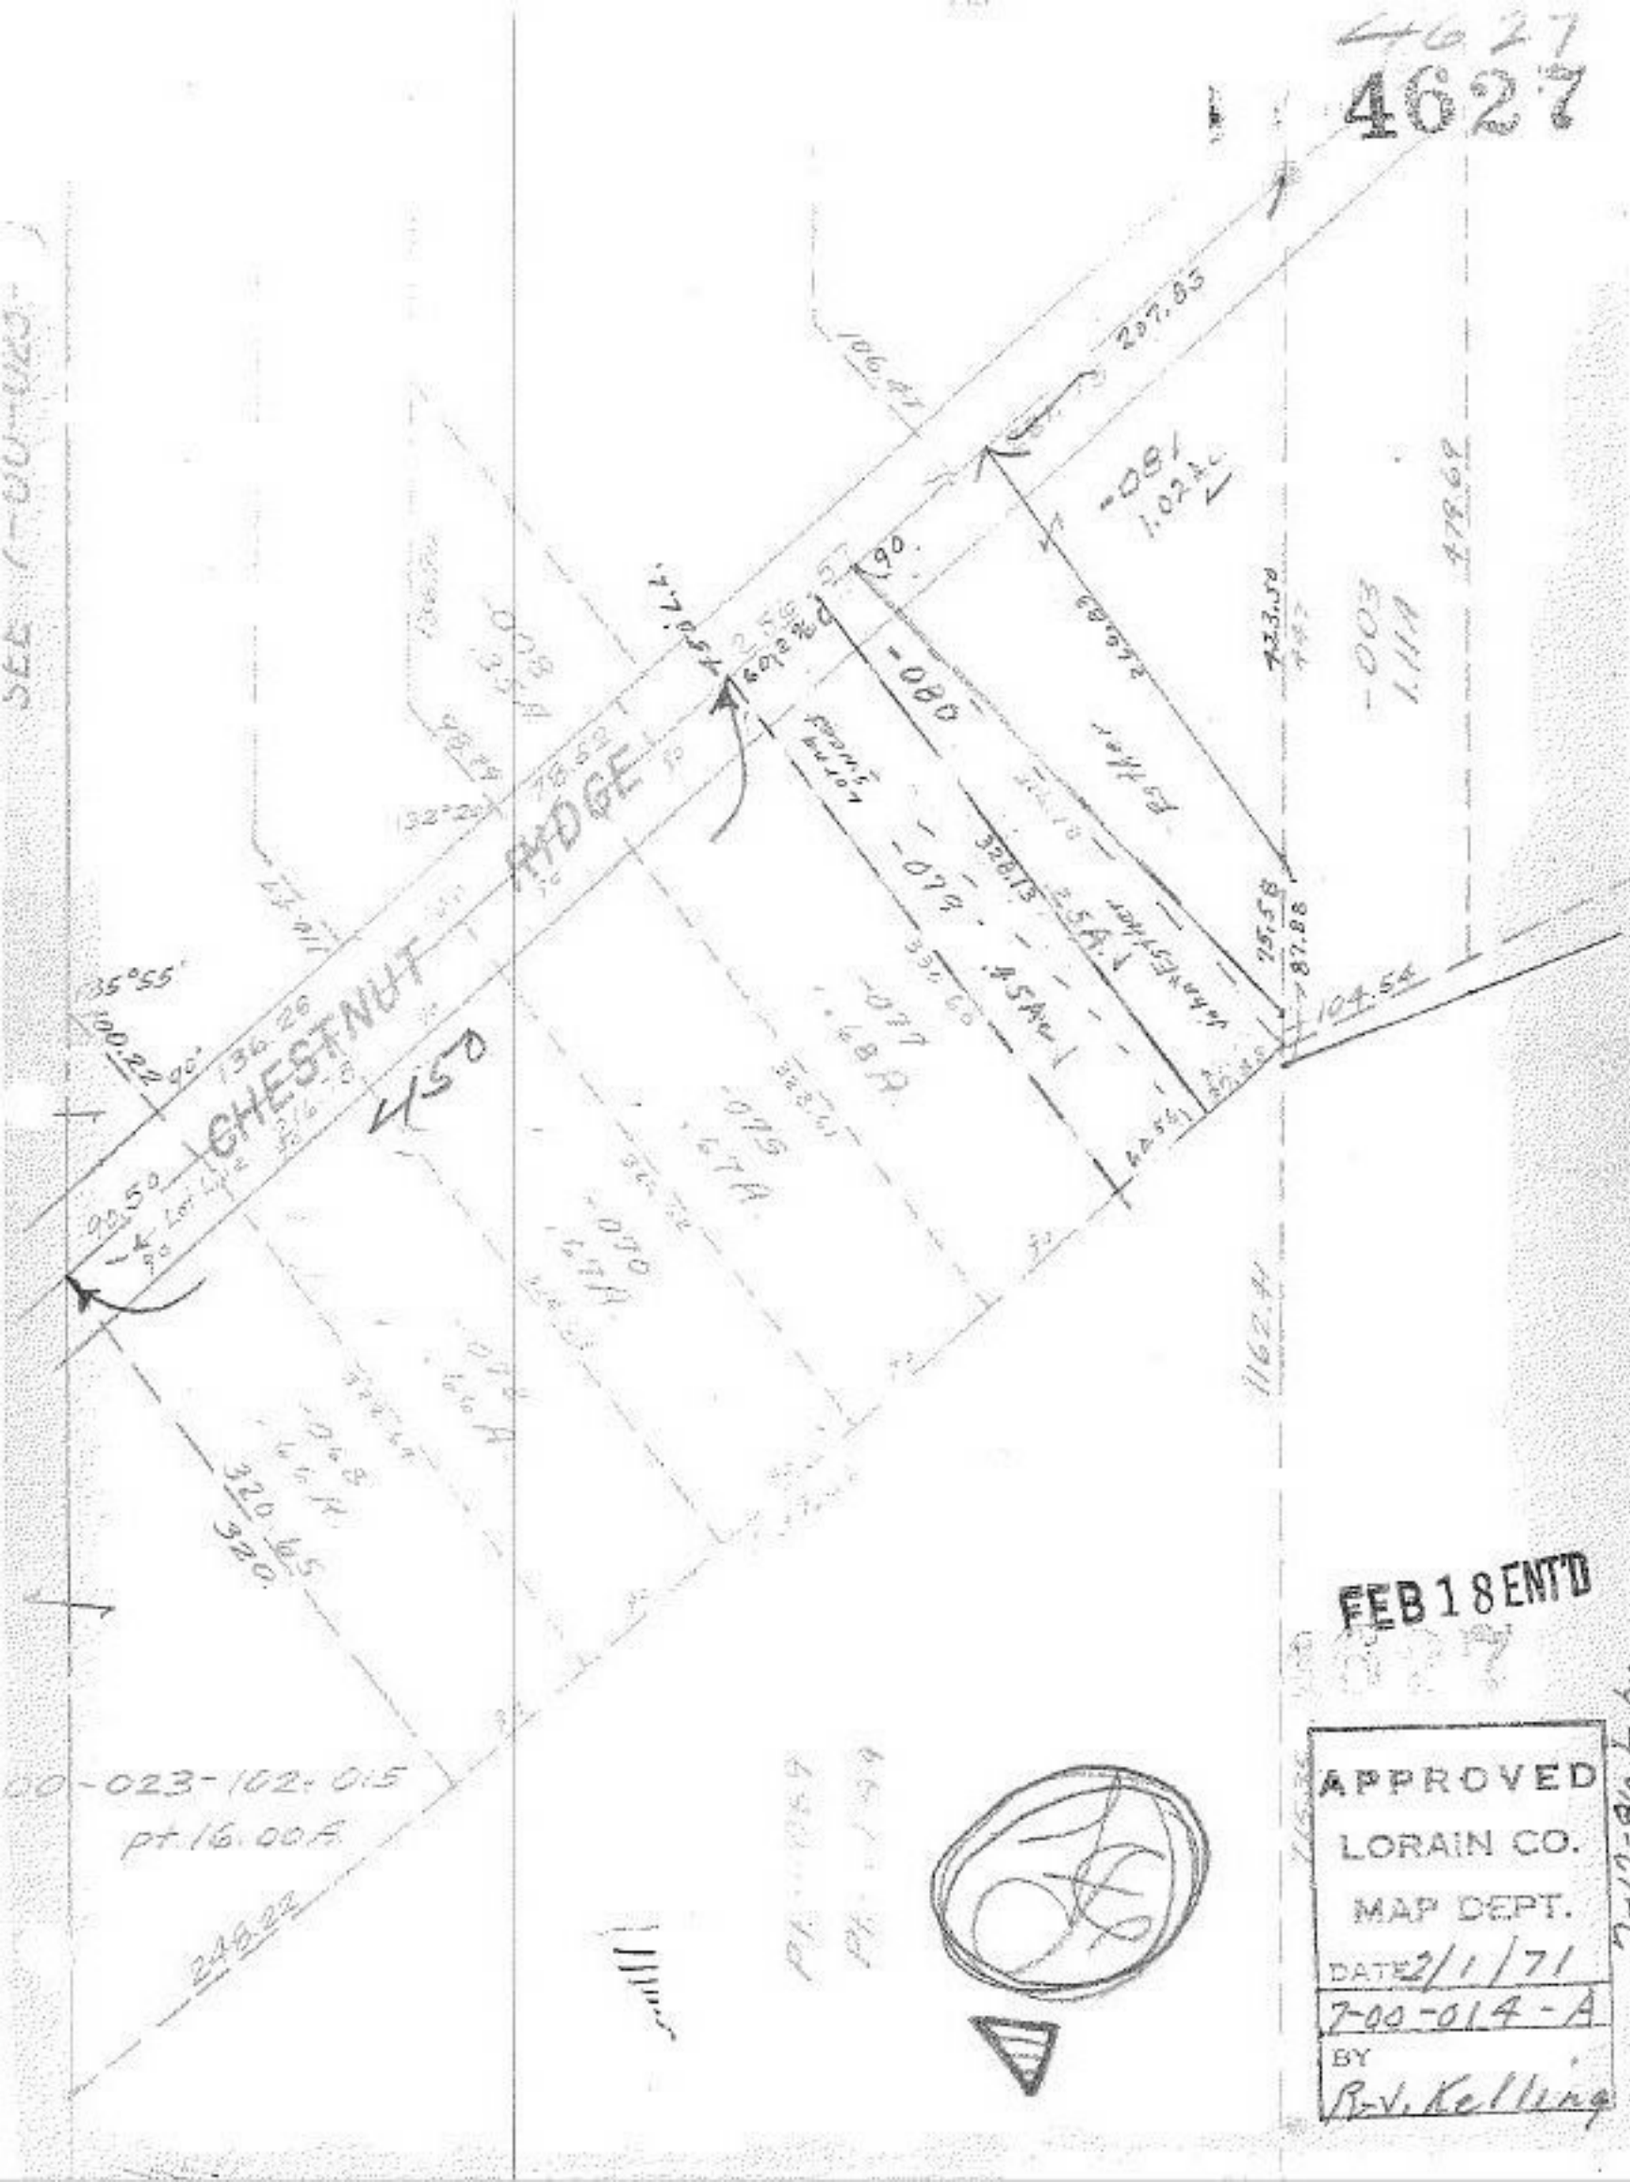
4627
4627
CHESTNUT RIDGE
207.83
106.41
-081
1.02 A.
-080
-079
-077
-078
-003
1.111
178.62
733.50
104.54
1162.4
320.65
320.
249.22
FEB 18 ENT'D
APPROVED
LORAIN CO.
MAP DEPT.
DATE 2/1/71
7-00-014-A
BY
R.V. Kelling
7-19-80 L.V.