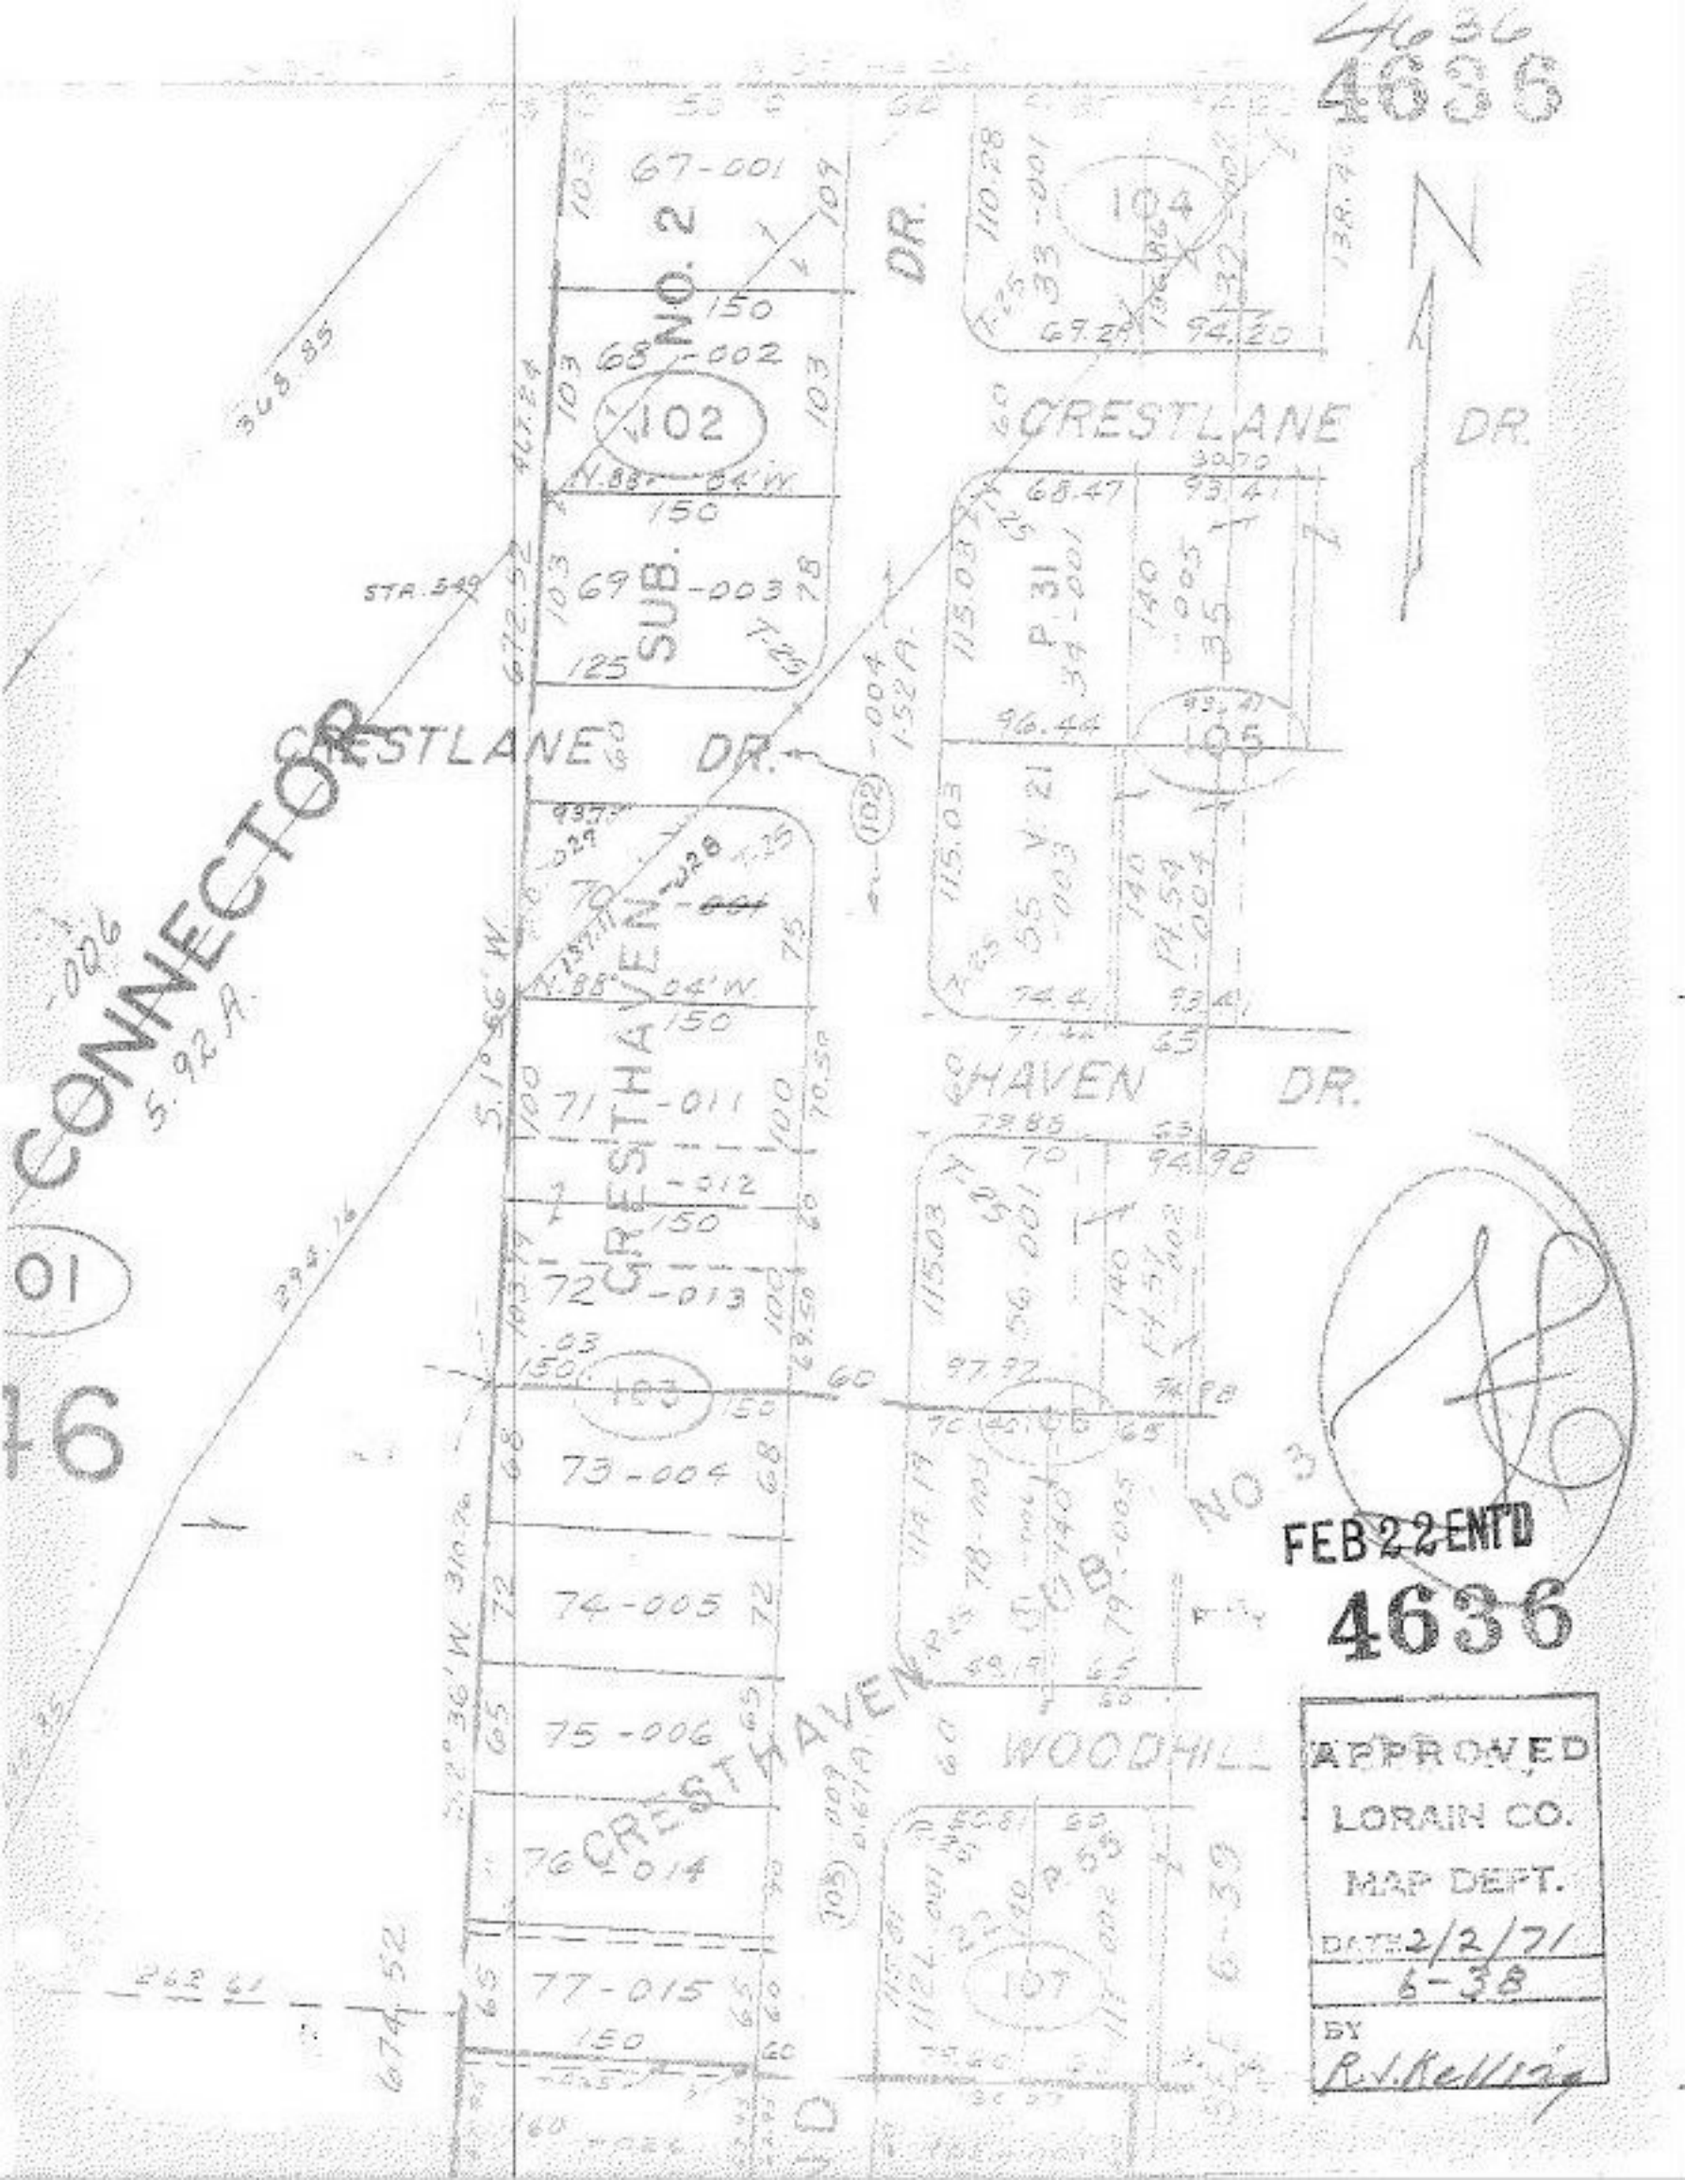
4636
CONNECTOR
CRESTLANE DR.
CRESTHAVEN DR.
HAVEN DR.
WOODHILL DR.
SUB. NO. 2
SUB. NO. 3
67-001
68-002
69-003
70-004
71-011
72-013
73-004
74-005
75-006
76-014
77-015
102
103
104
105
107
FEB 22 ENTD
4636
APPROVED
LORAIN CO.
MAP DEPT.
DATE 2/2/71
6-38
BY
R.V. Kelly