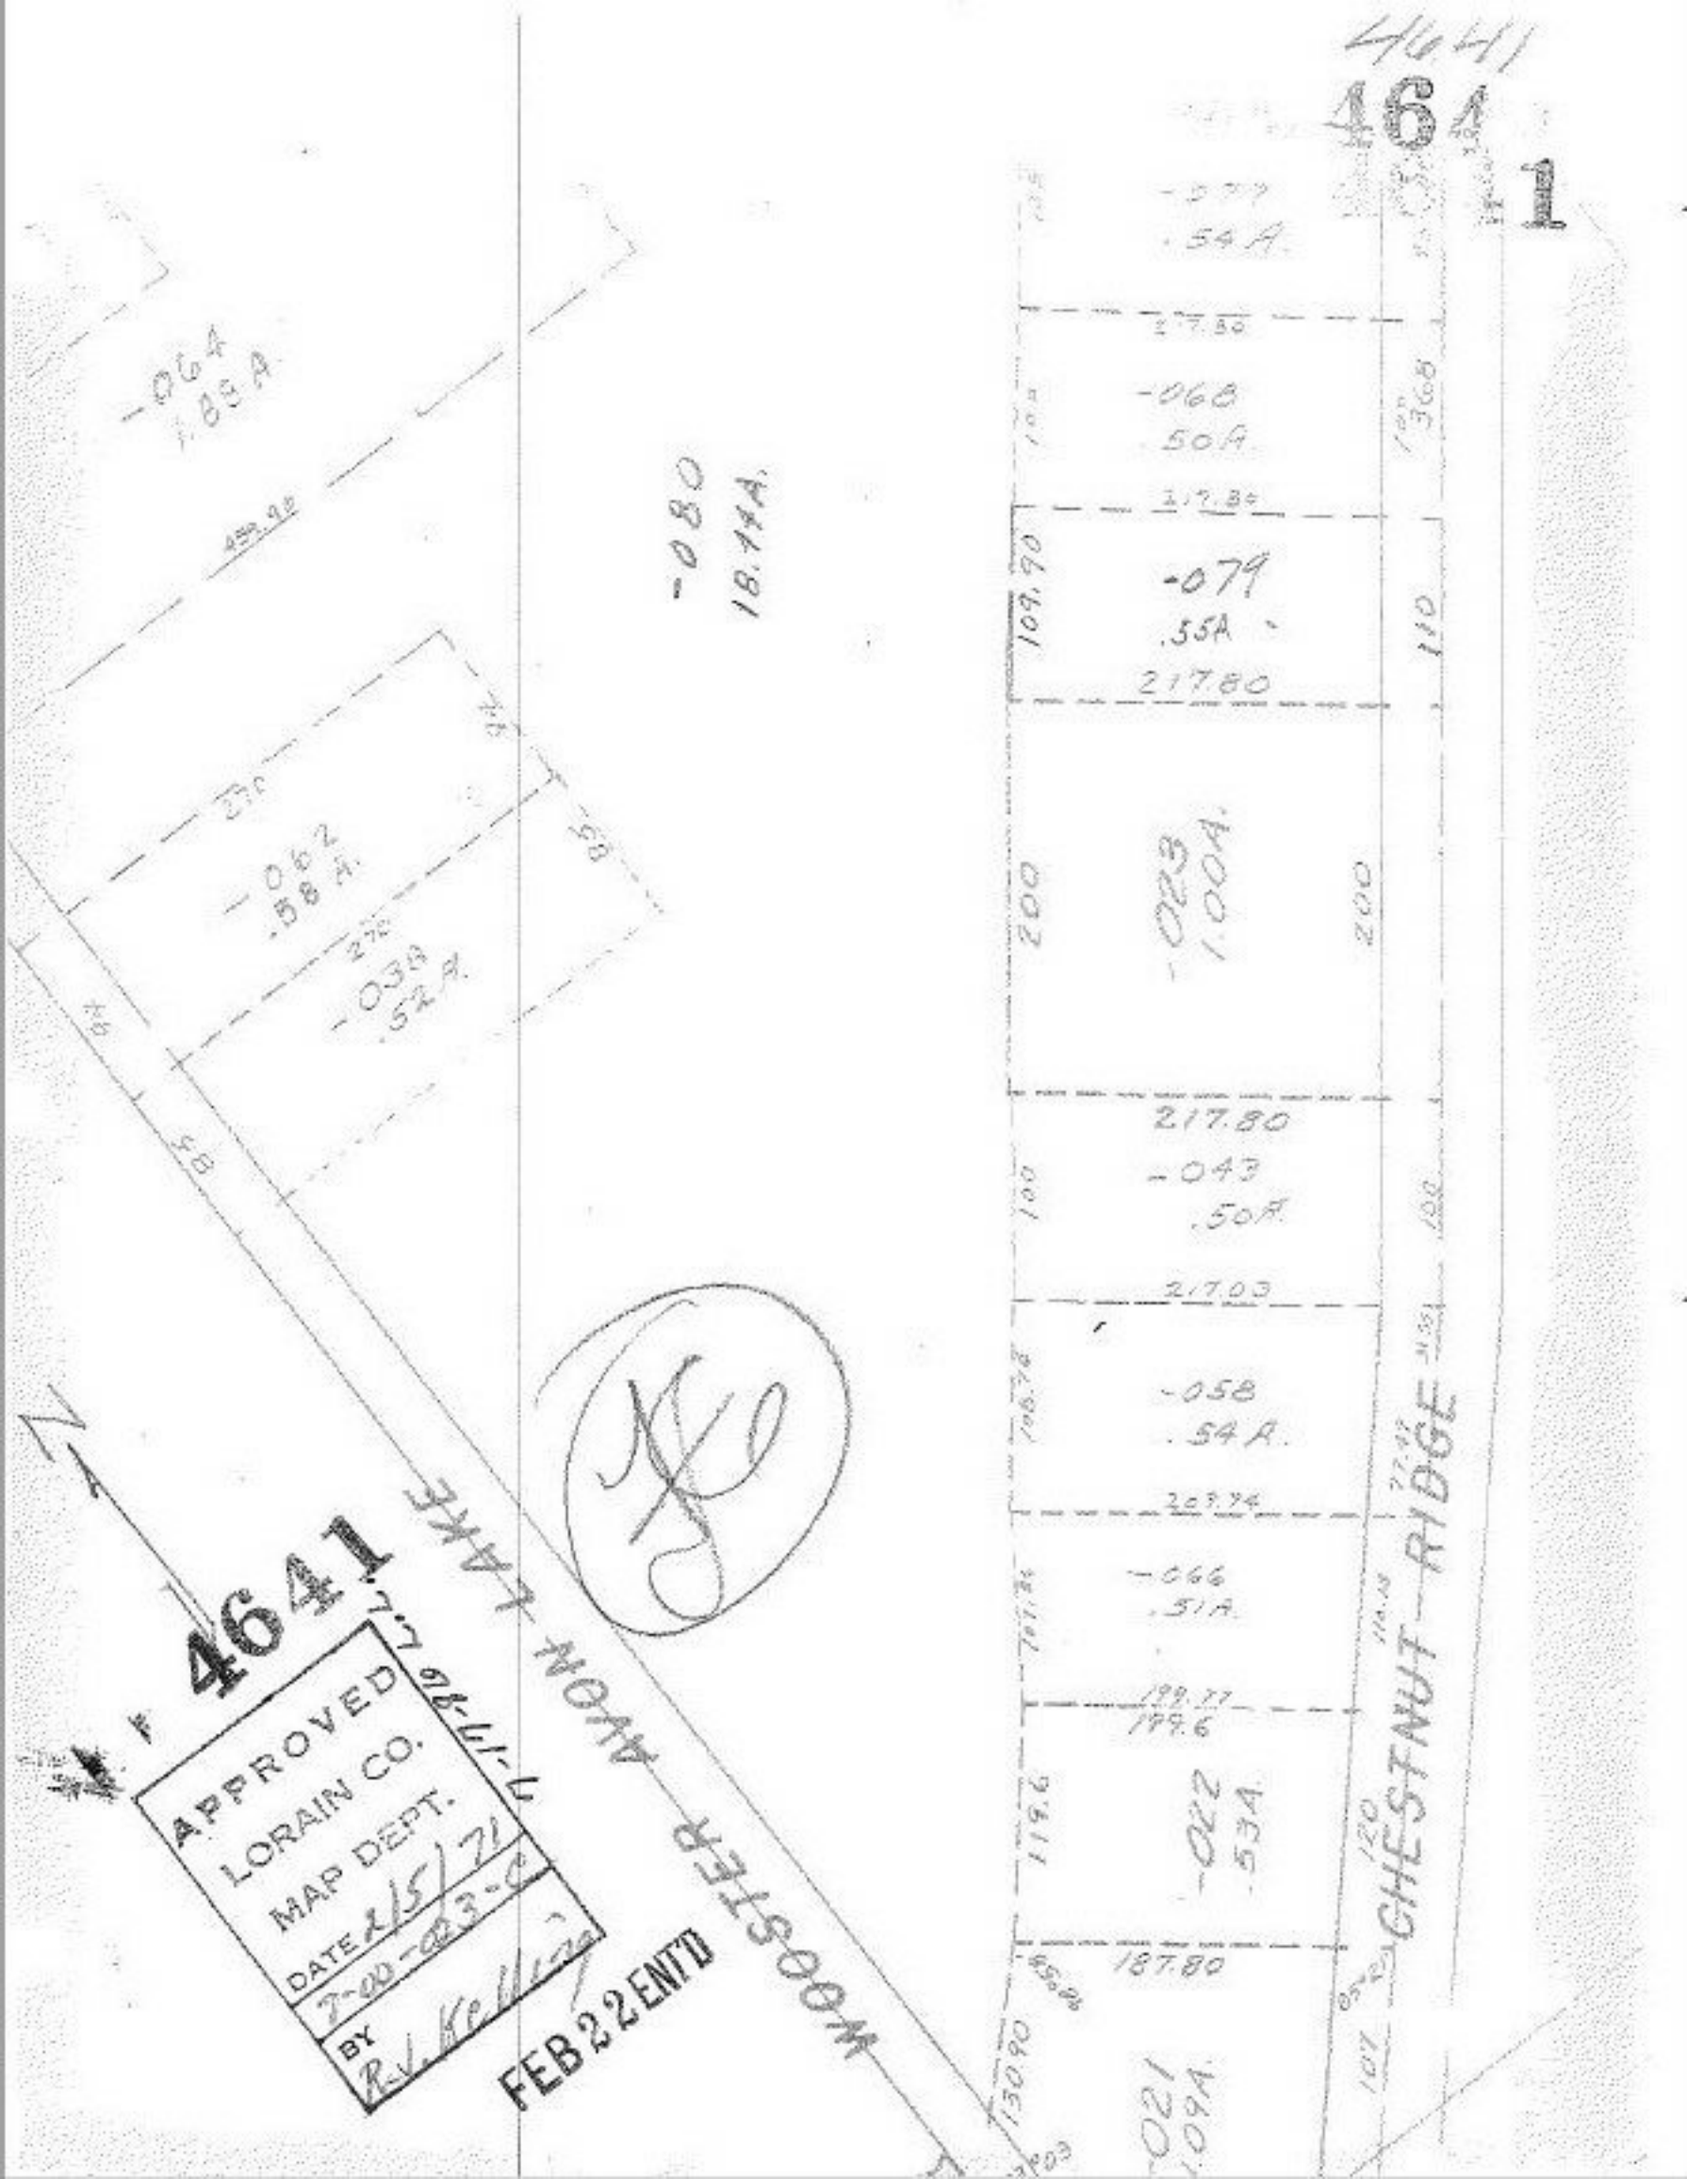
4641
4641
-064
1.88 A
-080
18.44A.
-062
.58 A.
-038
.52 A.
-077
.54 A.
217.80
-068
.50A
217.80
-079
.55A
217.80
109.90
110
200
-023
1.00A.
200
217.80
-043
.50A
100
100
217.03
-058
.54 A.
209.74
-066
.51A.
199.77
199.6
119.6
-022
.53A
120
187.80
130.90
-021
1.09A.
107
CHESTNUT RIDGE
WOOSTER AVON LAKE
N
4641
APPROVED
LORAIN CO.
MAP DEPT.
DATE 2/5/71
7-00-023-C
BY R.J. Kelling
FEB 22 ENT'D