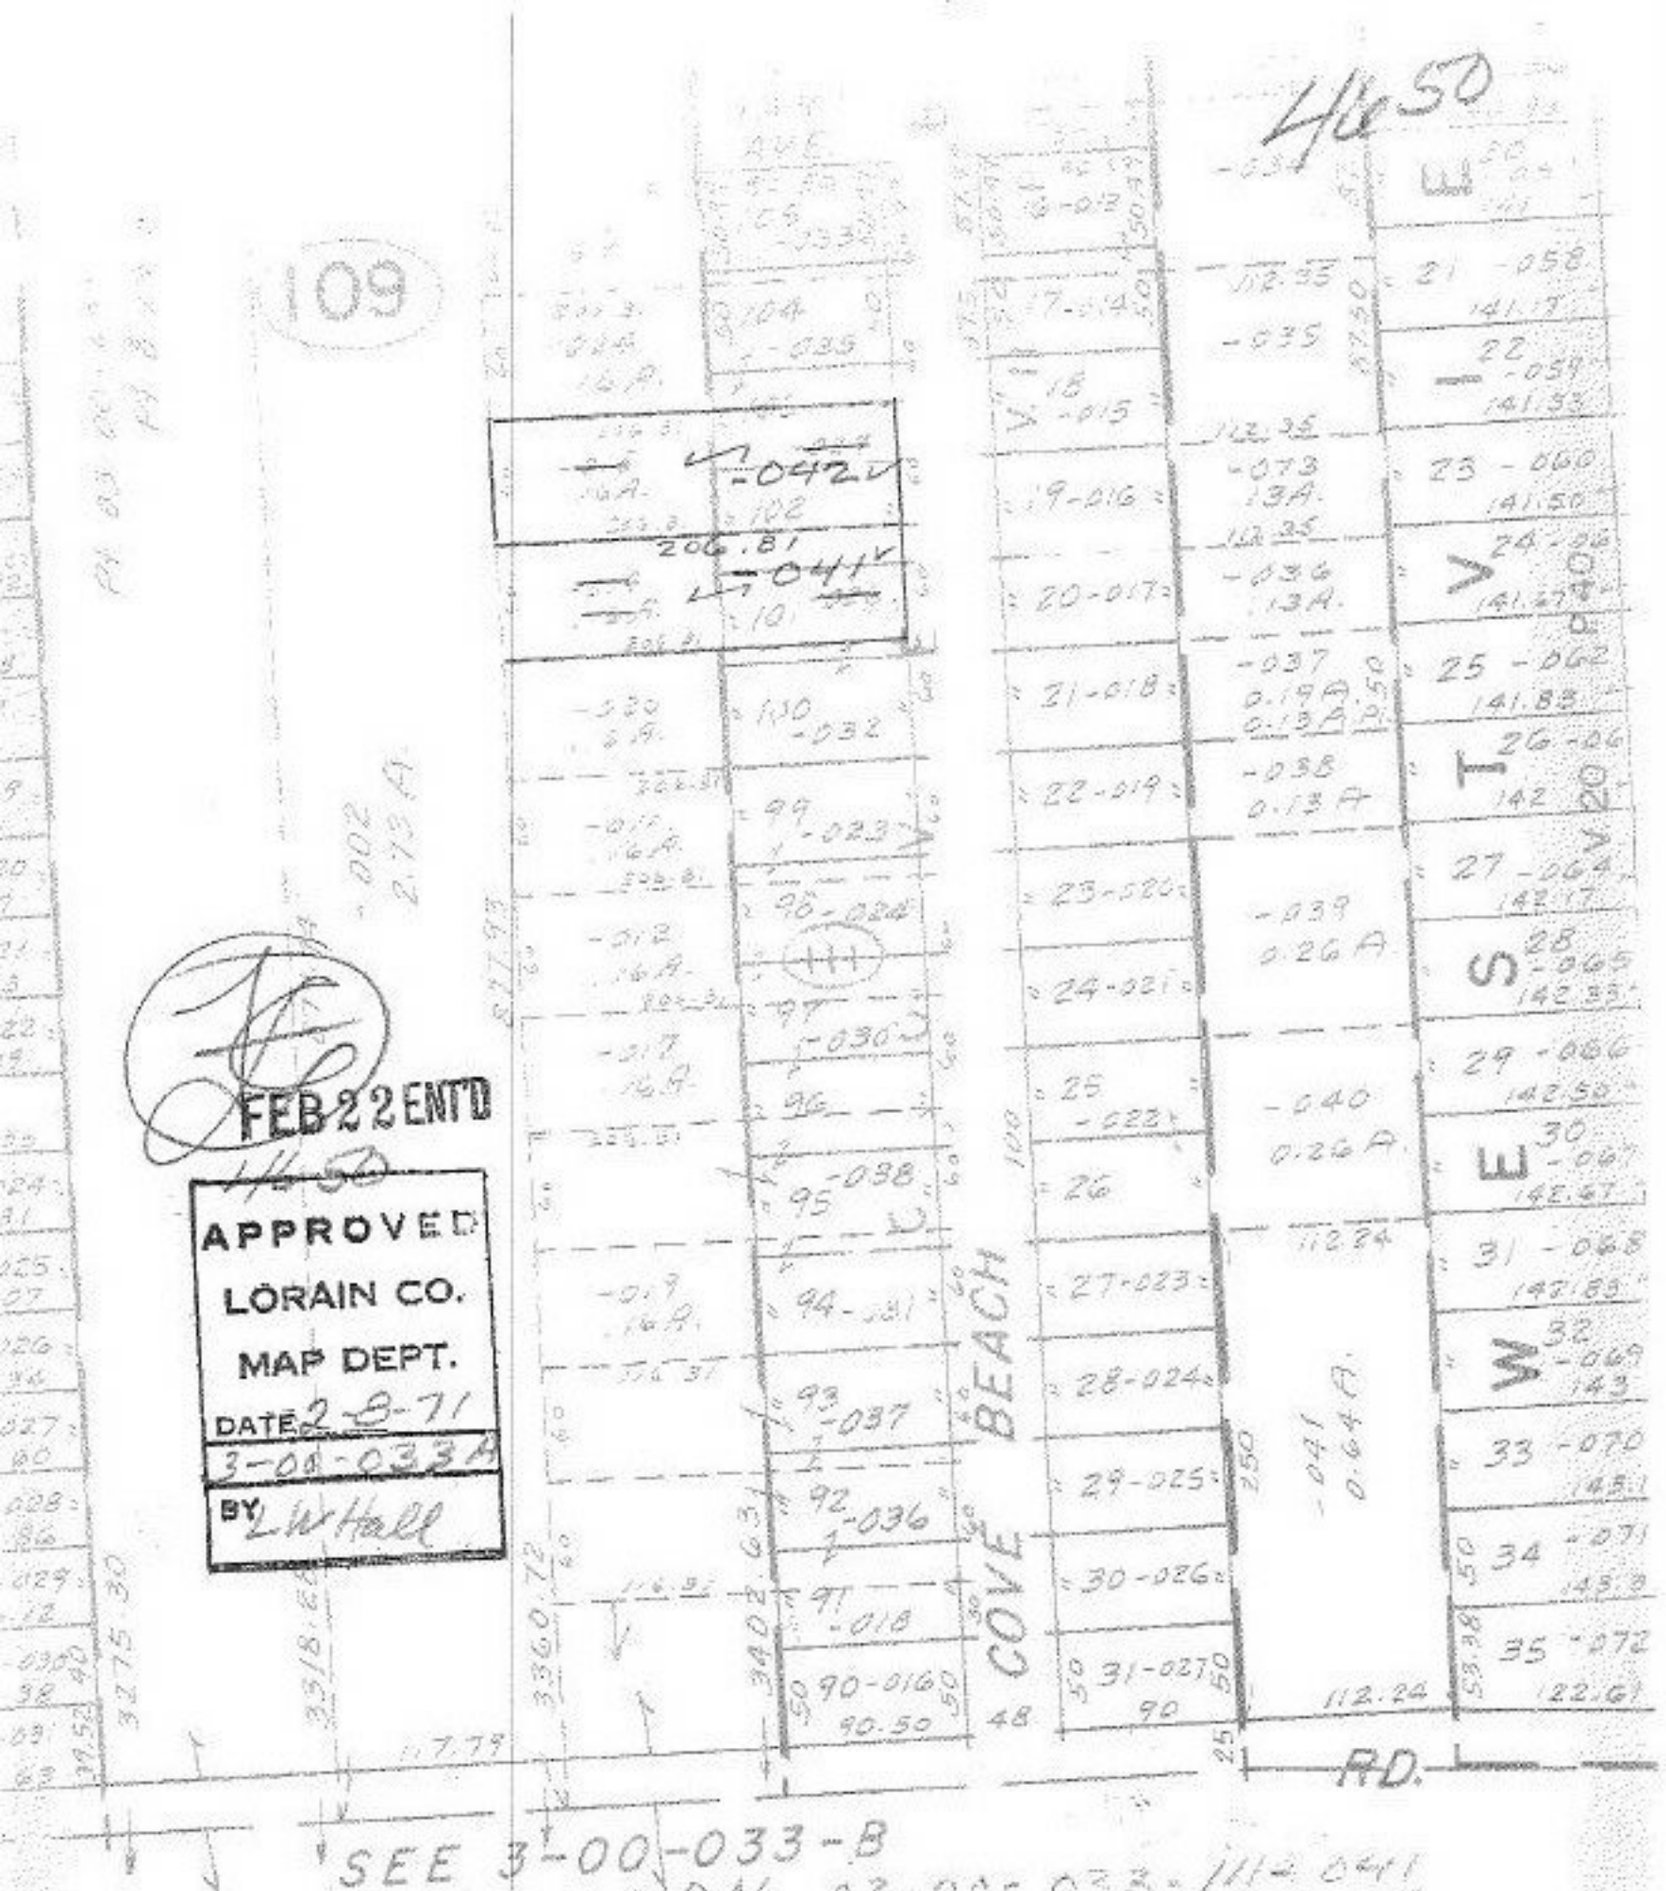

SEE 3-00-033-B

Note P.P.No 03-00-033-111-041
111 042

Note Block No

3-00-033A