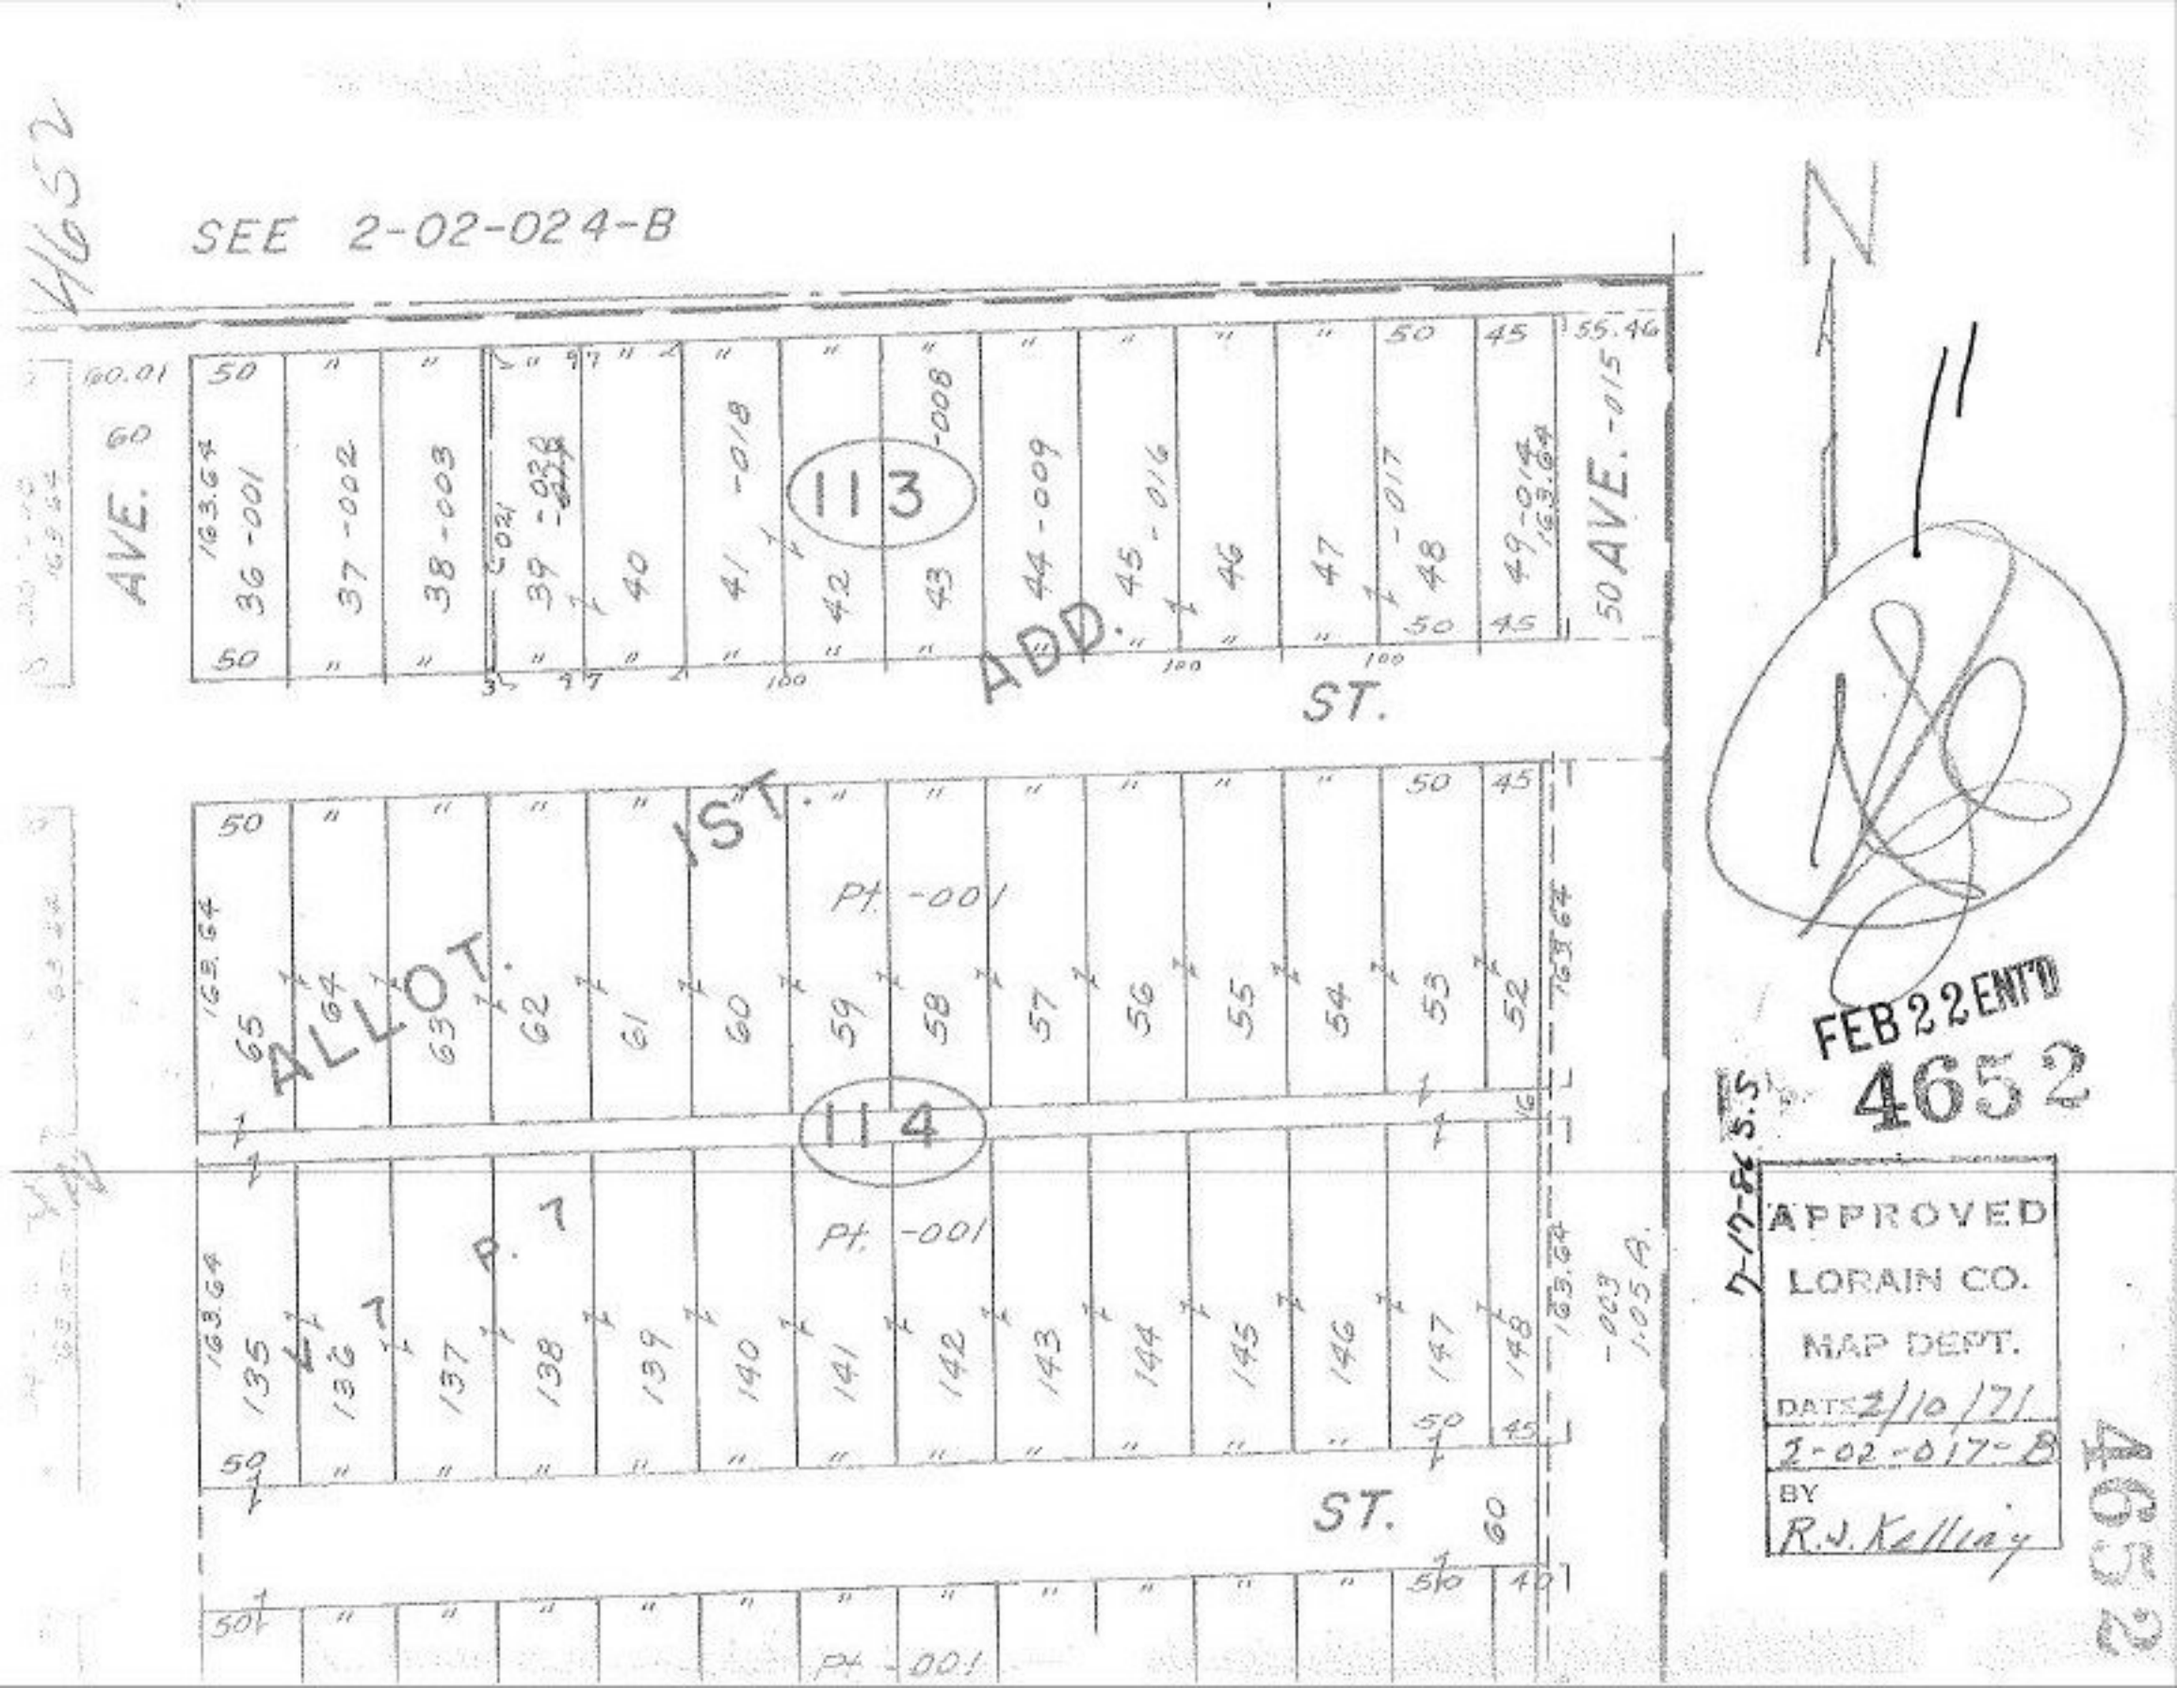
4652
SEE 2-02-024-B
N
AVE.
ADD.
ST.
ALLOT.
1ST.
113
114
Pt. -001
P. 7
FEB 22 ENT'D
4652
7-17-86 S.S.
APPROVED
LORAIN CO.
MAP DEPT.
DATE 2/10/71
2-02-017-B
BY
R.J. Kelling
4652