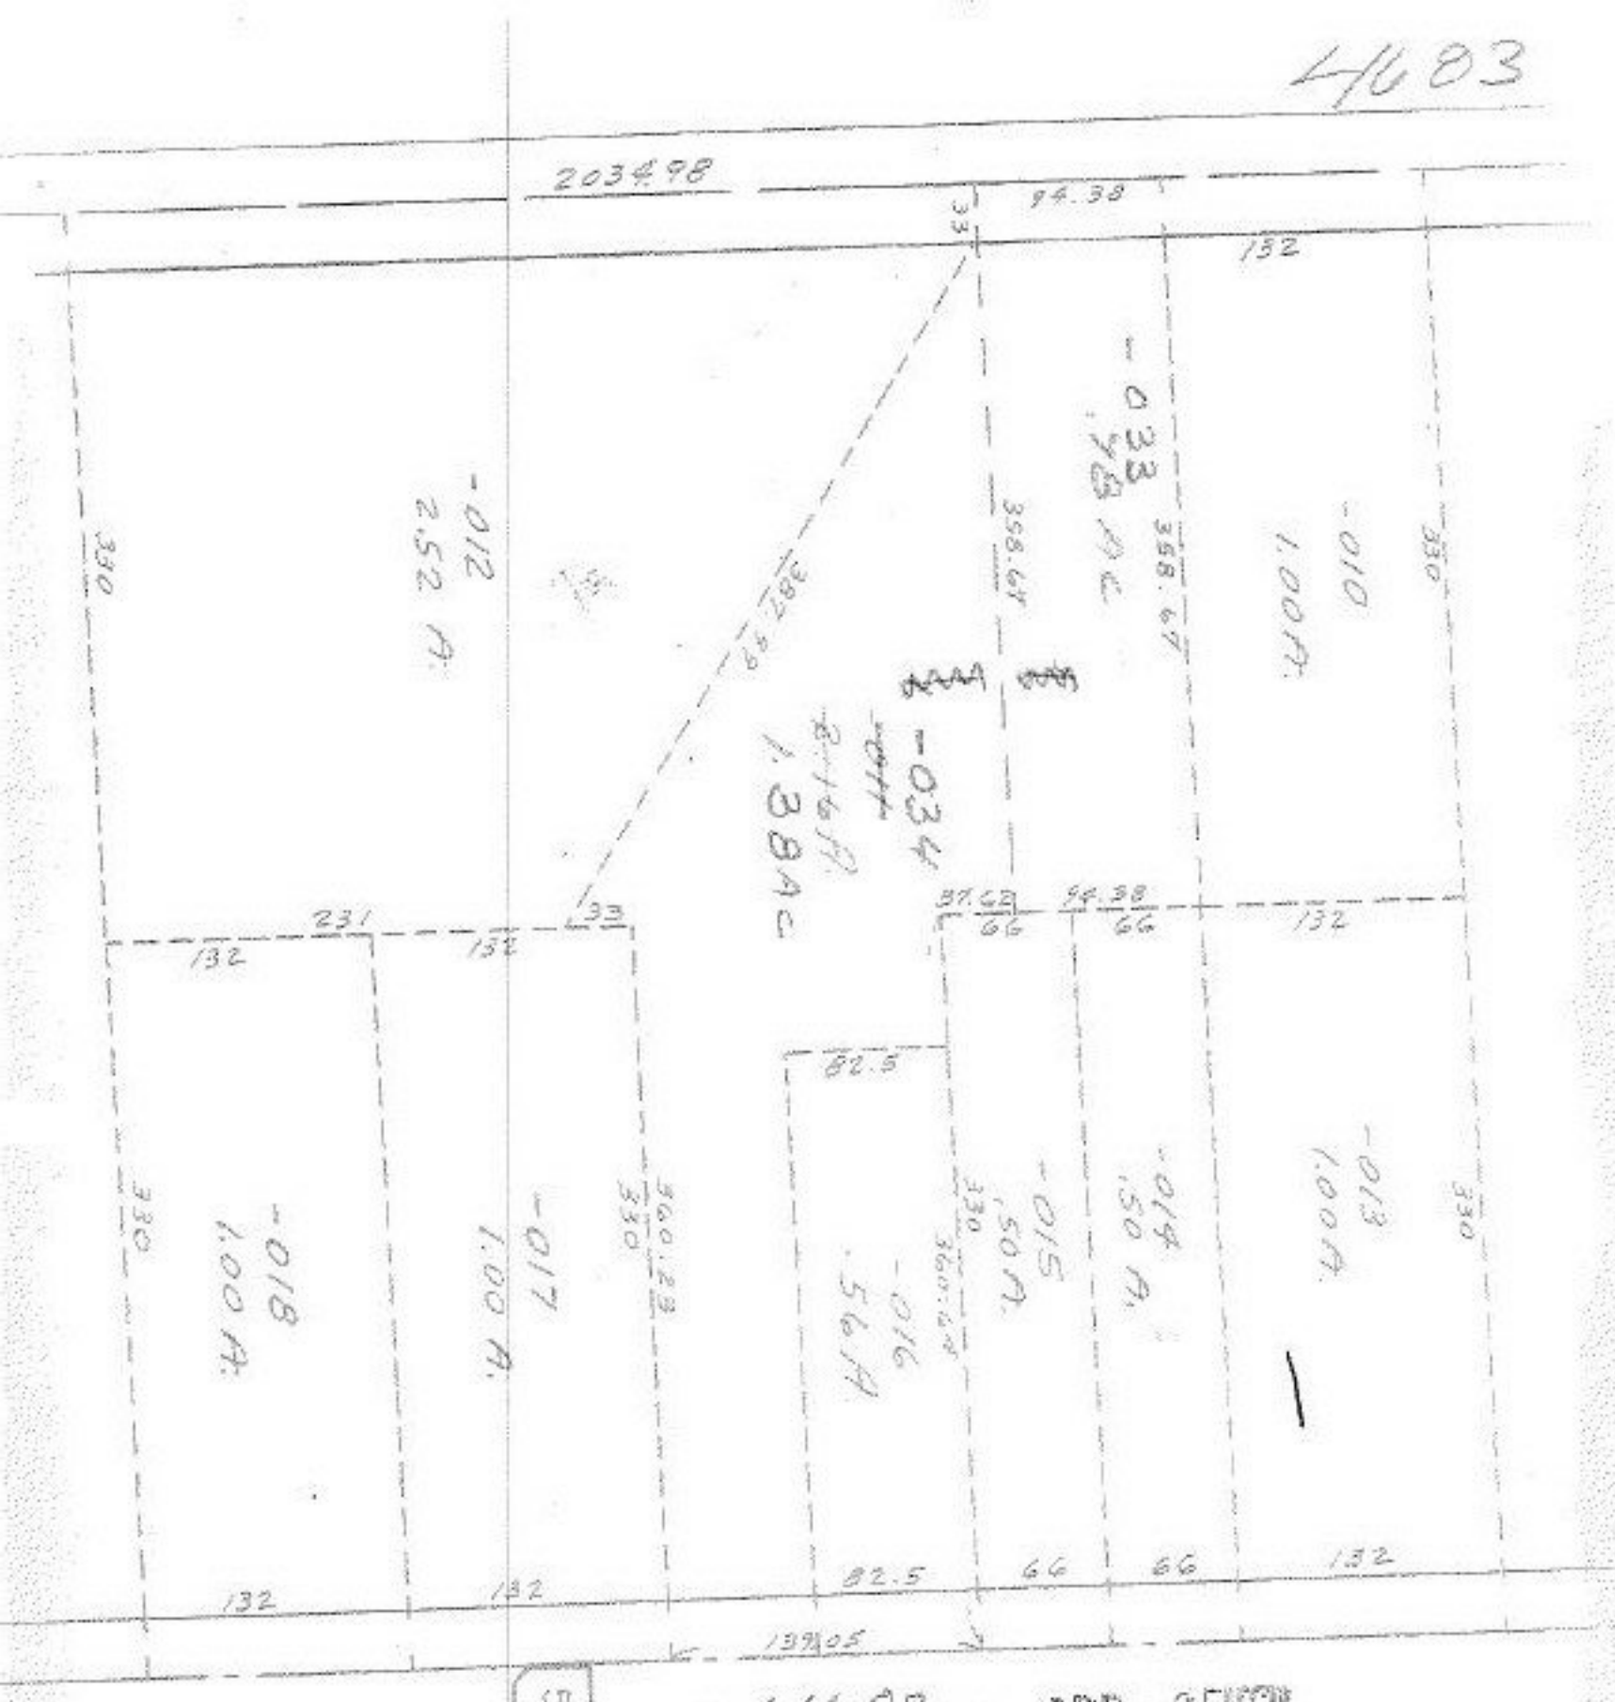
4683
203.98
94.38
33
132
-033
358.64'
358.64'
-010
1.00 A.
330
-012
2.52 A.
382.99'
-034
231
132
132
33
87.62
66
94.38
66
132
82.5
-018
1.00 A.
330'
-017
1.00 A.
330'
330'
-016
330'
-015
330'
-014
330'
-013
1.00 A.
330'
132
132
82.5
66
66
132
139.05
58
9-00-066-A
4683
APPROVED
LORAIN CO.
MAP DEPT.
DATE 2-22-71
9-00-065B
BY LW Hall
APR 6 ENTD
2-24-71
9-00-065B