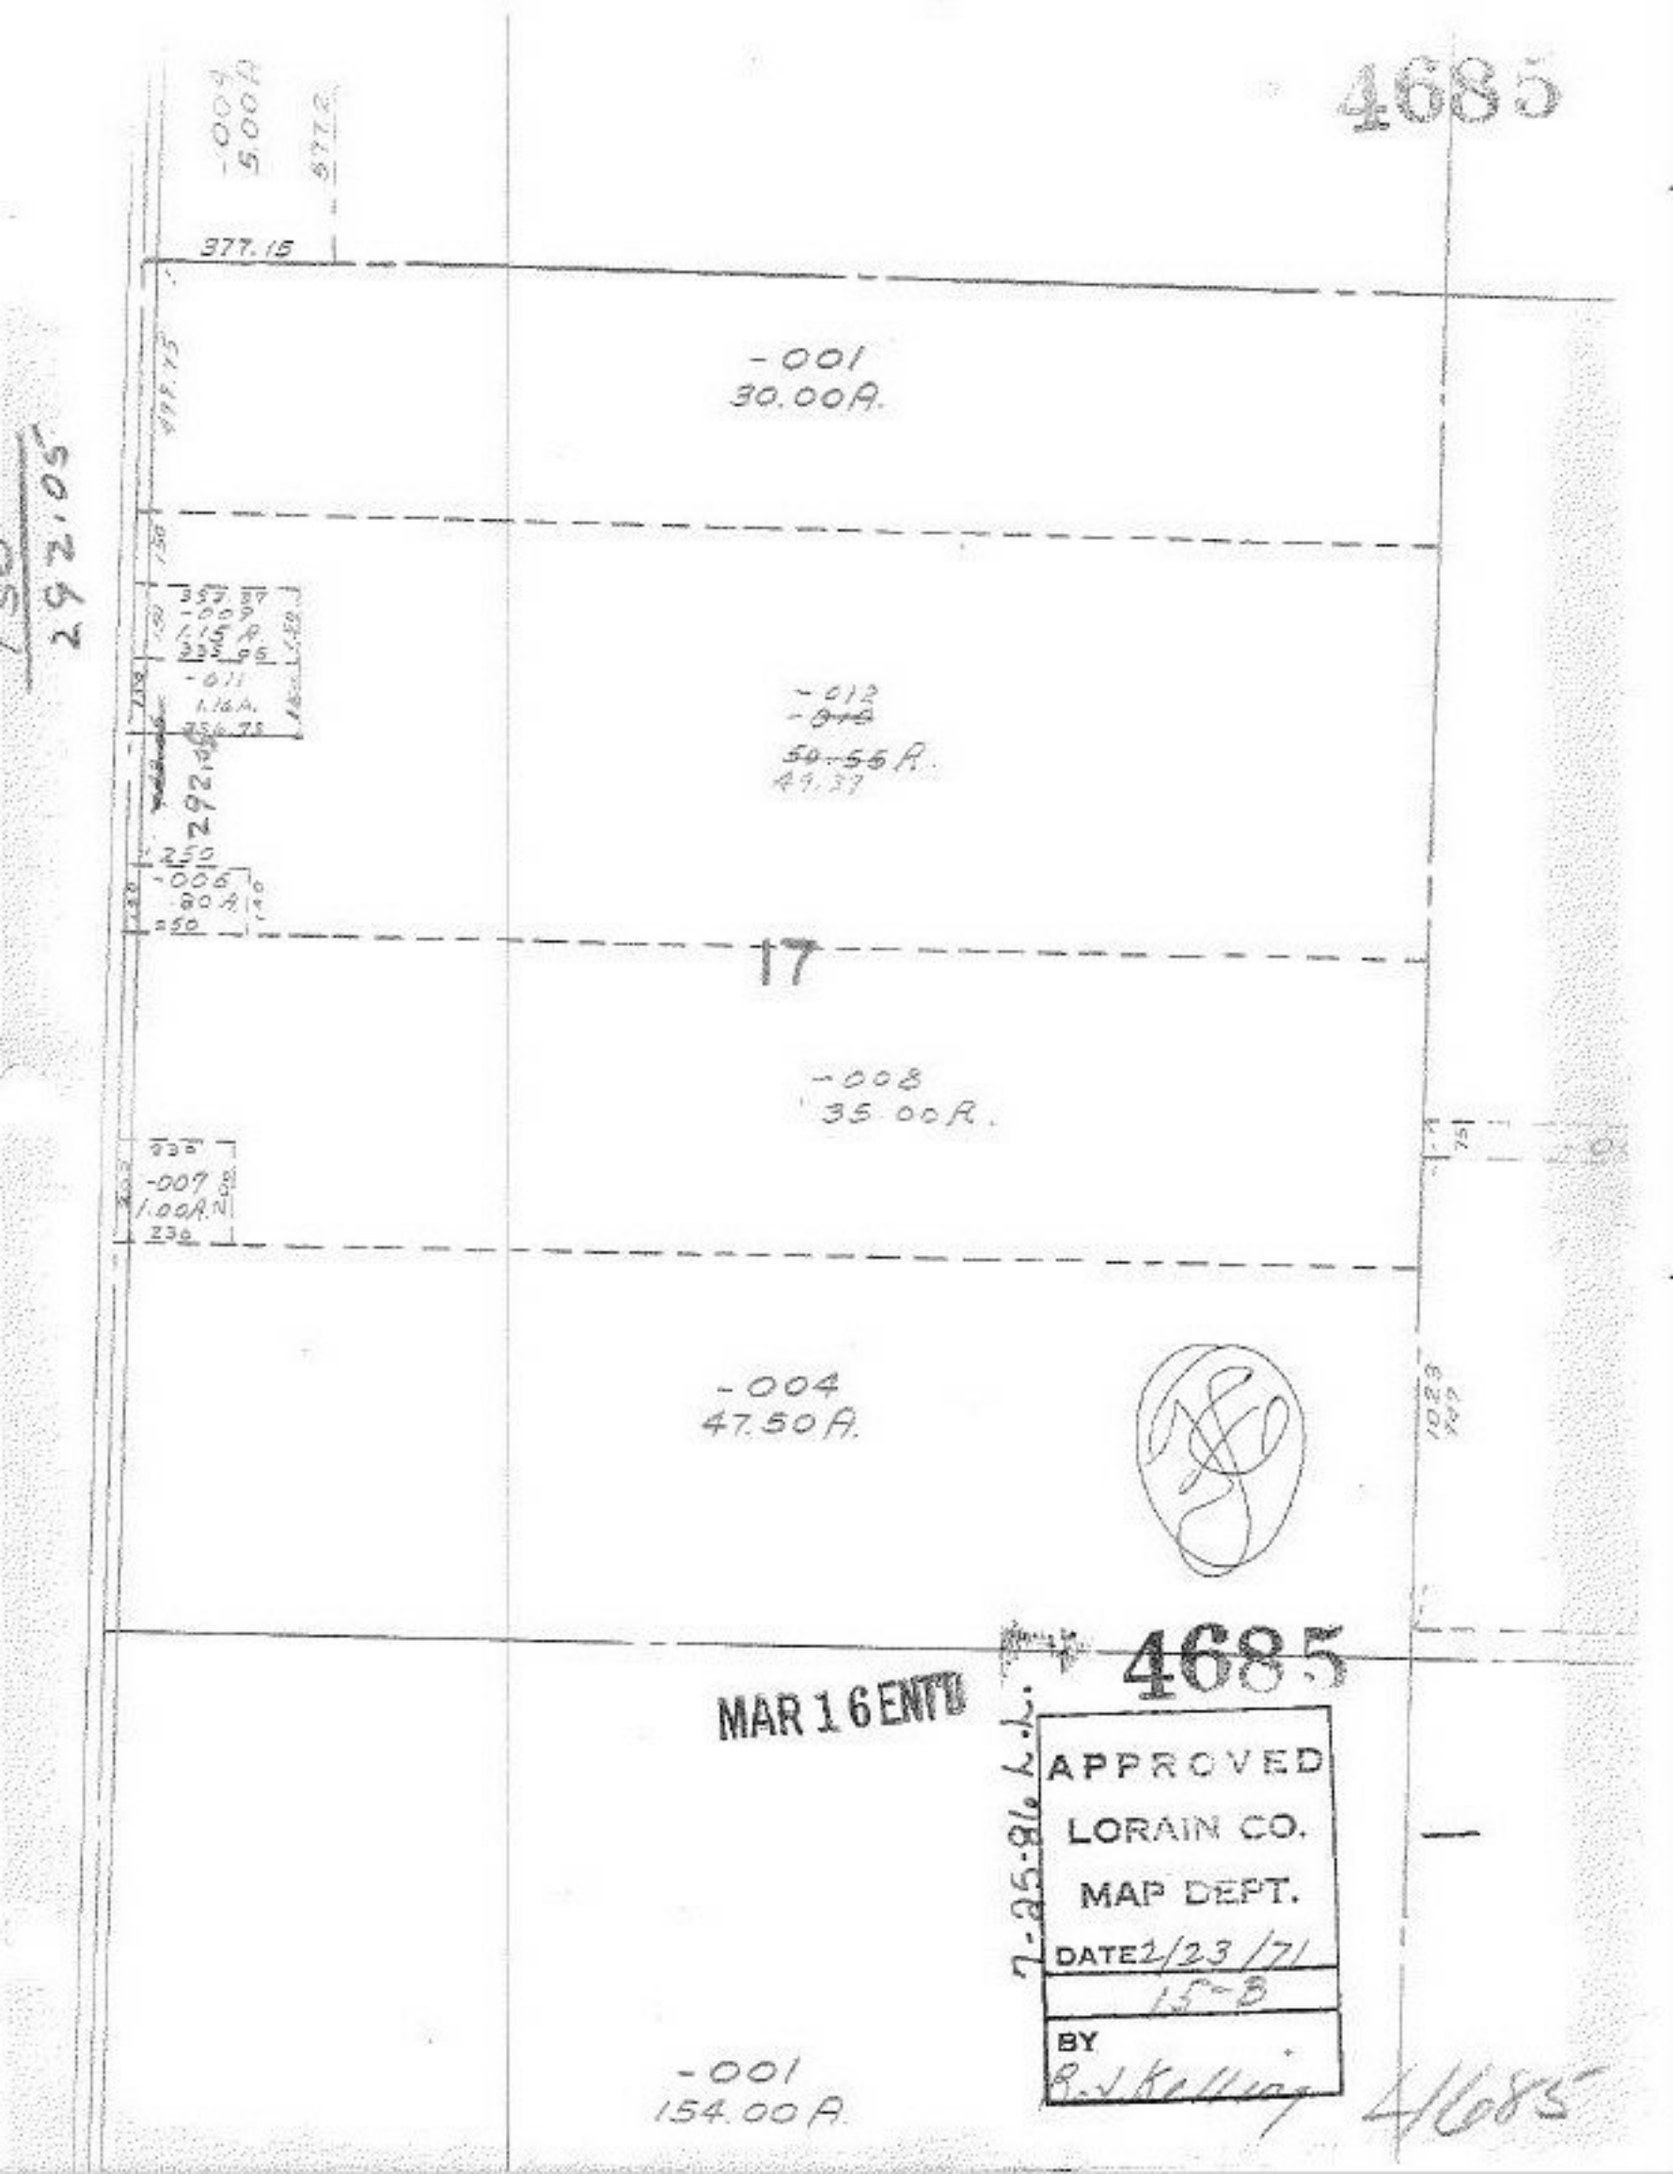
4685
-009
5.00A
377.2
377.15
-001
30.00A.
292.05
-009
1.15 A.
-011
1.16A.
-012
50.55 A.
49.37
292.05
-006
.80 A.
17
-008
35.00 A.
-007
1.00A.
-004
47.50 A.
4685
MAR 16 ENT'D
7-25-86 L.L.
APPROVED
LORAIN CO.
MAP DEPT.
DATE 2/23/71
15-B
BY
R. J. Kelling
-001
154.00 A.
4685