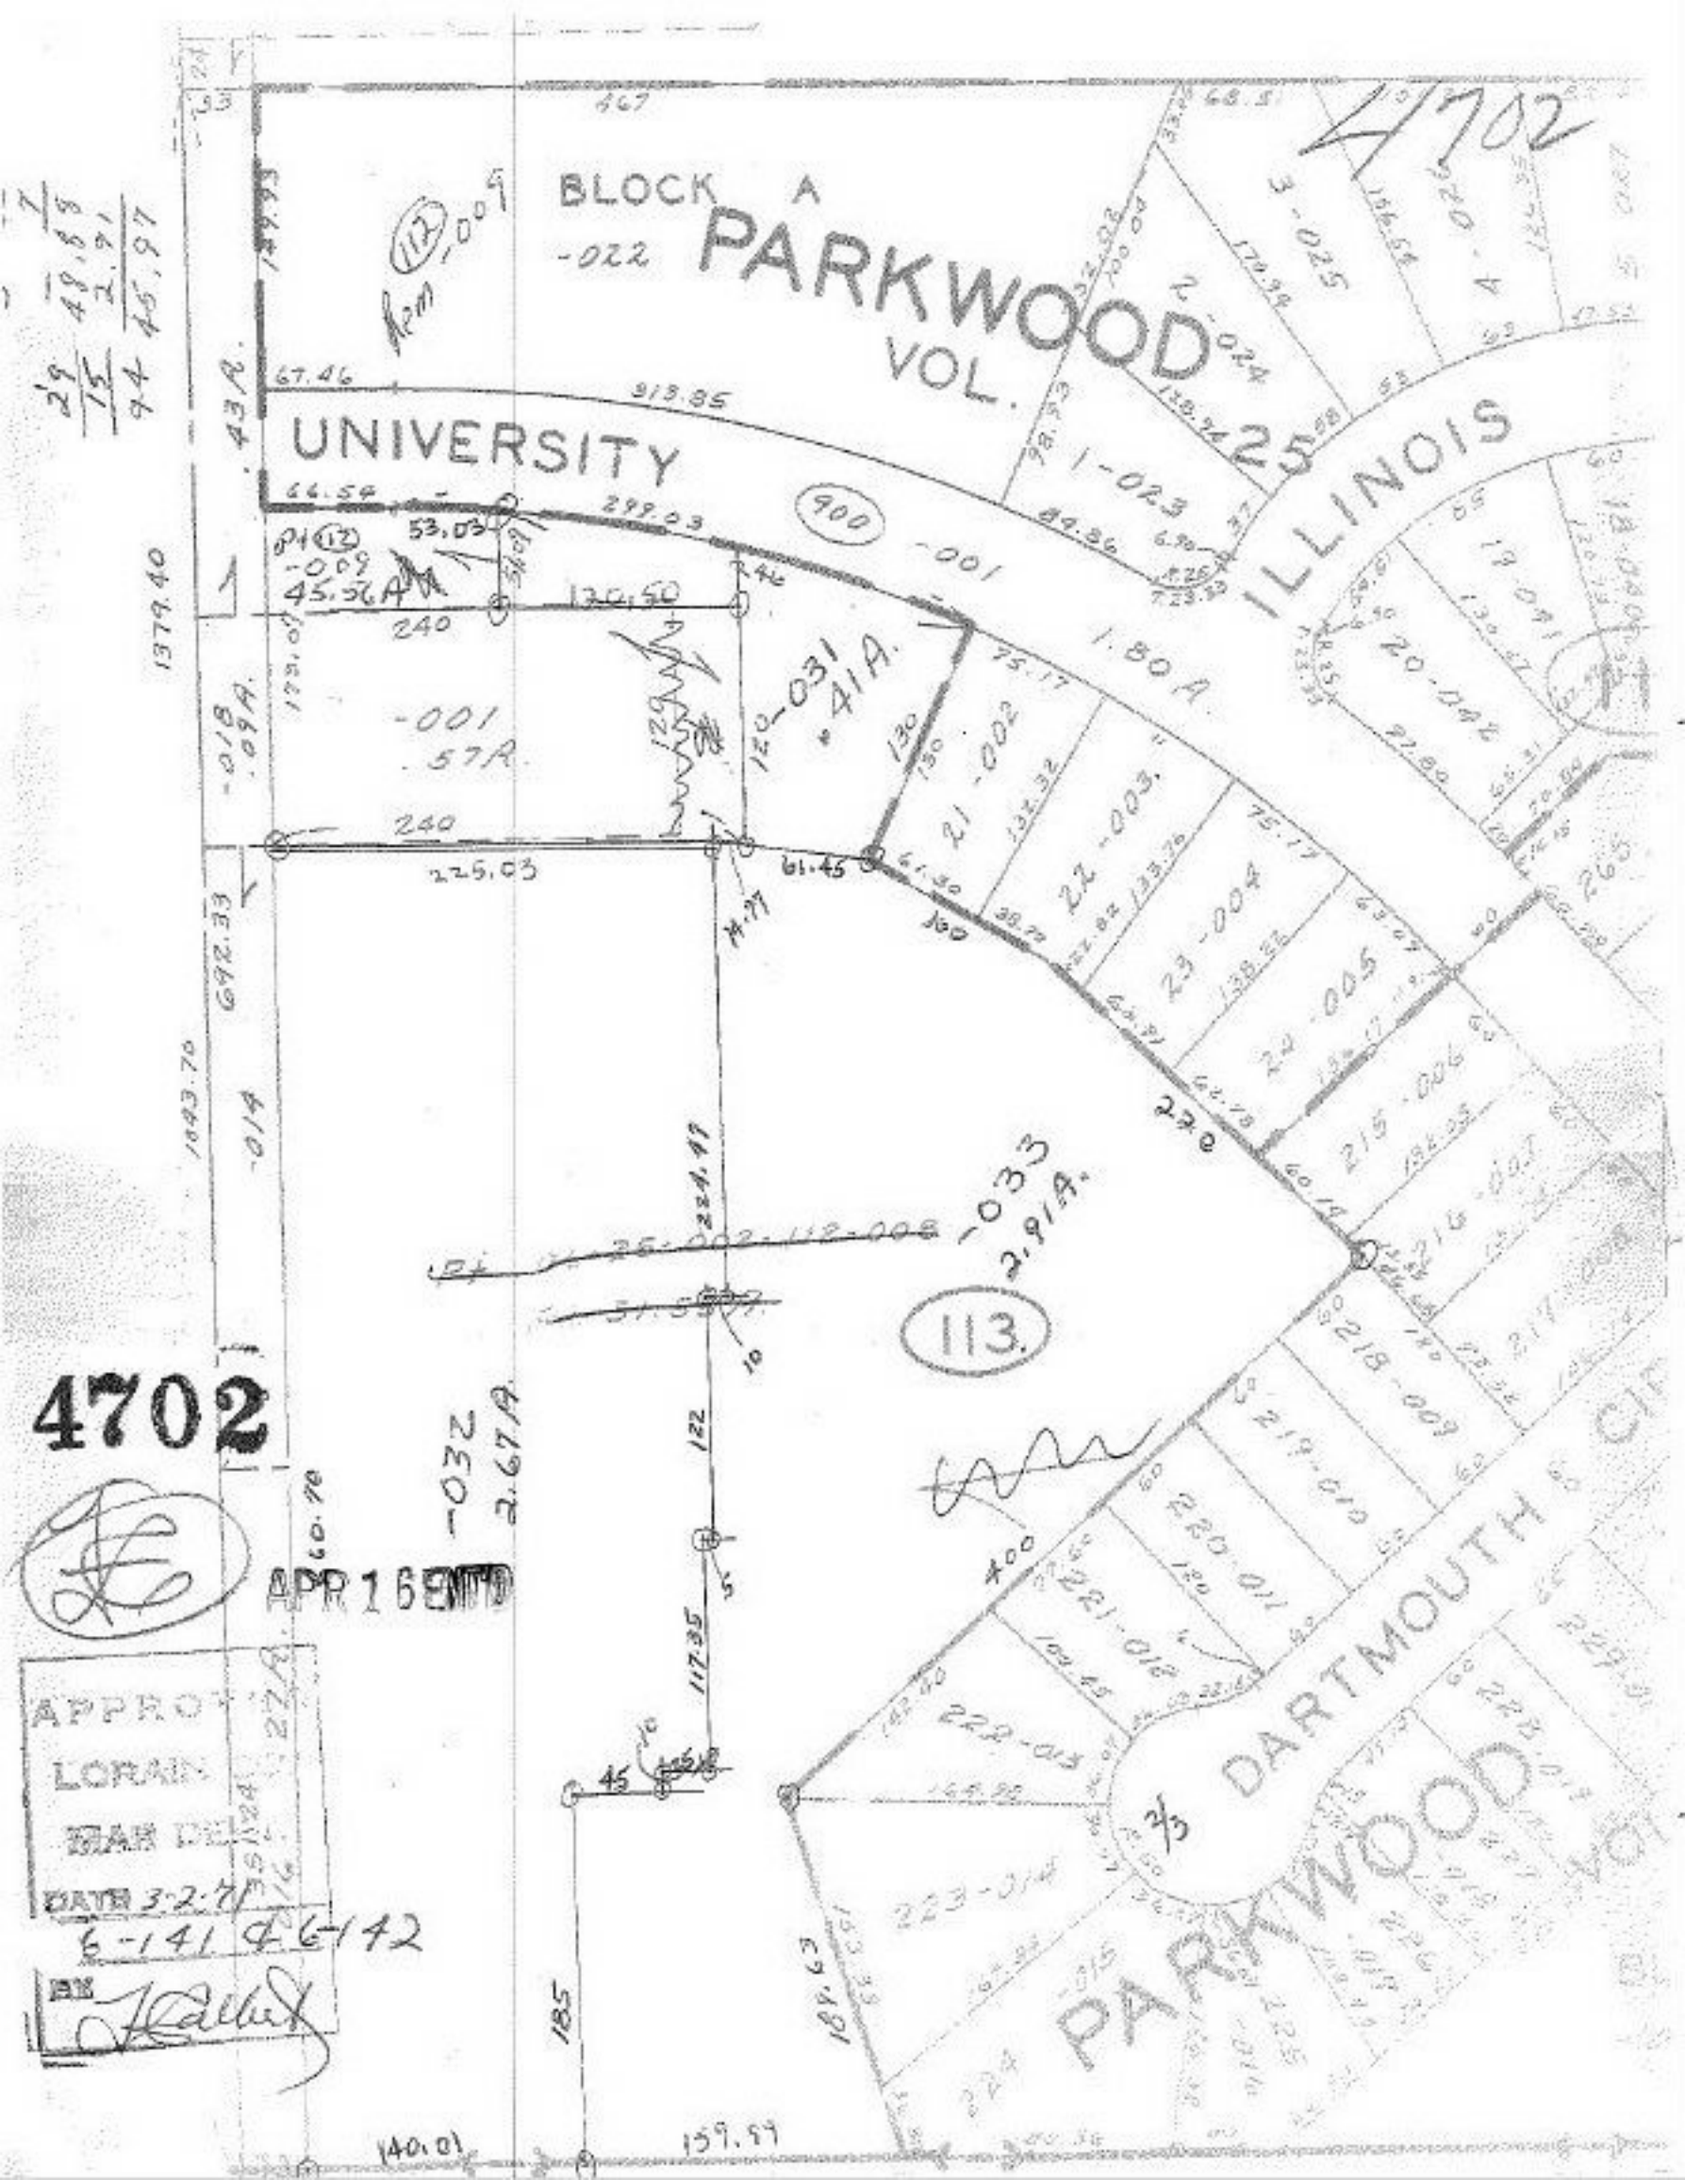
4702
BLOCK A
PARKWOOD
VOL. 25
UNIVERSITY
ILLINOIS
DARTMOUTH
PARKWOOD
-022
-009
-001
-031
.41A.
-001
.57A.
-033
2.91A.
-032
2.67A.
113.
900
1.80A.
1379.40
692.33
1043.70
225.03
61.45
140.01
159.99
4702
APR 16
APPROVED
LORAIN
MAR DEL
DATE 3-2-71
6-141 & 6-142
BY