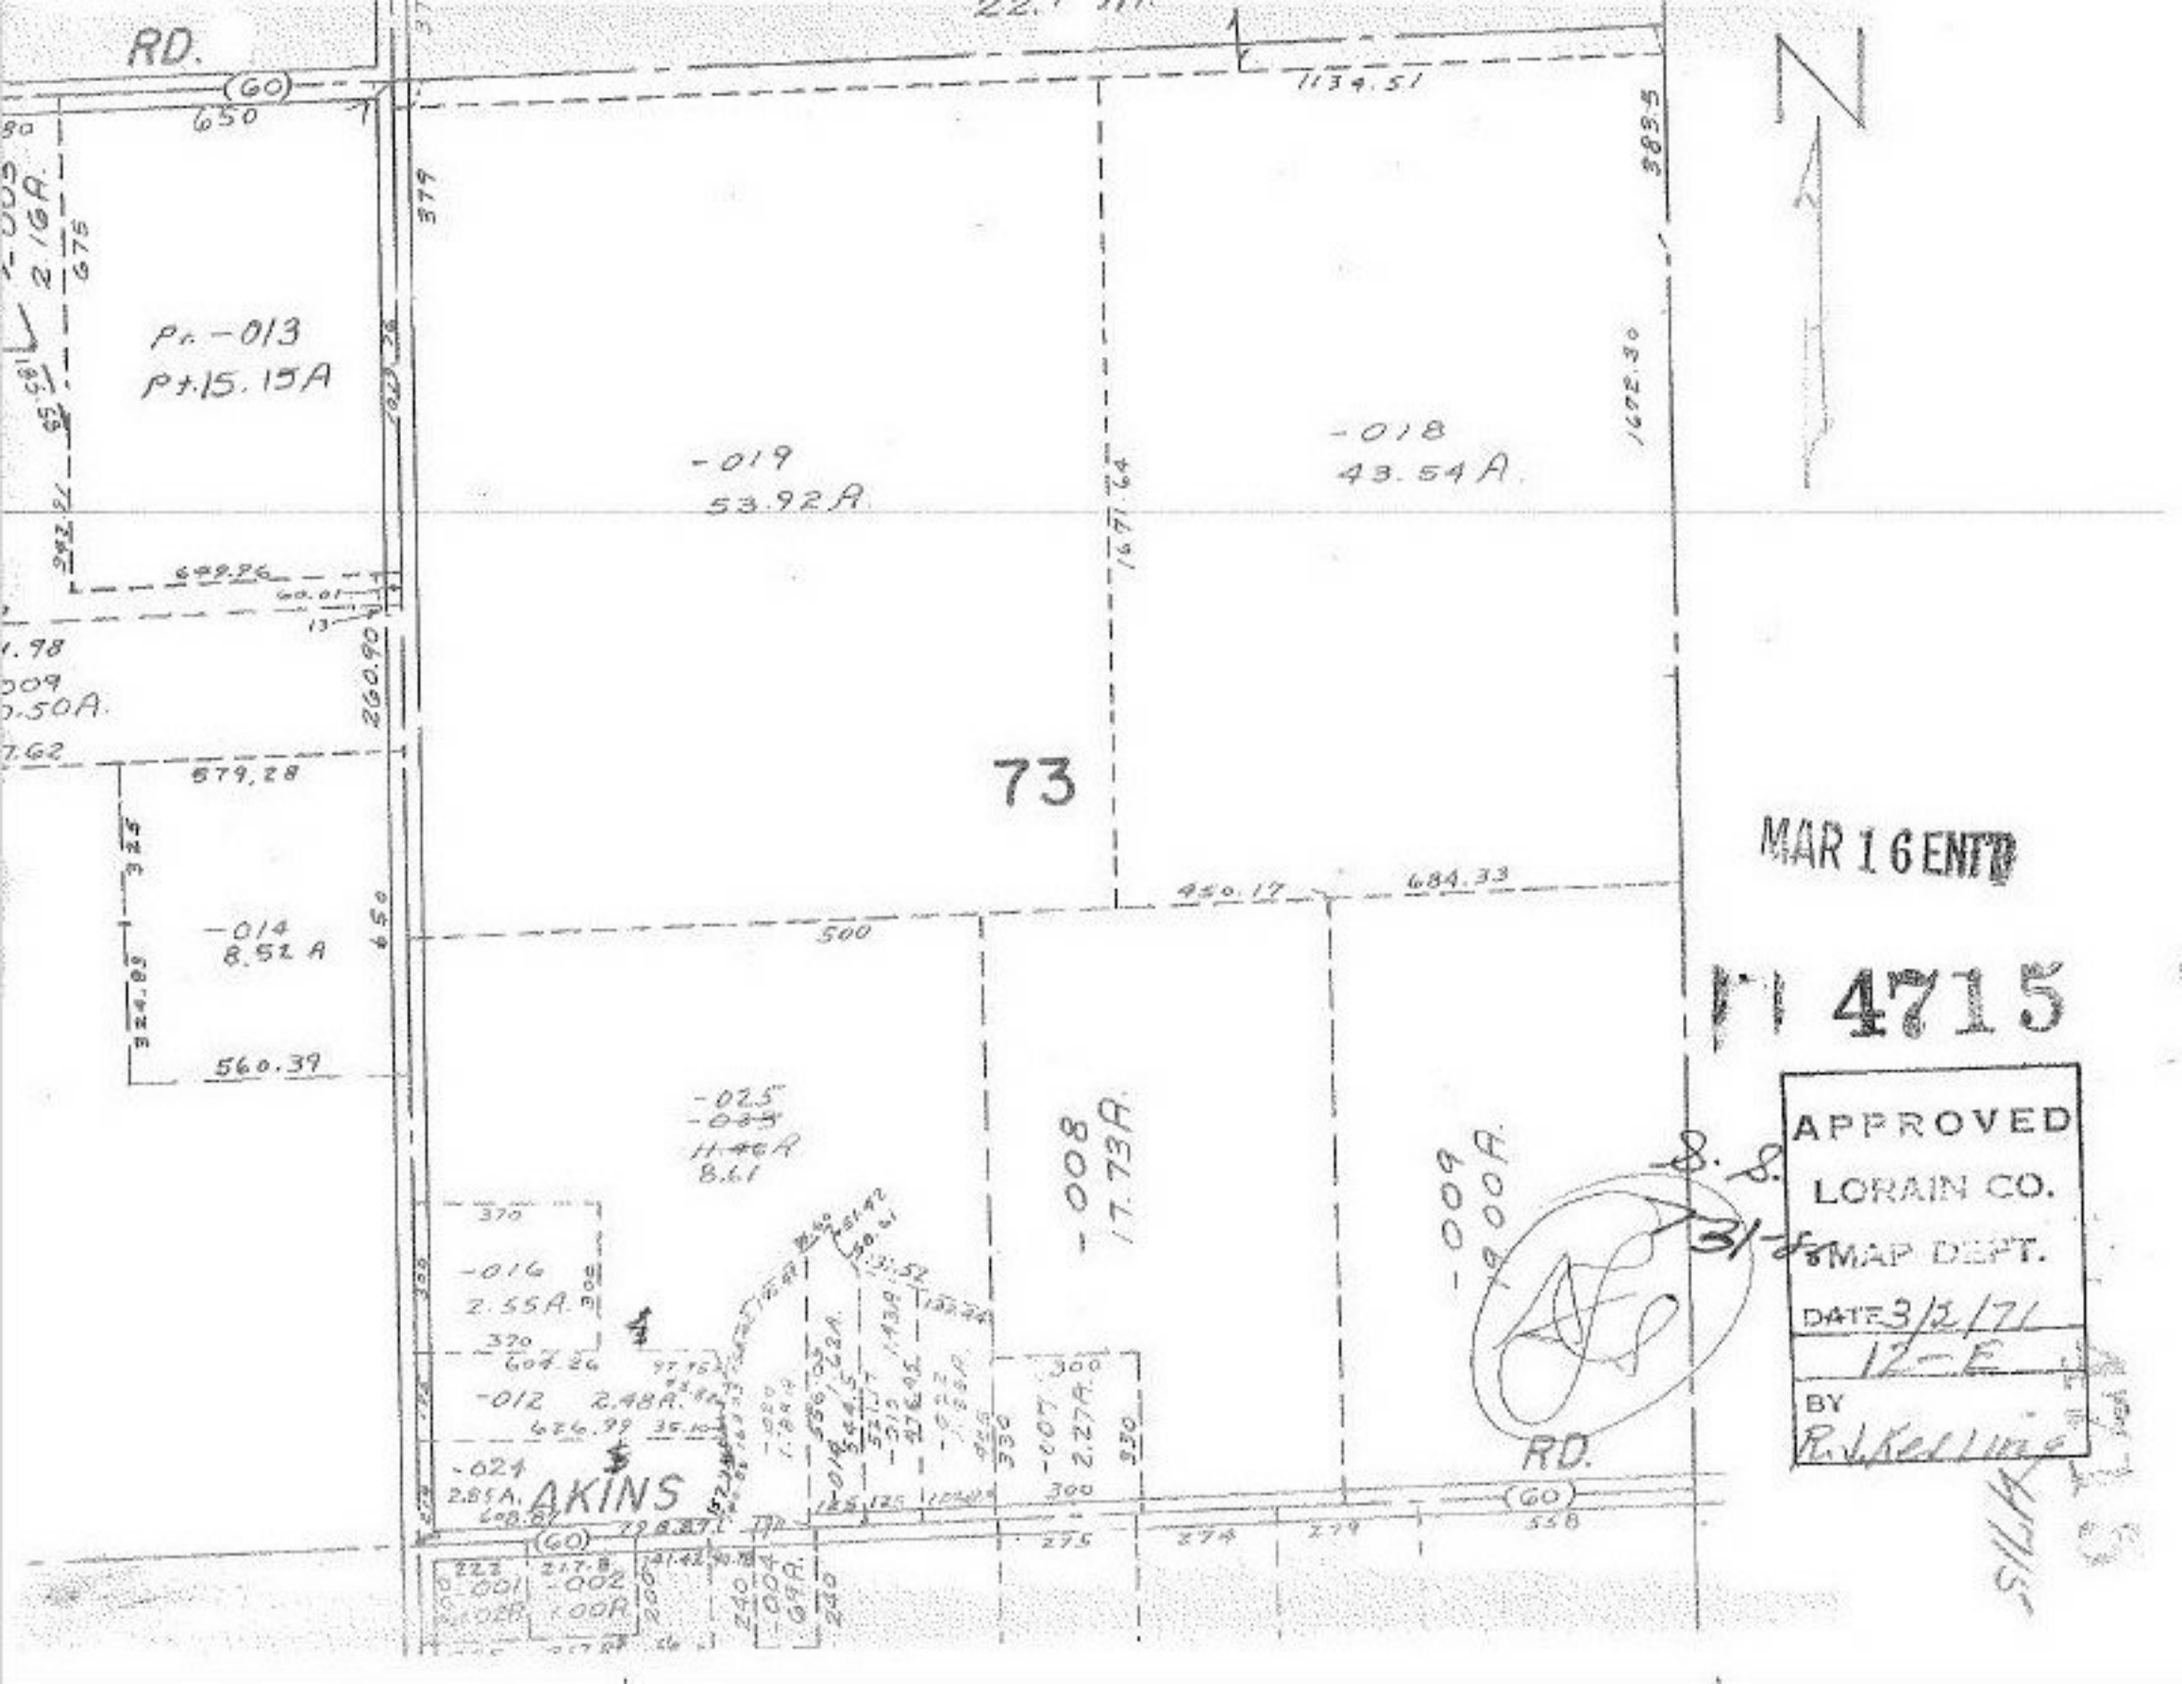
RD.
650
1134.51
Pt. -013
Pt. 15.15A
-019
53.92A
-018
43.54A
73
579.28
560.39
-014
8.52A
500
684.33
-025
-039
11.46A
8.61
-008
17.73A
-009
-010A.
-016
2.55A.
-012
2.48A.
-021
2.81A.
AKINS
-001
-002
-004
6.91A.
RD.
MAR 16 ENT'D
Pt 4715
APPROVED
LORAIN CO.
MAP DEPT.
DATE 3/2/71
12-E
BY
R.V. Kelline