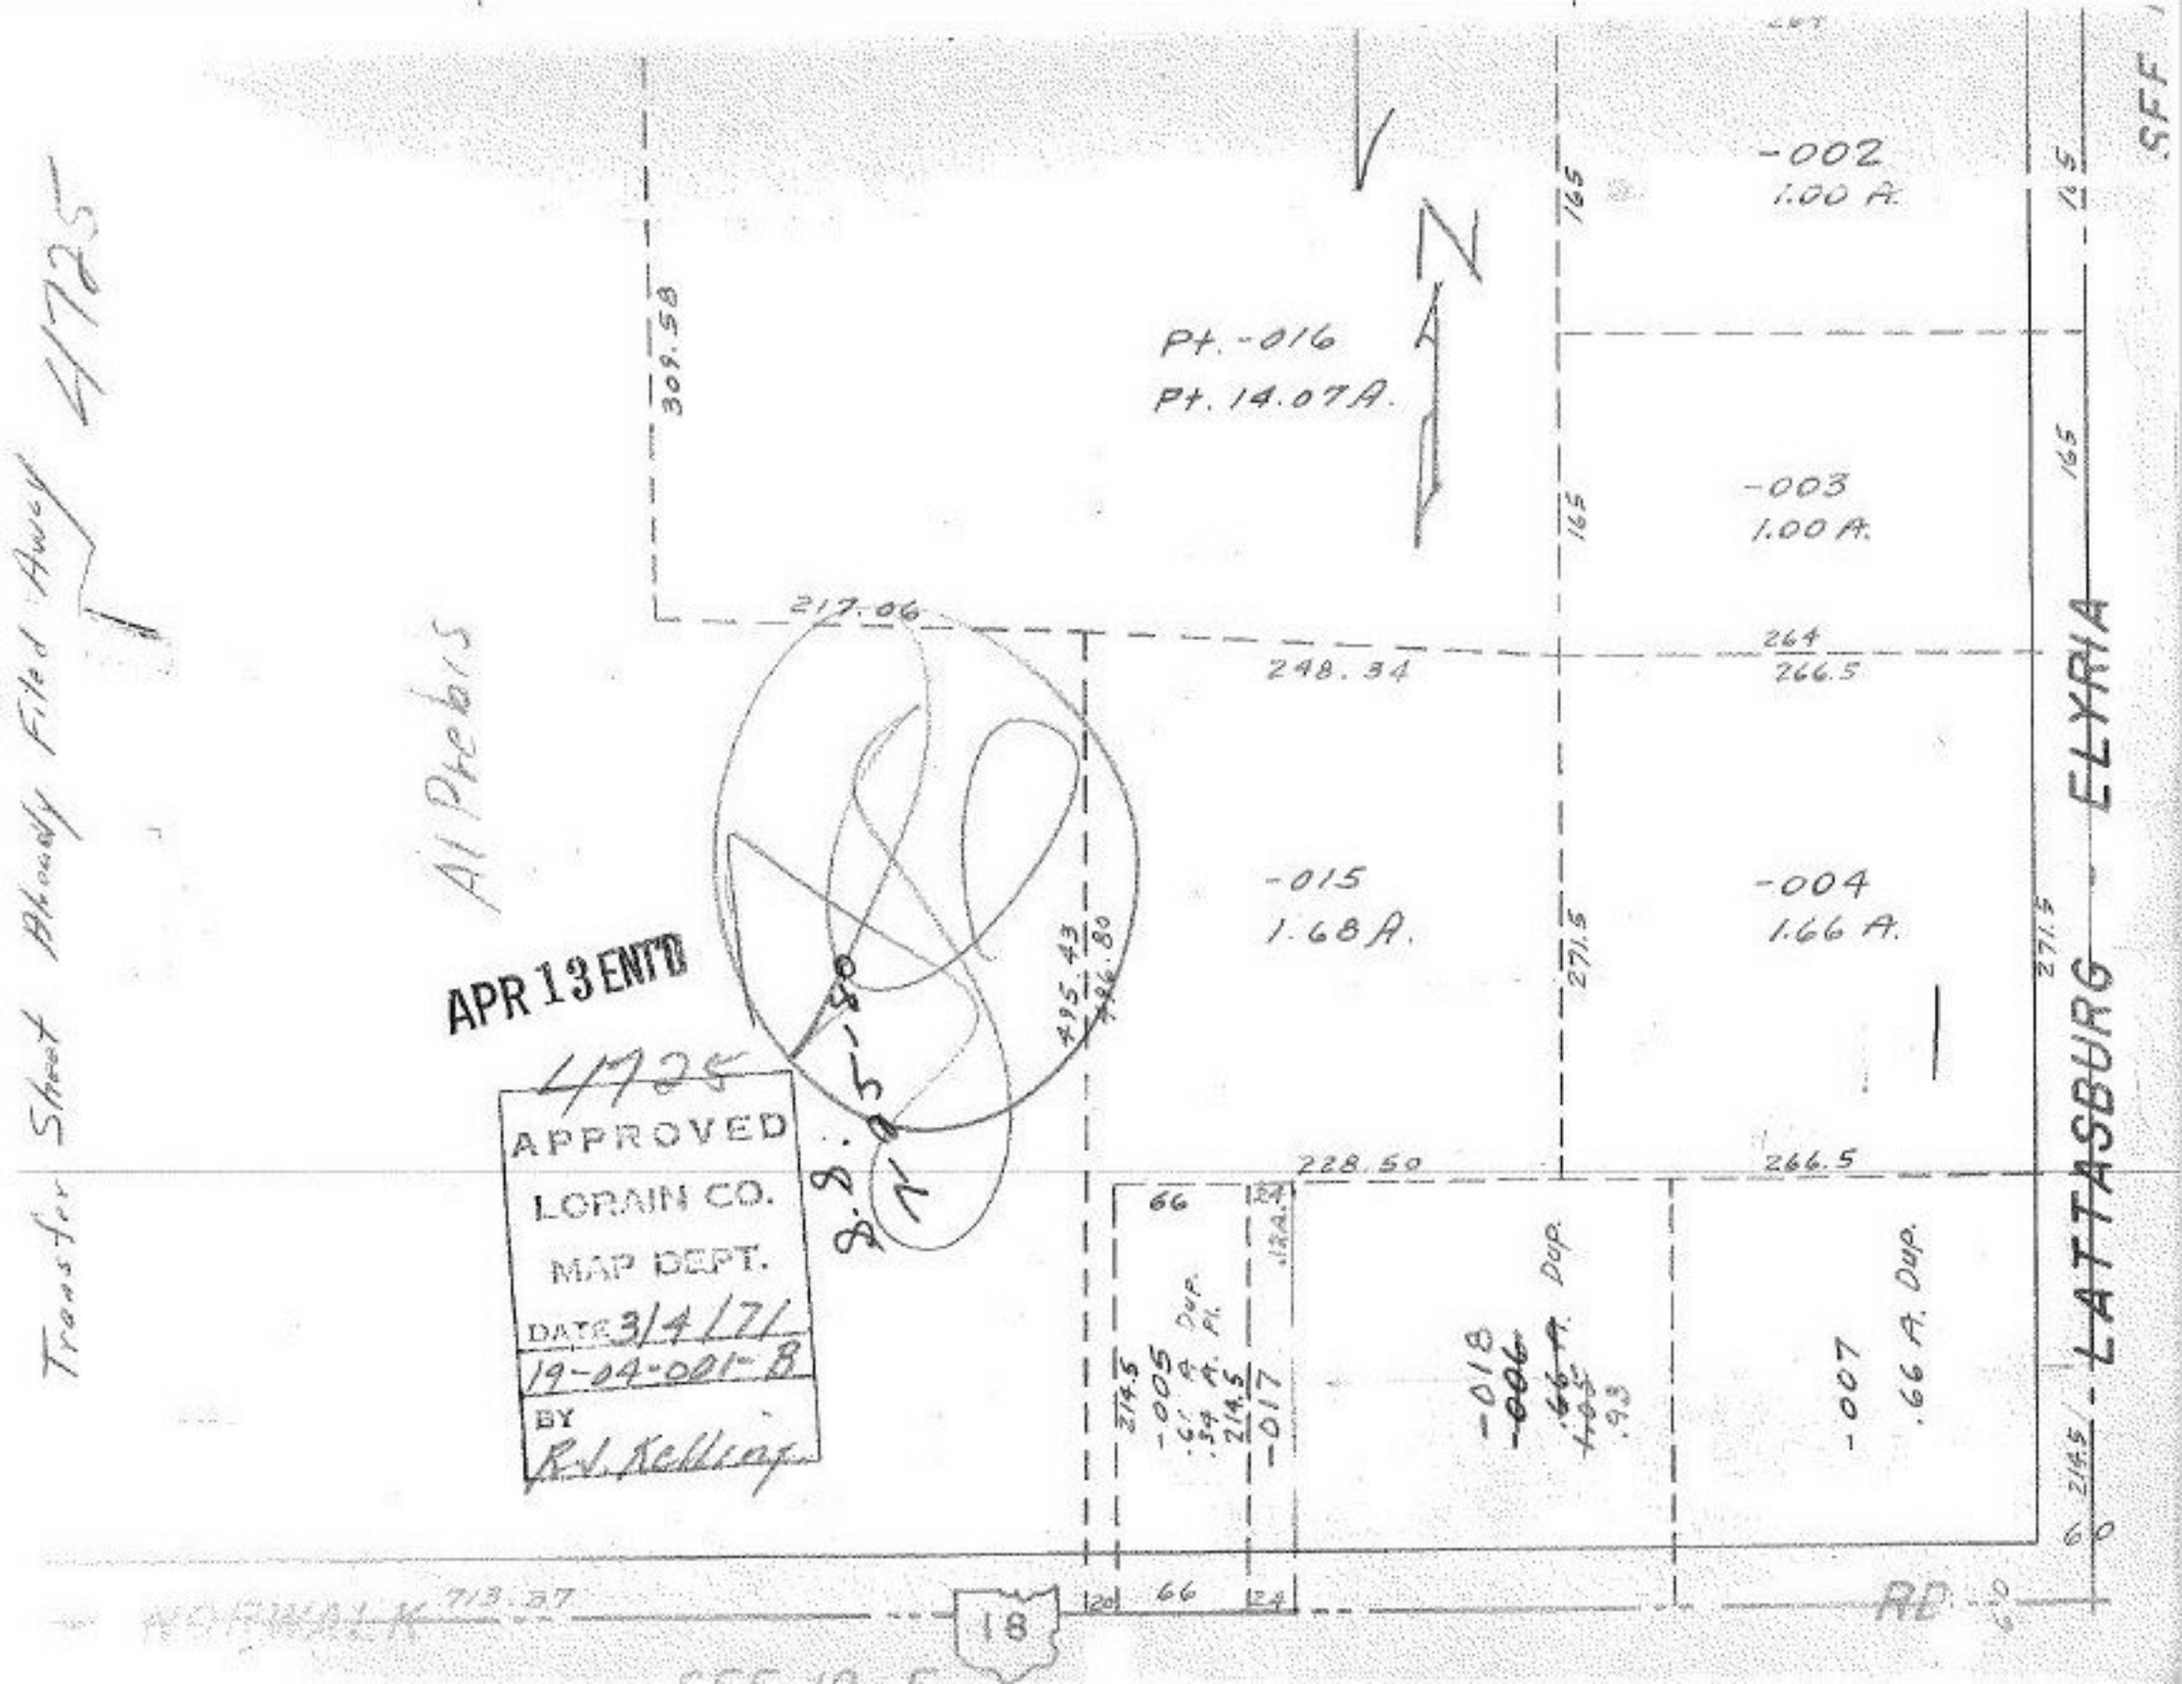
Al Prebis
APR 13 ENTD
APPROVED
LORAIN CO.
MAP DEPT.
DATE 3/4/71
19-04-001-B
BY
R.V. Kellogg
309.58
Pt. -016
Pt. 14.07 A.
-002
1.00 A.
-003
1.00 A.
-015
1.68 A.
-004
1.66 A.
217.06
248.34
264
266.5
165
271.5
415.43
426.80
8.8
11.25
228.50
266.5
66
214.5
-005
.61 A.
.54 A. Dup. Pt.
-017
-018
-006
.66 A. Dup.
.93
-007
.66 A. Dup.
LATTASBURG ELYRIA
713.57
18
RD.