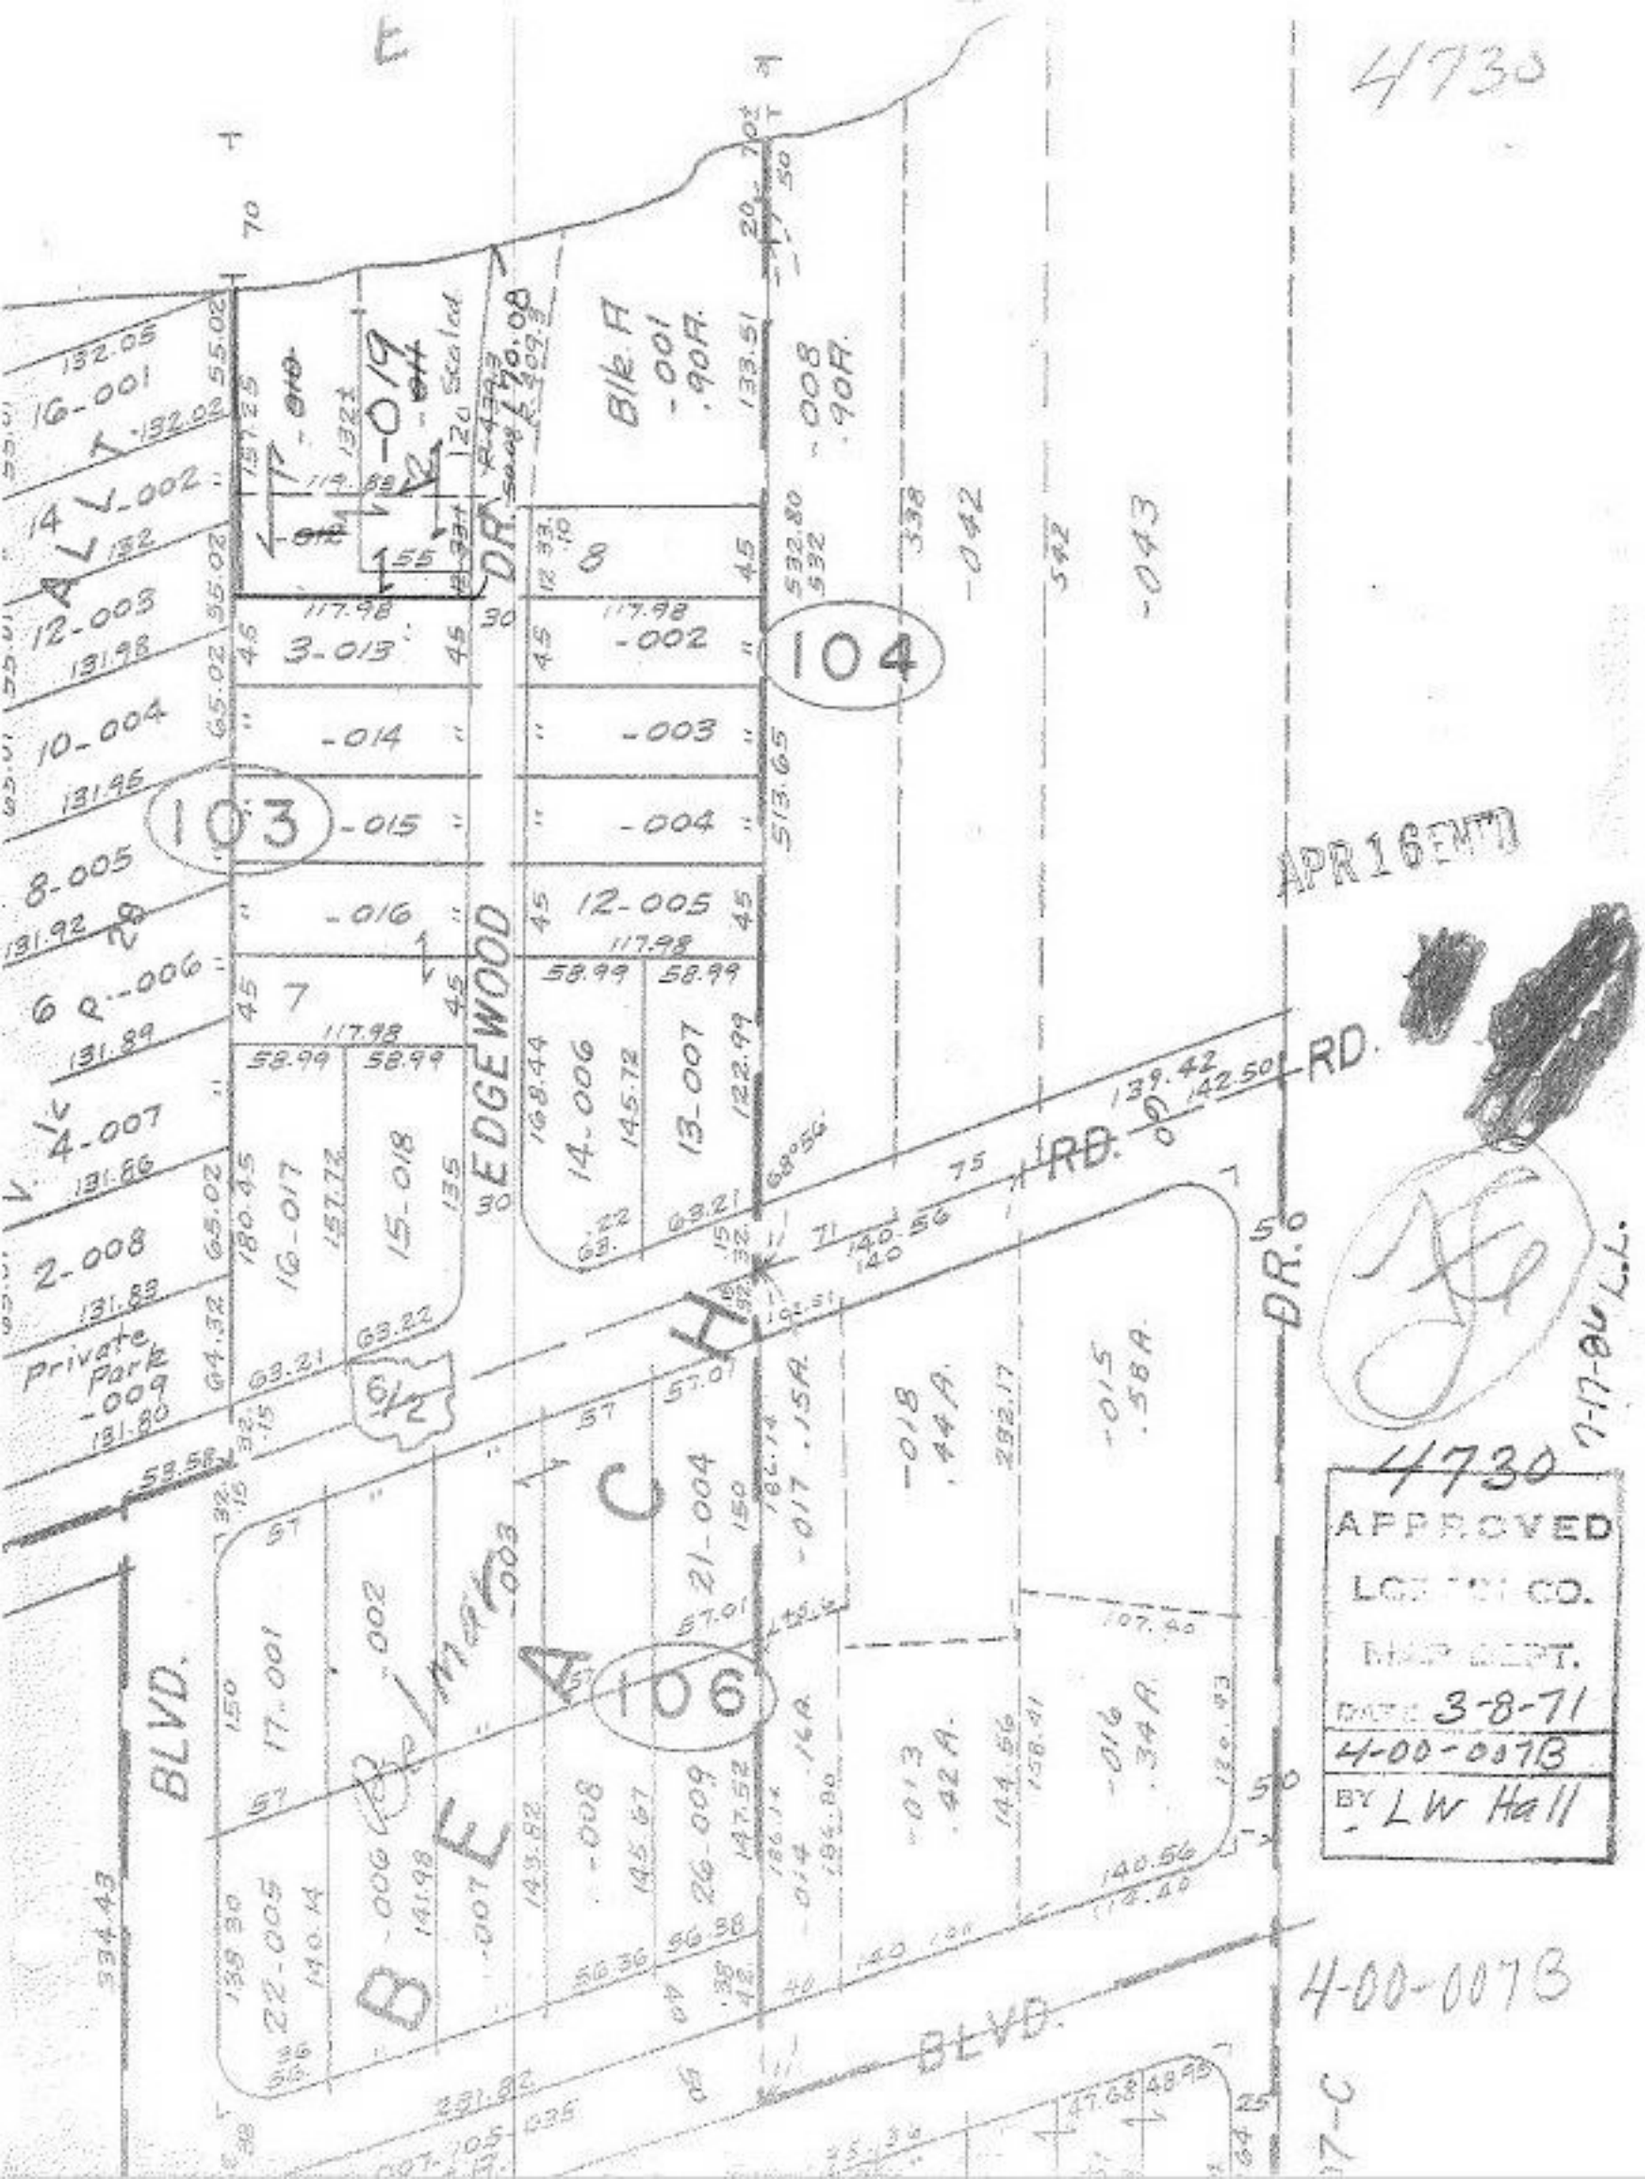
4730
APR 16 ENTD
4730
APPROVED
MAP DEPT.
DATE 3-8-71
4-00-007B
BY LW Hall
4-00-007B
7-17-84 L.L.
BEACH
BLVD.
EDGEWOOD DR.
RD.
DR.
104
103
106
Private Park -009
Blk. A
-001 .90A.
-008 .90A.
-042
-043
-018 .44A.
-015 .58A.
-013 .42A.
-016 .34A.
-017 .15A.
-019
-014
-016
-015
-004
-003
-002
-001
-008
-007
-006
-005
-004
-003
-002
-001
16-001
14-002
12-003
10-004
8-005
6-006
4-007
2-008
3-013
12-005
13-007
14-006
15-018
16-017
17-001
21-004
22-005
26-009
7-C