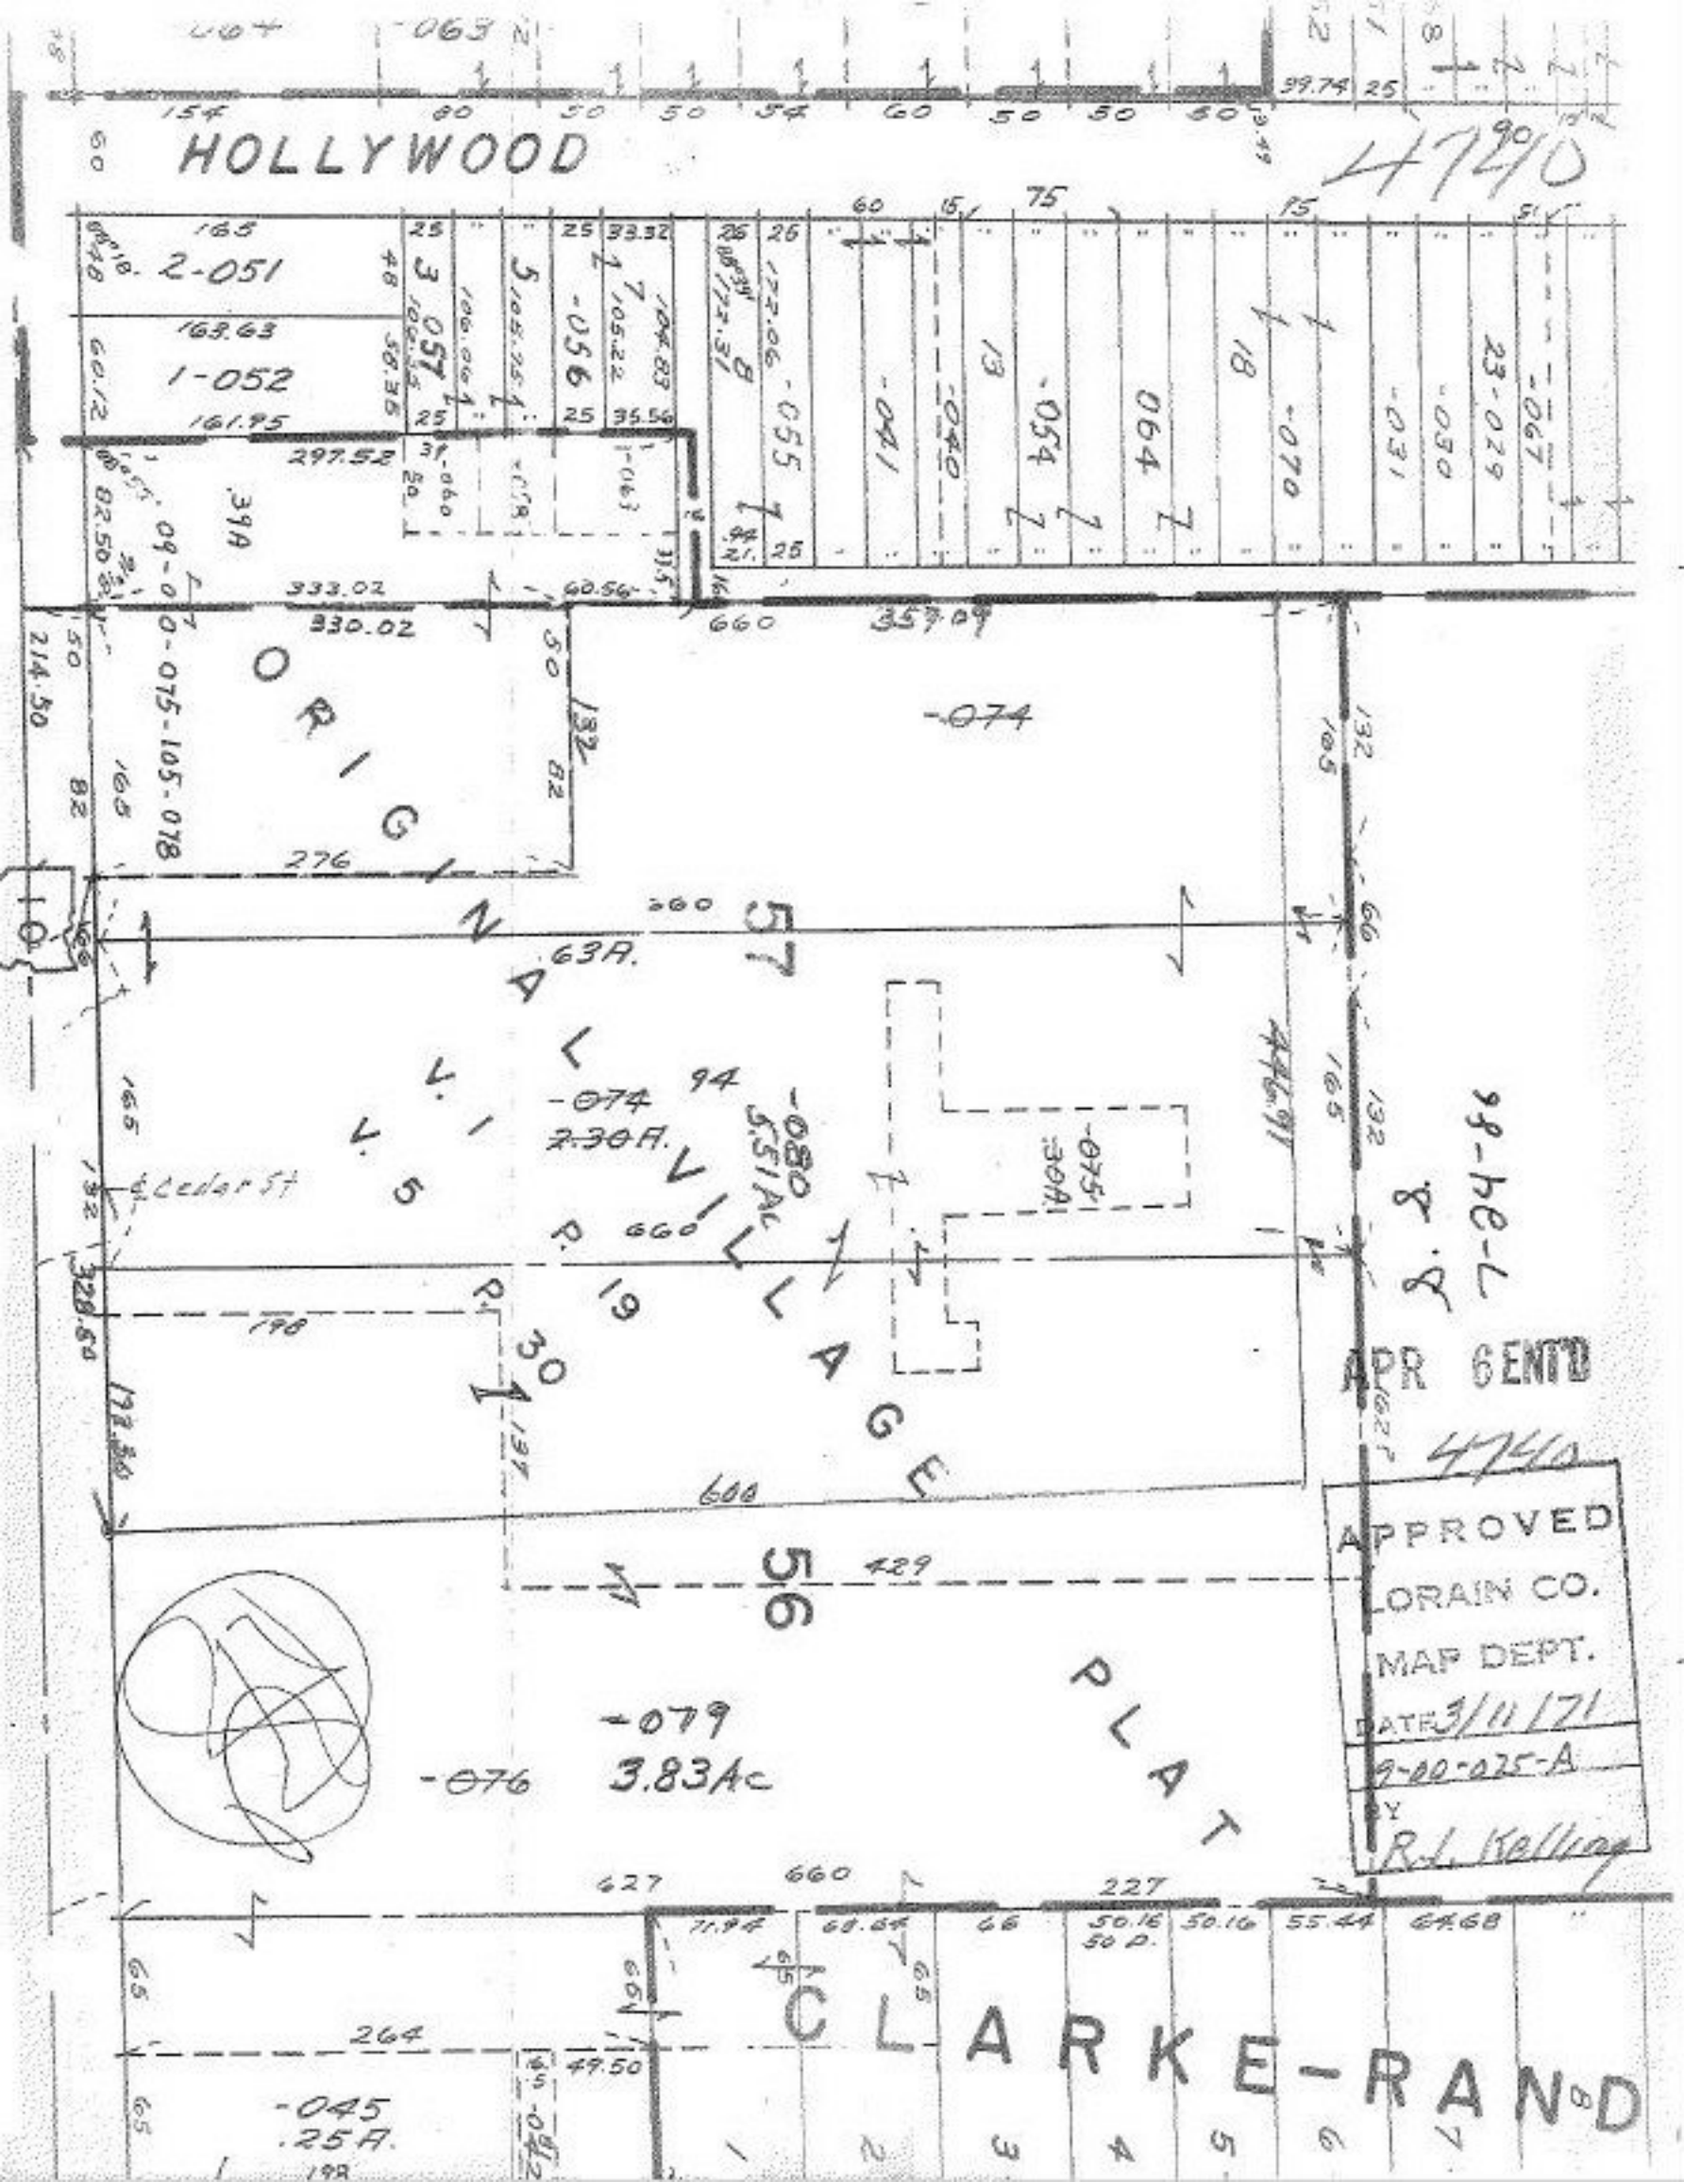
HOLLYWOOD
4720
4740
ORIGINAL VILLAGE
P. 19
P. 30
P. 98-7
4PR 6ENTD
4740
APPROVED
LORAIN CO.
MAP DEPT.
DATE 3/11/71
9-00-025-A
BY R.L. Kellogg
CLARKE-RAND
PLAT
-051
-056
-055
-041
-040
-054
-070
-050
-031
-067
-074
-080
-075
-079
-076
-045
.25A.
3.83Ac
7.30A.
63A.
39A
1-052
2-051
3-057
4 Cedar St