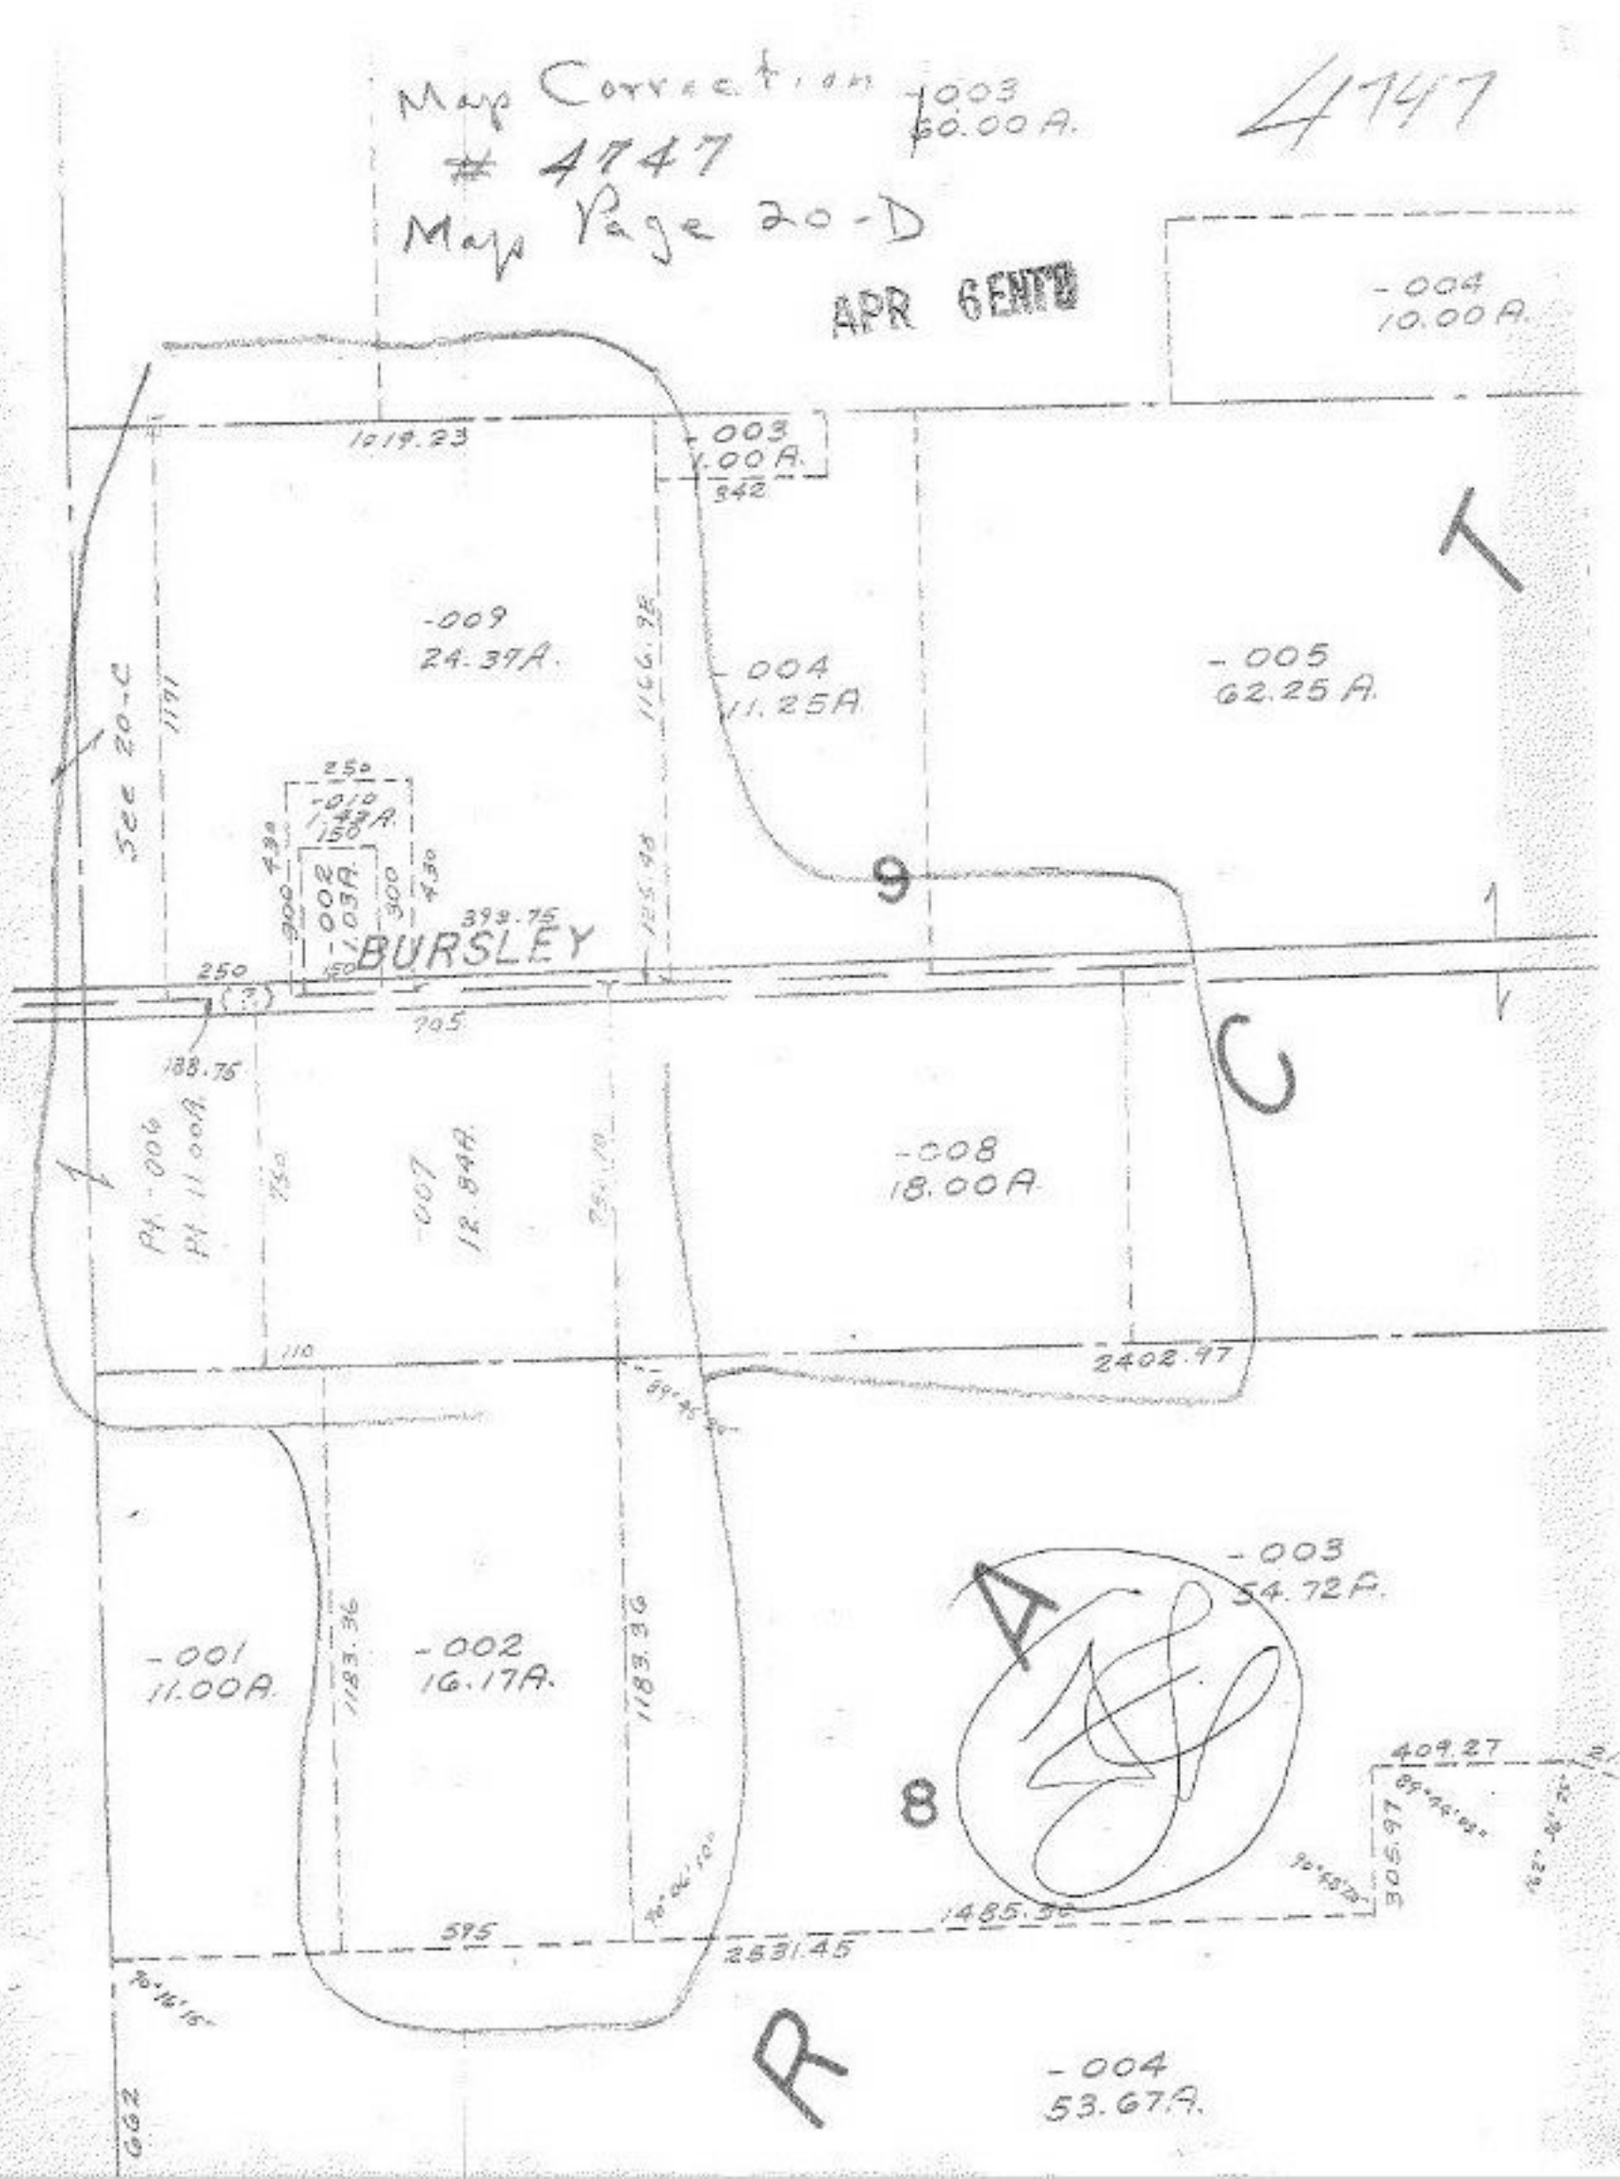
Map Correction
4747
Map Page 20-D
4747
APR 6 ENT'D
-003
60.00 A.
-004
10.00 A.
1019.23
-003
1.00 A.
342
-009
24.37 A.
1166.98
-004
11.25 A.
-005
62.25 A.
See 20-C
1171
250
-010
1.43 A.
150
430
300
-002
1.03 A.
300
430
393.75
BURSLEY
125.48
9
250
(?)
705
188.75
C
Pt. -006
Pt. 11.00 A.
750
-007
12.84 A.
-008
18.00 A.
110
2402.97
-003
54.72 A.
A
-001
11.00 A.
1183.36
-002
16.17 A.
1183.36
8
409.27
305.97
1485.36
595
2531.45
R
-004
53.67 A.
662