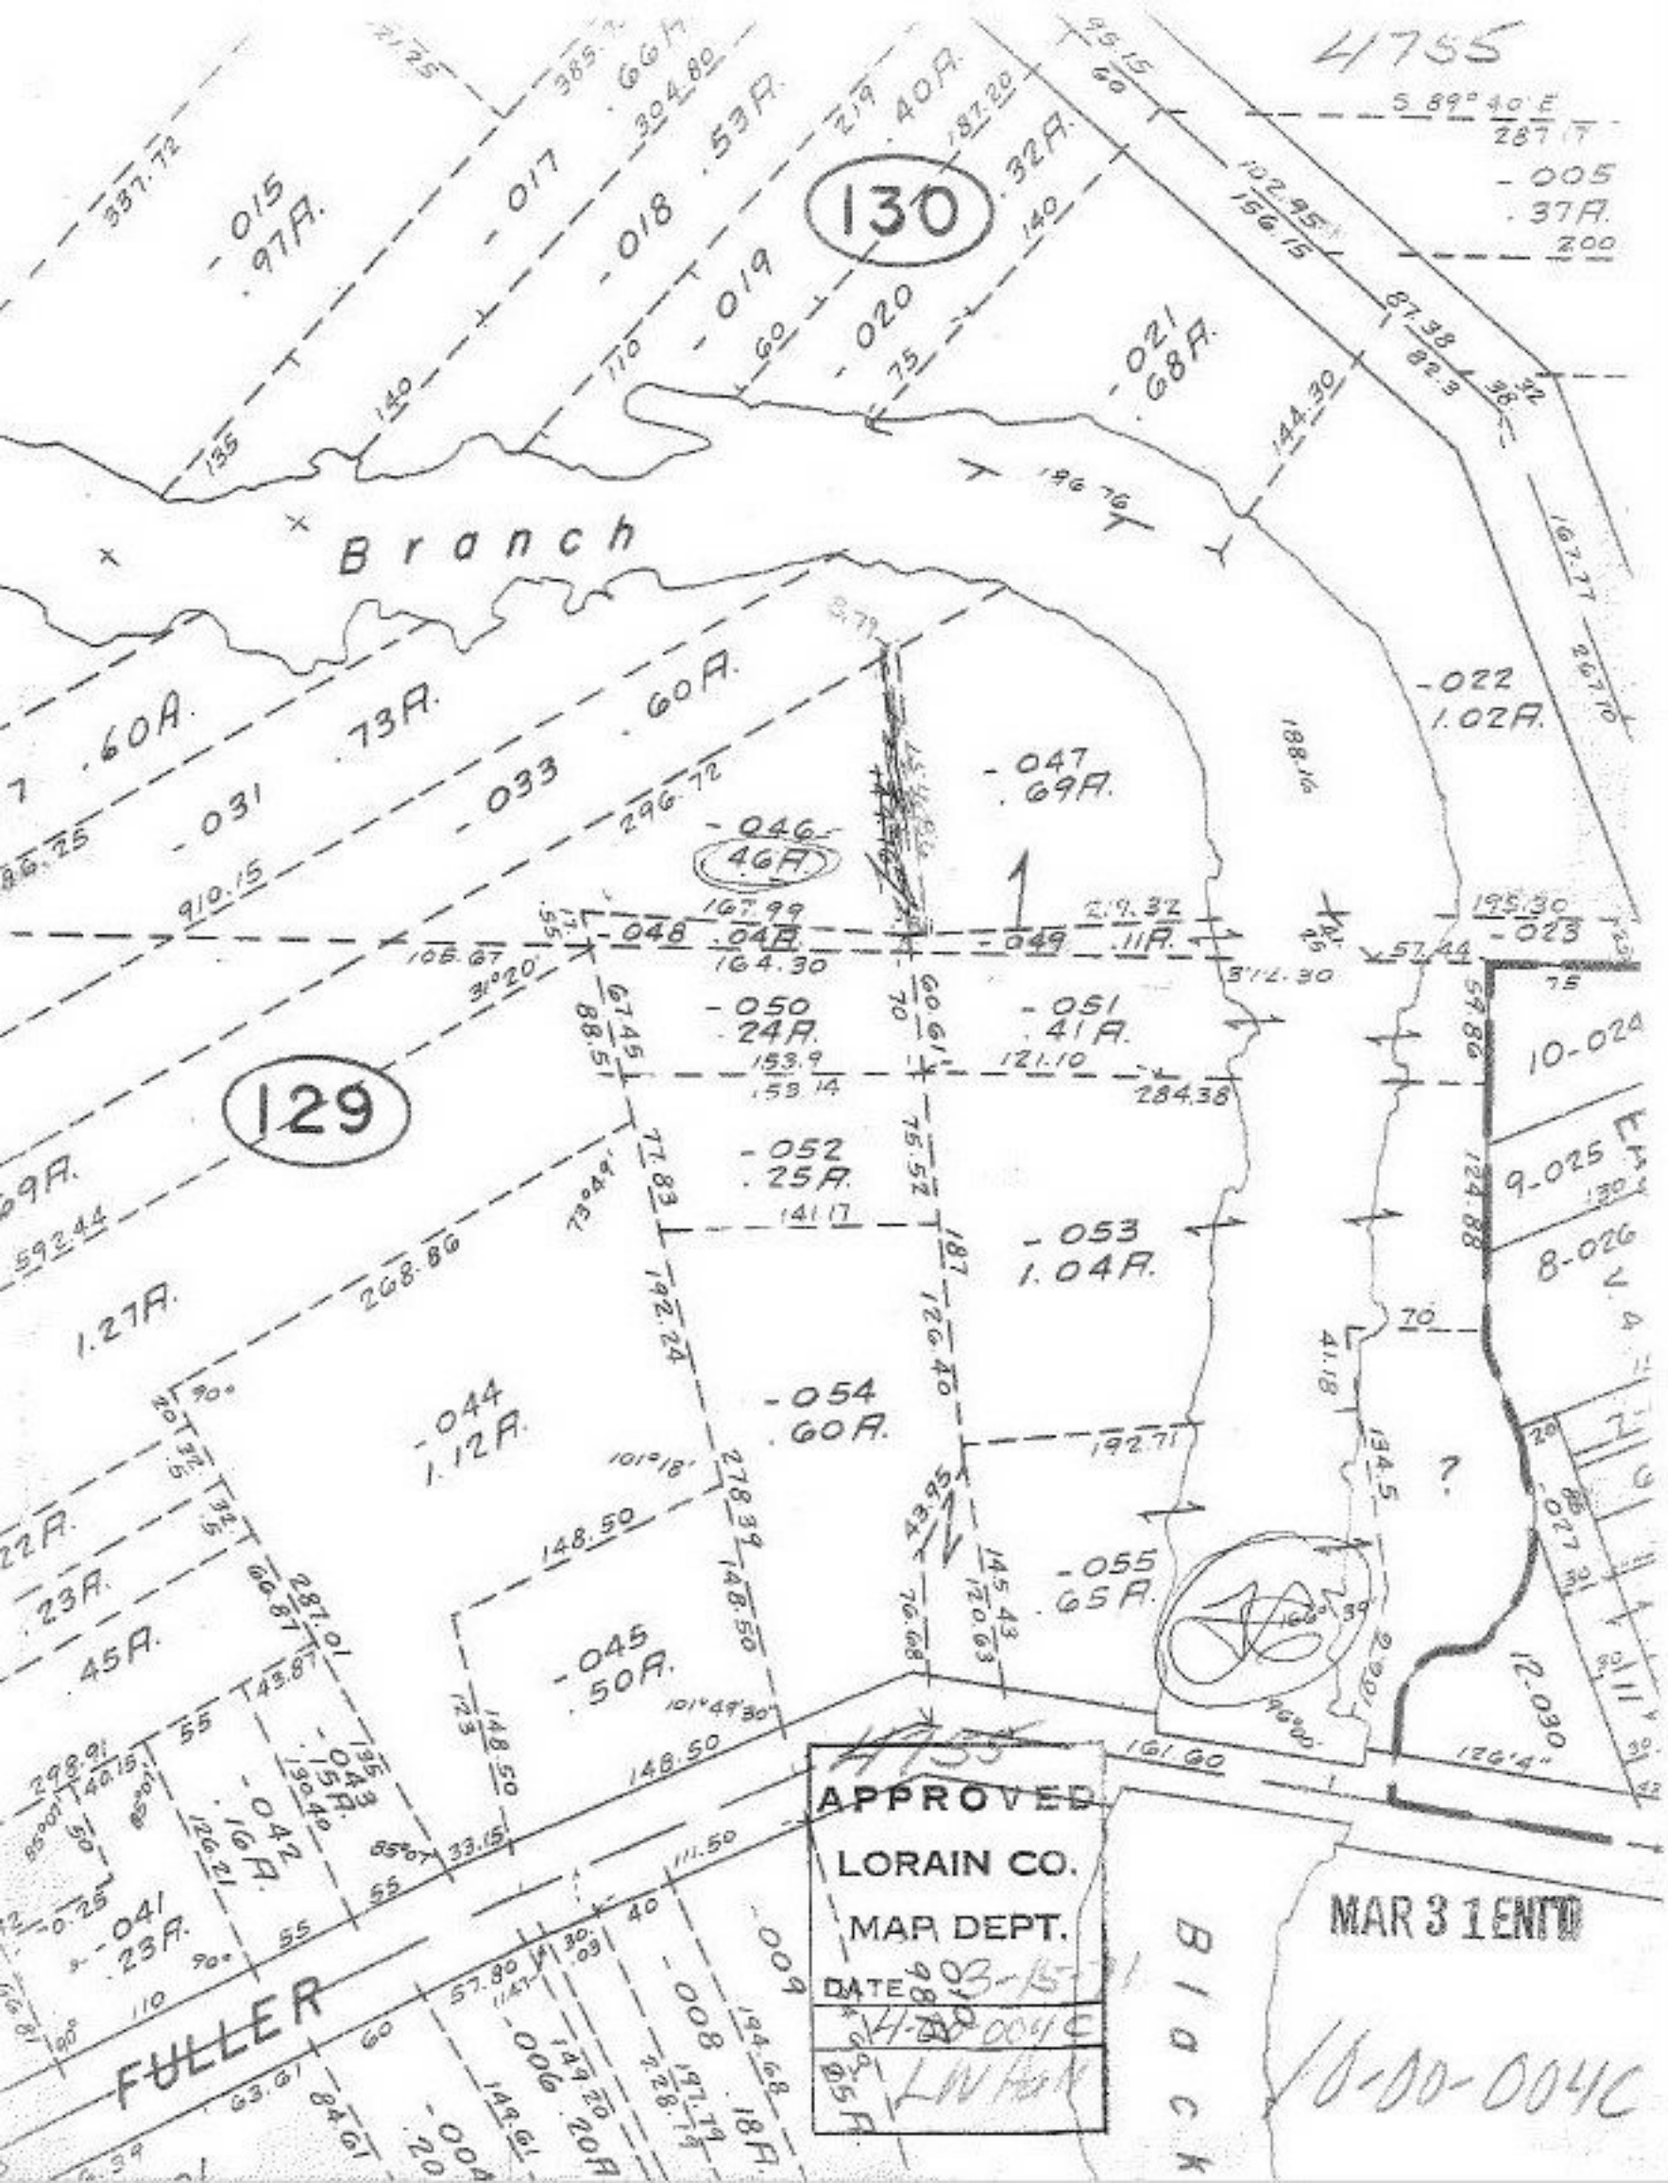
4755
130
129
Branch
FULLER
Black
APPROVED
LORAIN CO.
MAP DEPT.
DATE 3-15-71
MAR 31 ENTD
10-00-004C