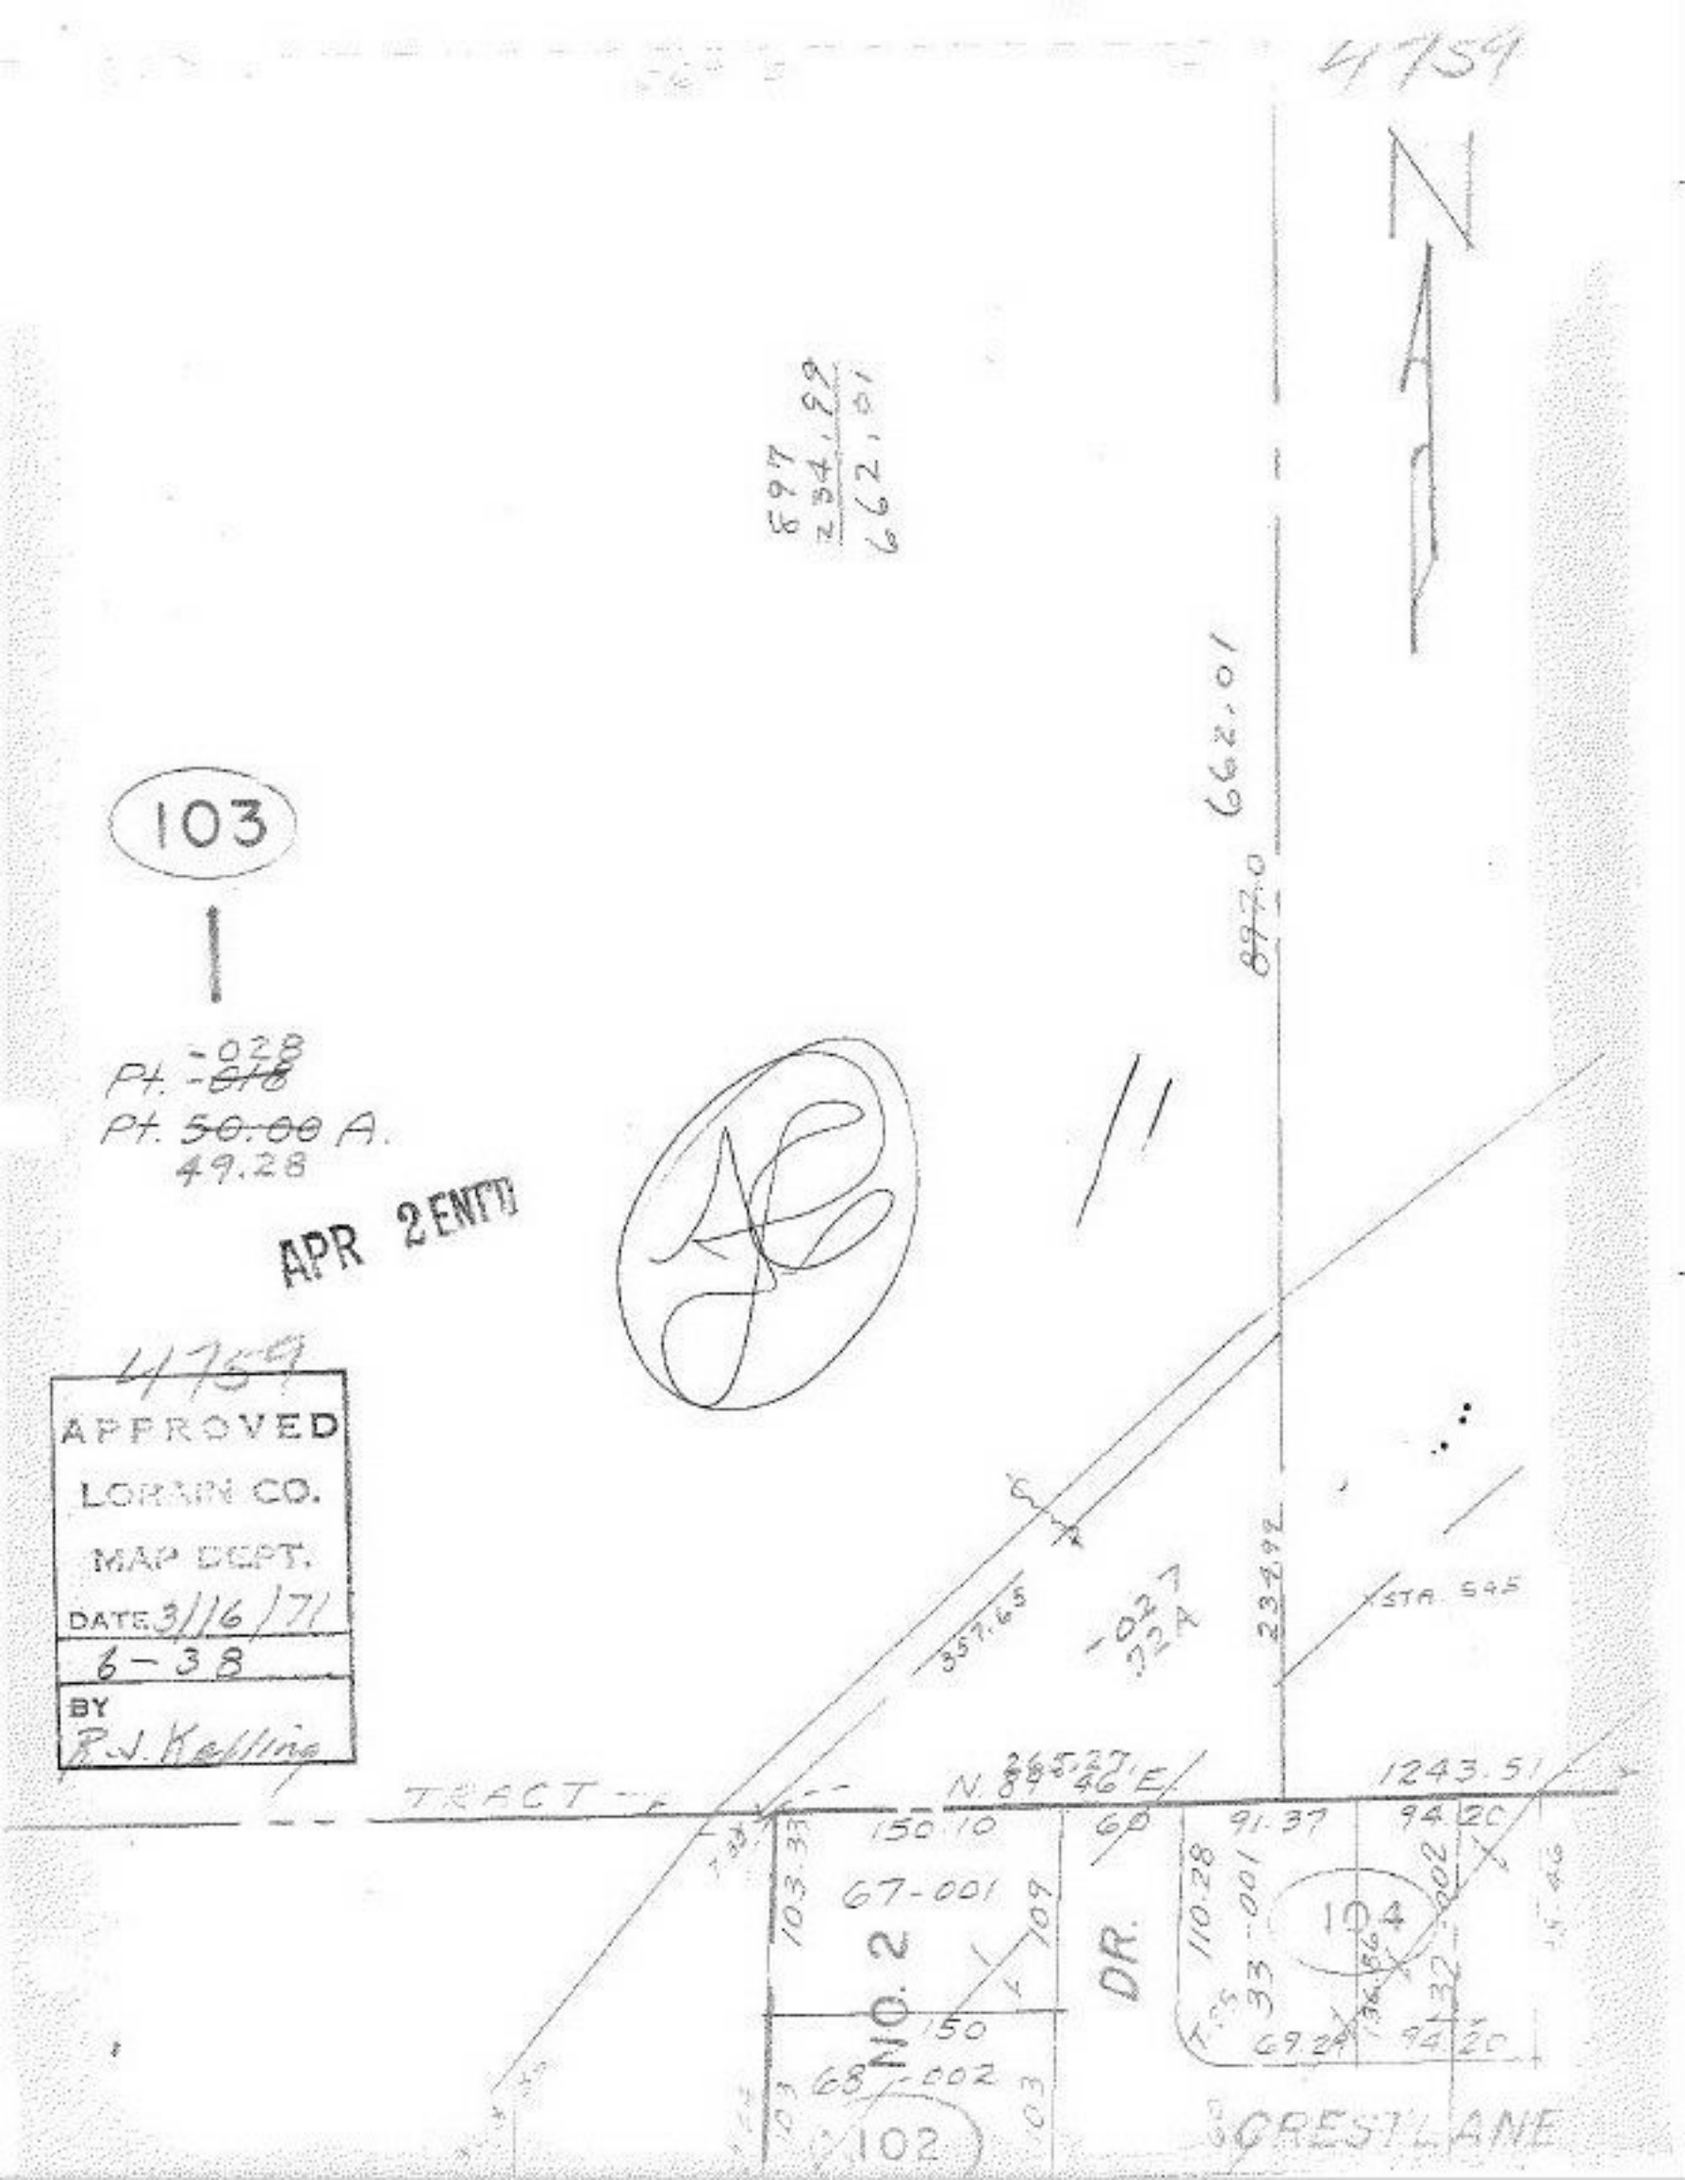
4754
N
697
234.22
662.01
662.01
887.0
103
1
Pt. -028
Pt. -~~018~~
Pt. ~~50.00~~ A.
49.28
APR 2 ENTD
4754
APPROVED
LORAIN CO.
MAP DEPT.
DATE 3/16/71
6-38
BY
R.J. Kelling
357.65
-027
72A
234.98
STA. 545
TRACT
N. 89° 27' 46" E.
1243.51
150.10
60
91.37
94.20
103.33
67-001
109
DR.
110.28
33-001
104
NO. 2
150
68-002
102
94.20
