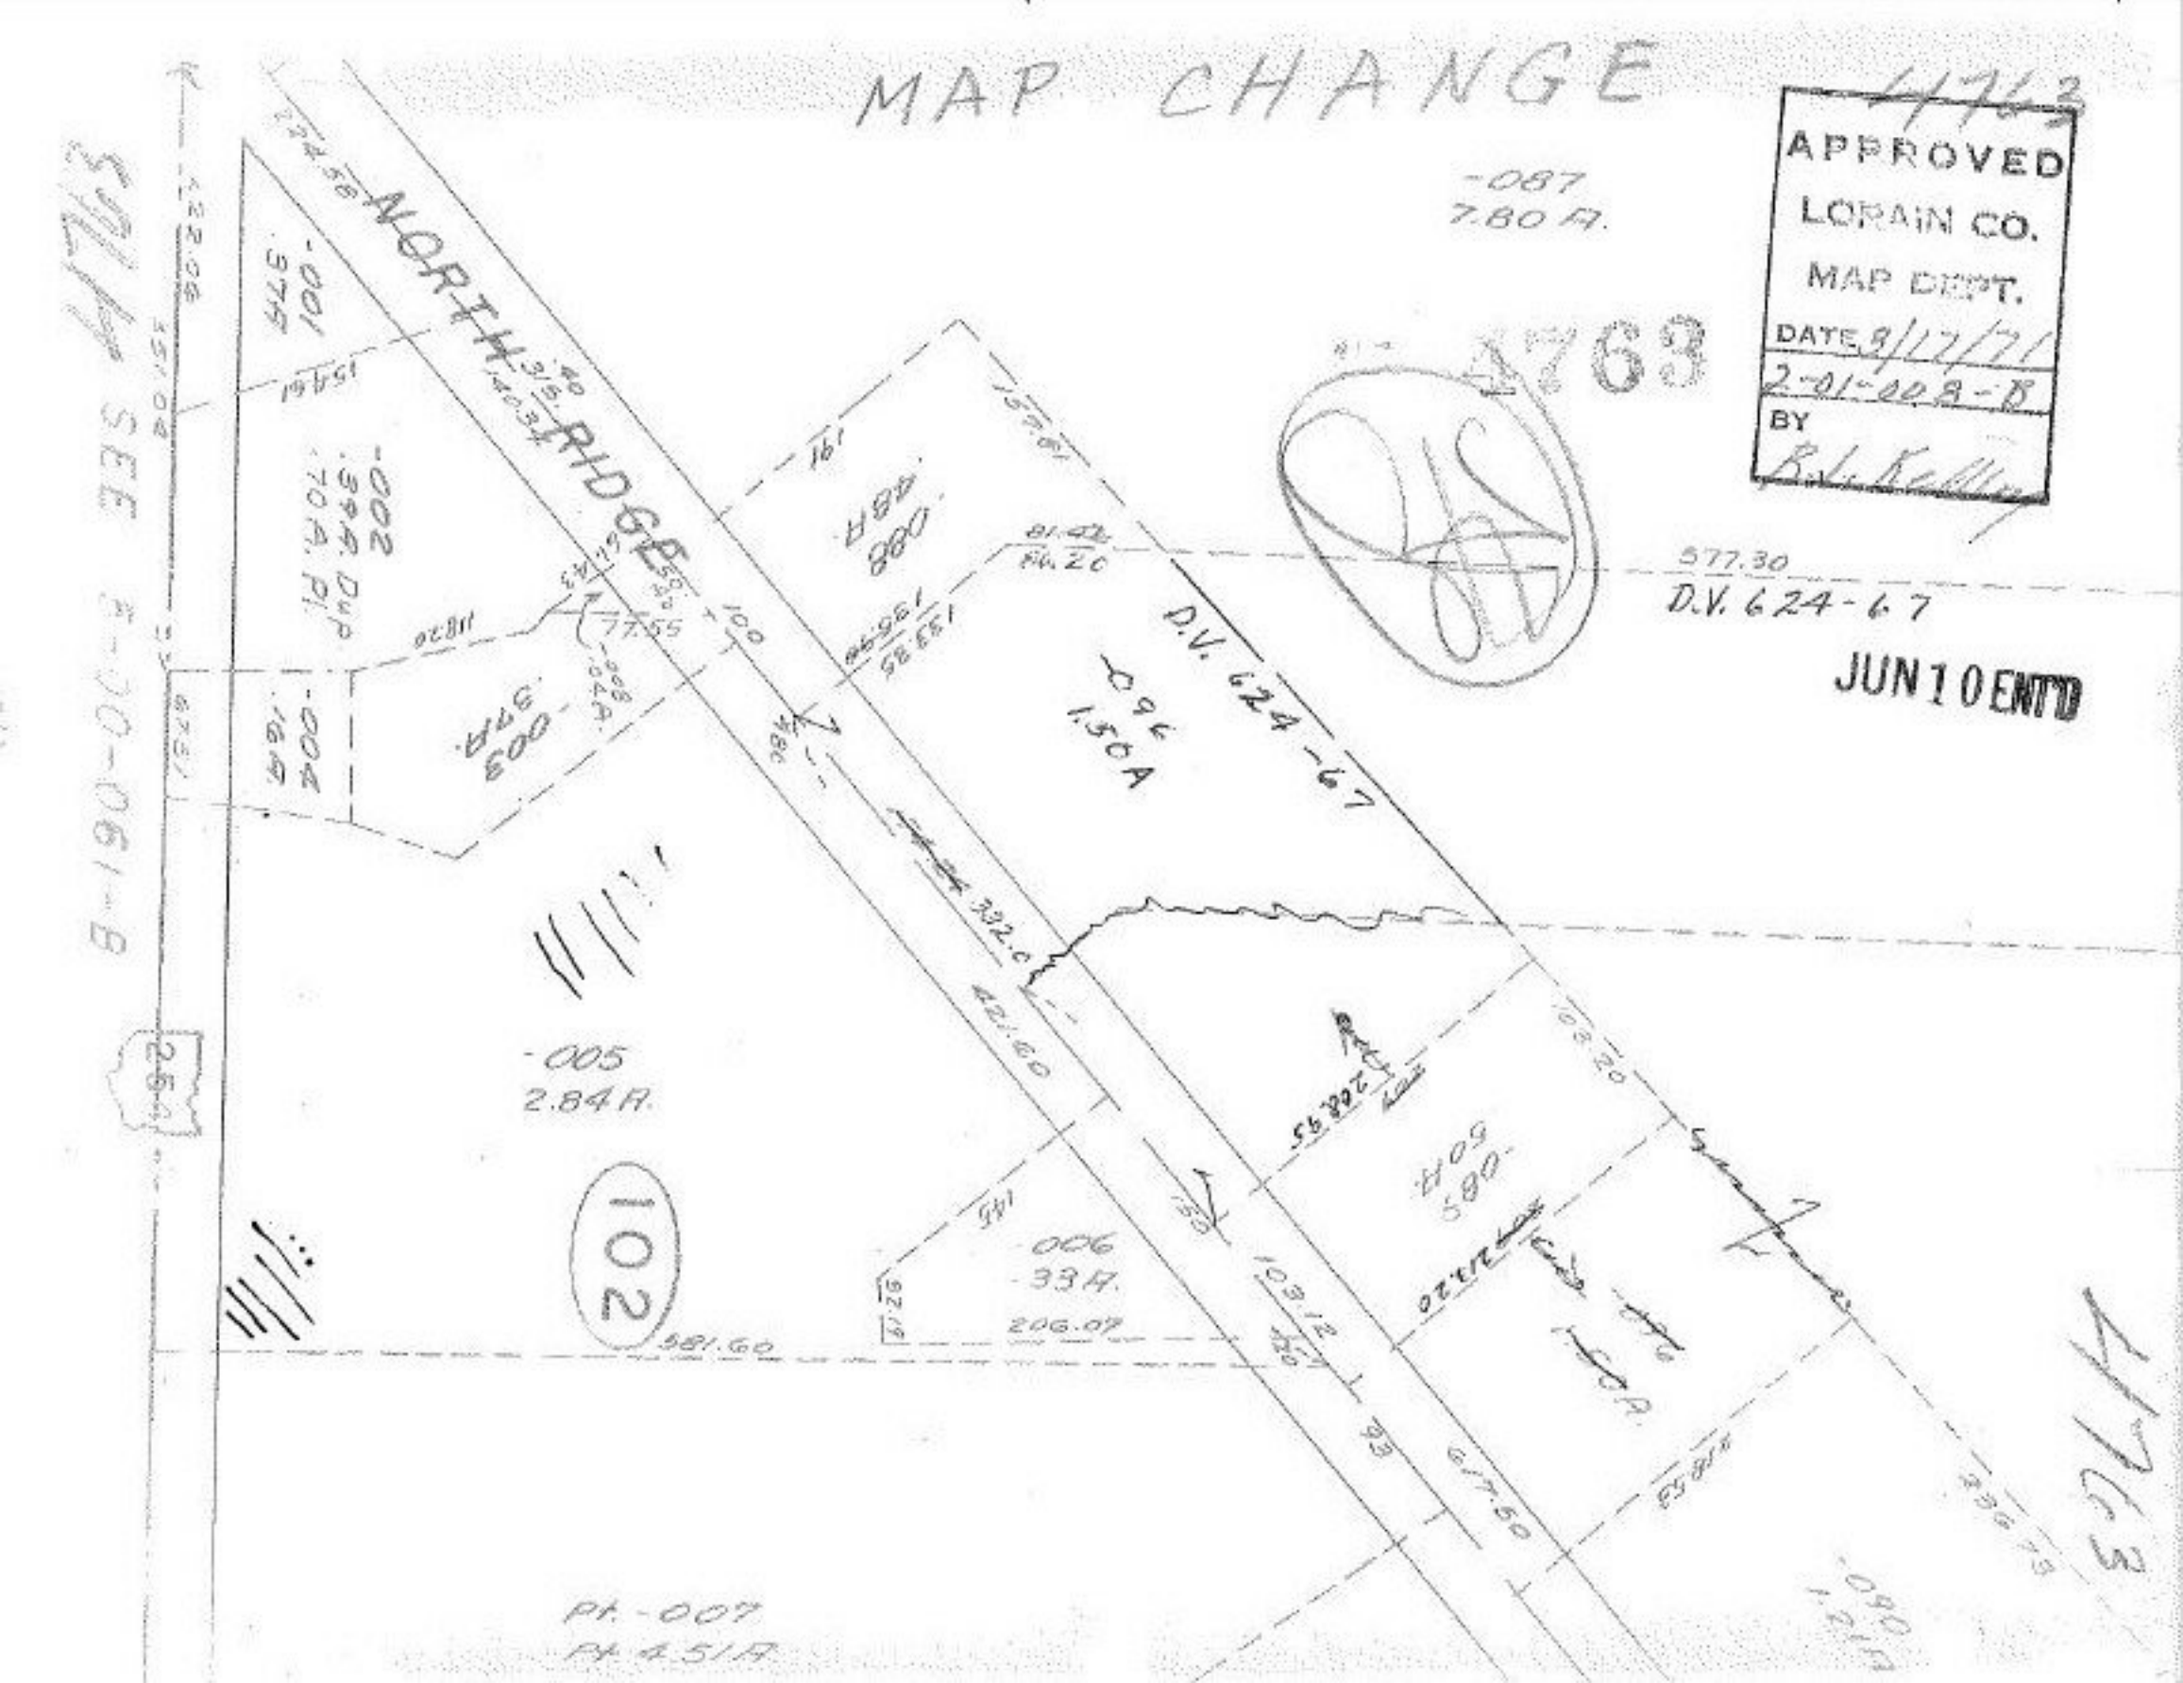
MAP CHANGE
4762
APPROVED
LORAIN CO.
MAP DEPT.
DATE 8/12/71
2-01-008-B
BY
R. L. Keller
4763
-087
7.80 A.
NORTH RIDGE
40 S.R.
-001
-002
-004
-005
2.84 A.
102
-006
33 A.
-090
1.21 A.
Pt. -007
Pt. 4.51 A.
D.V. 624-67
577.30
D.V. 624-67
JUN 10 ENTD
