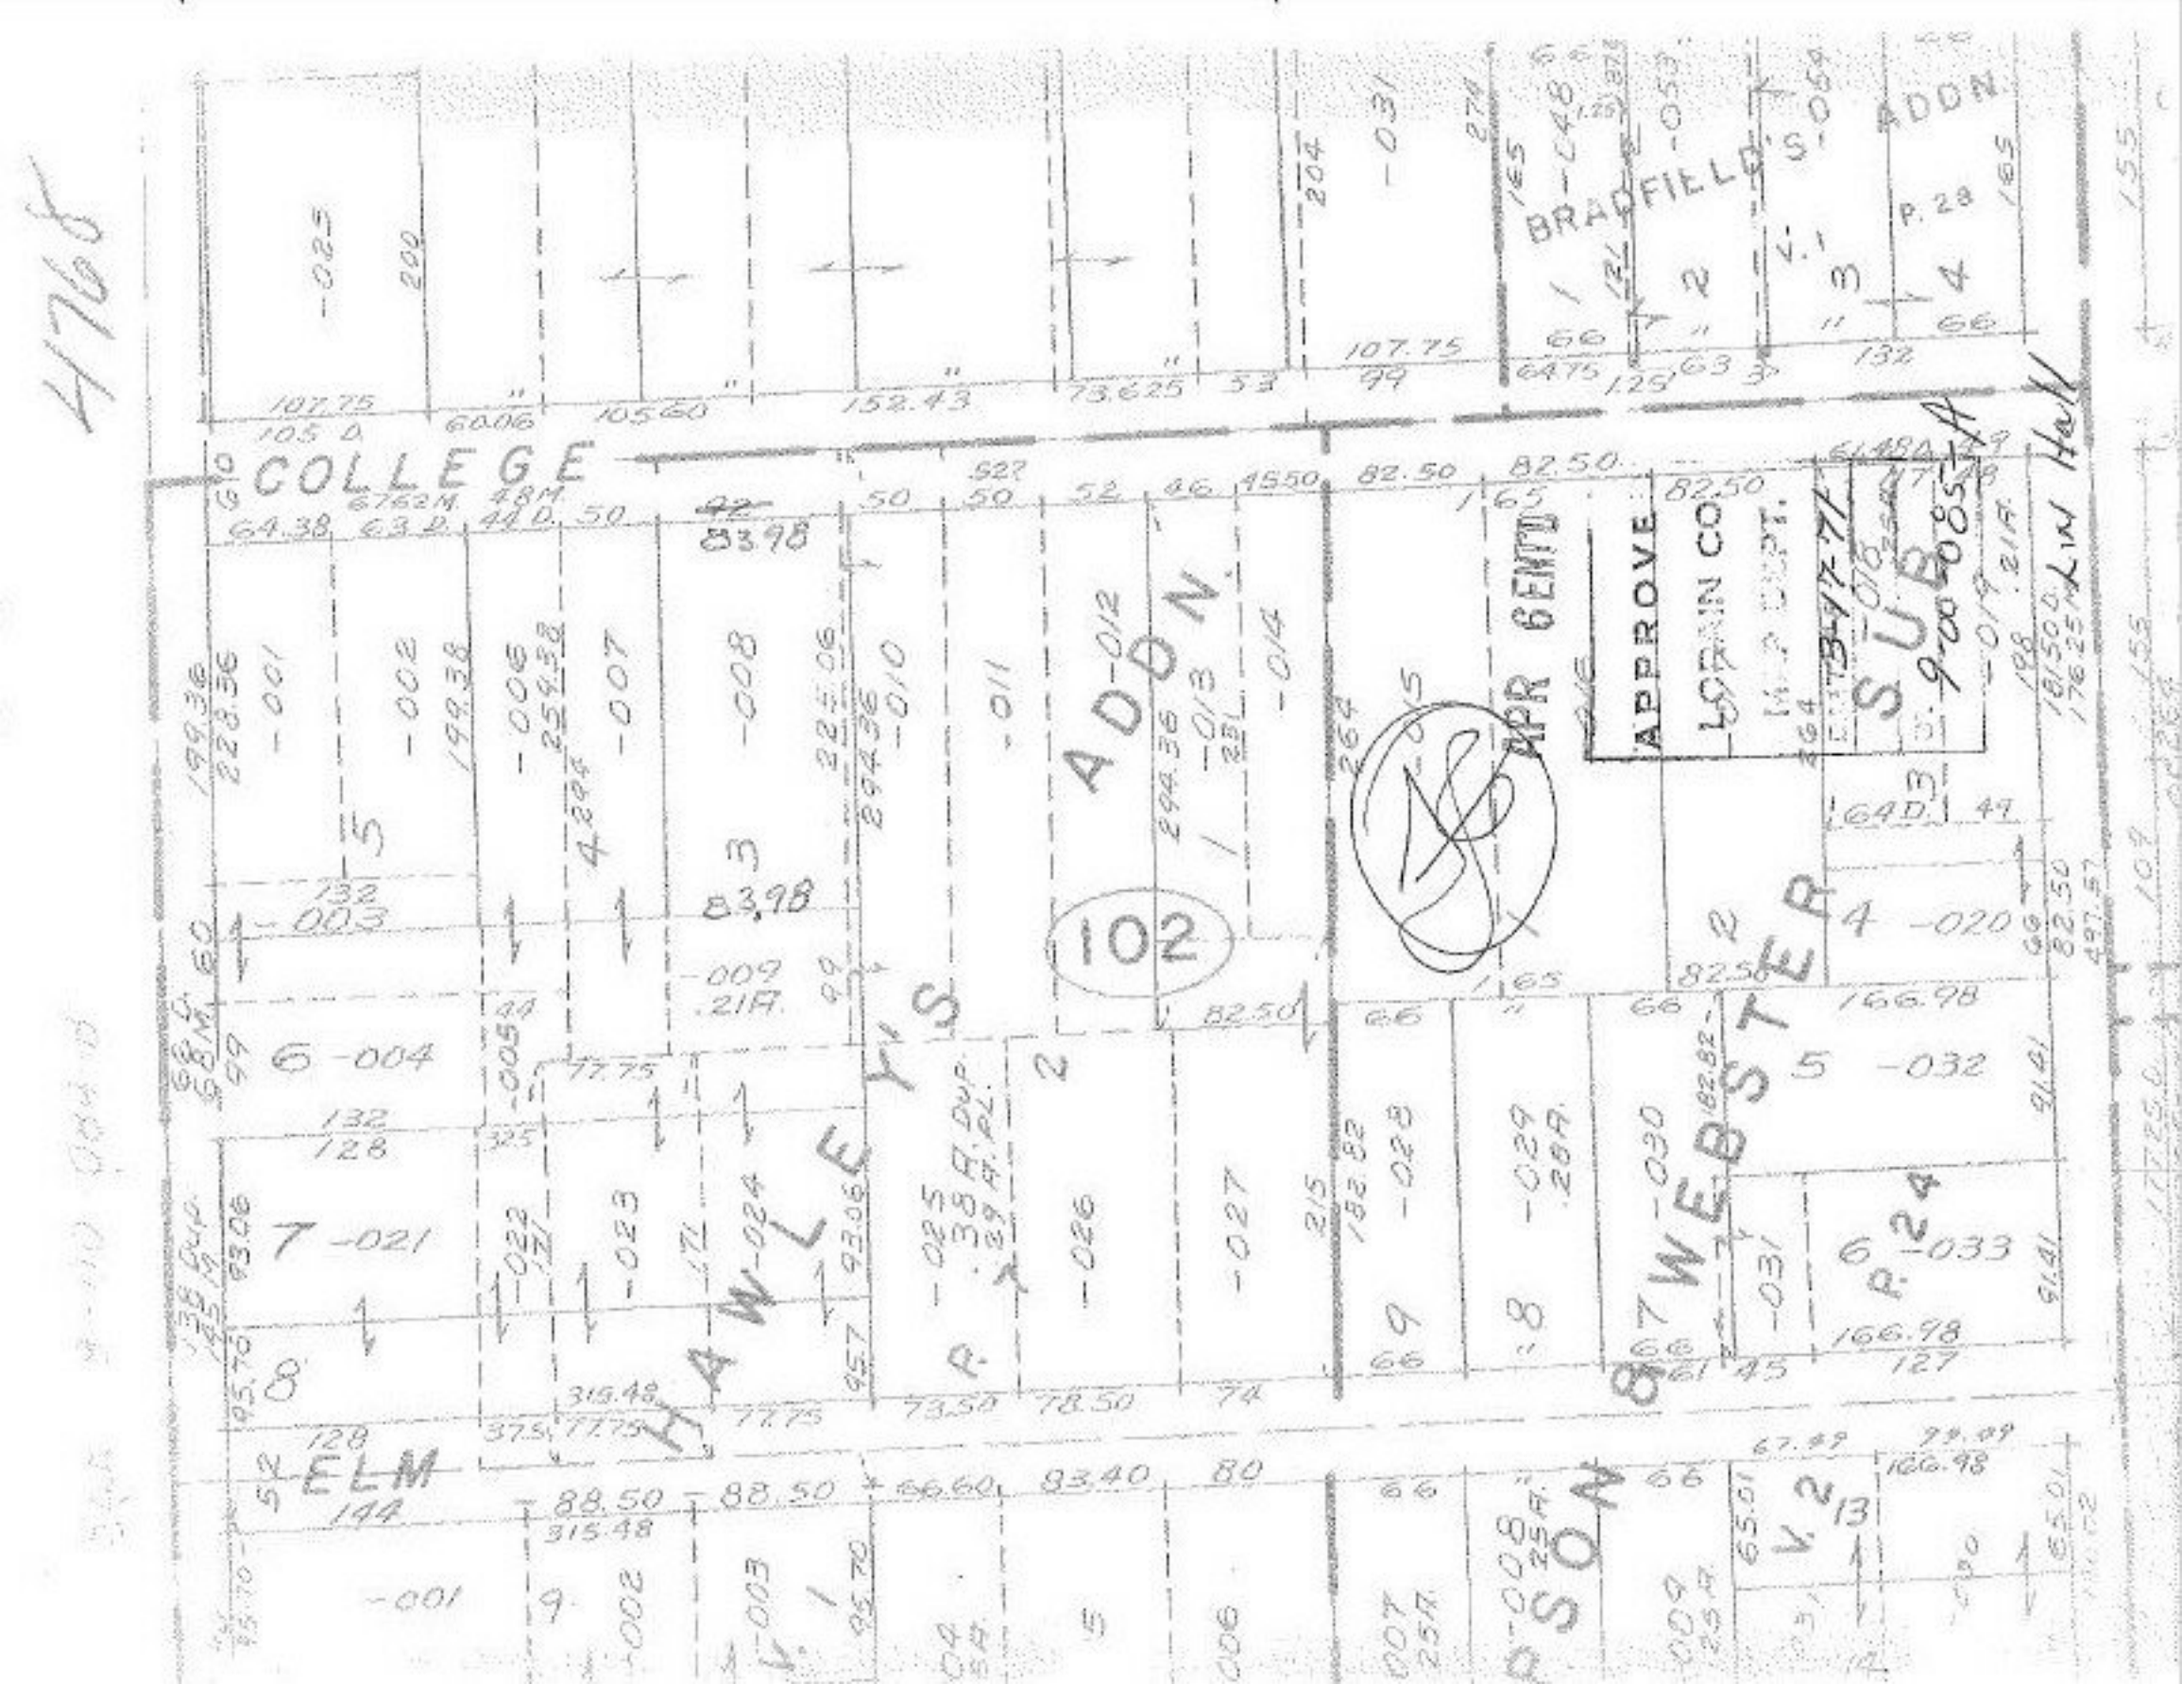
4768
COLLEGE
BRADFIELD'S ADDN.
HAWLEY'S ADDN.
ELM
WEBSTER SUB.
APR 6 ENT'D
APPROVE
LORAIN CO
MAP DEPT.
102
Lin Hall