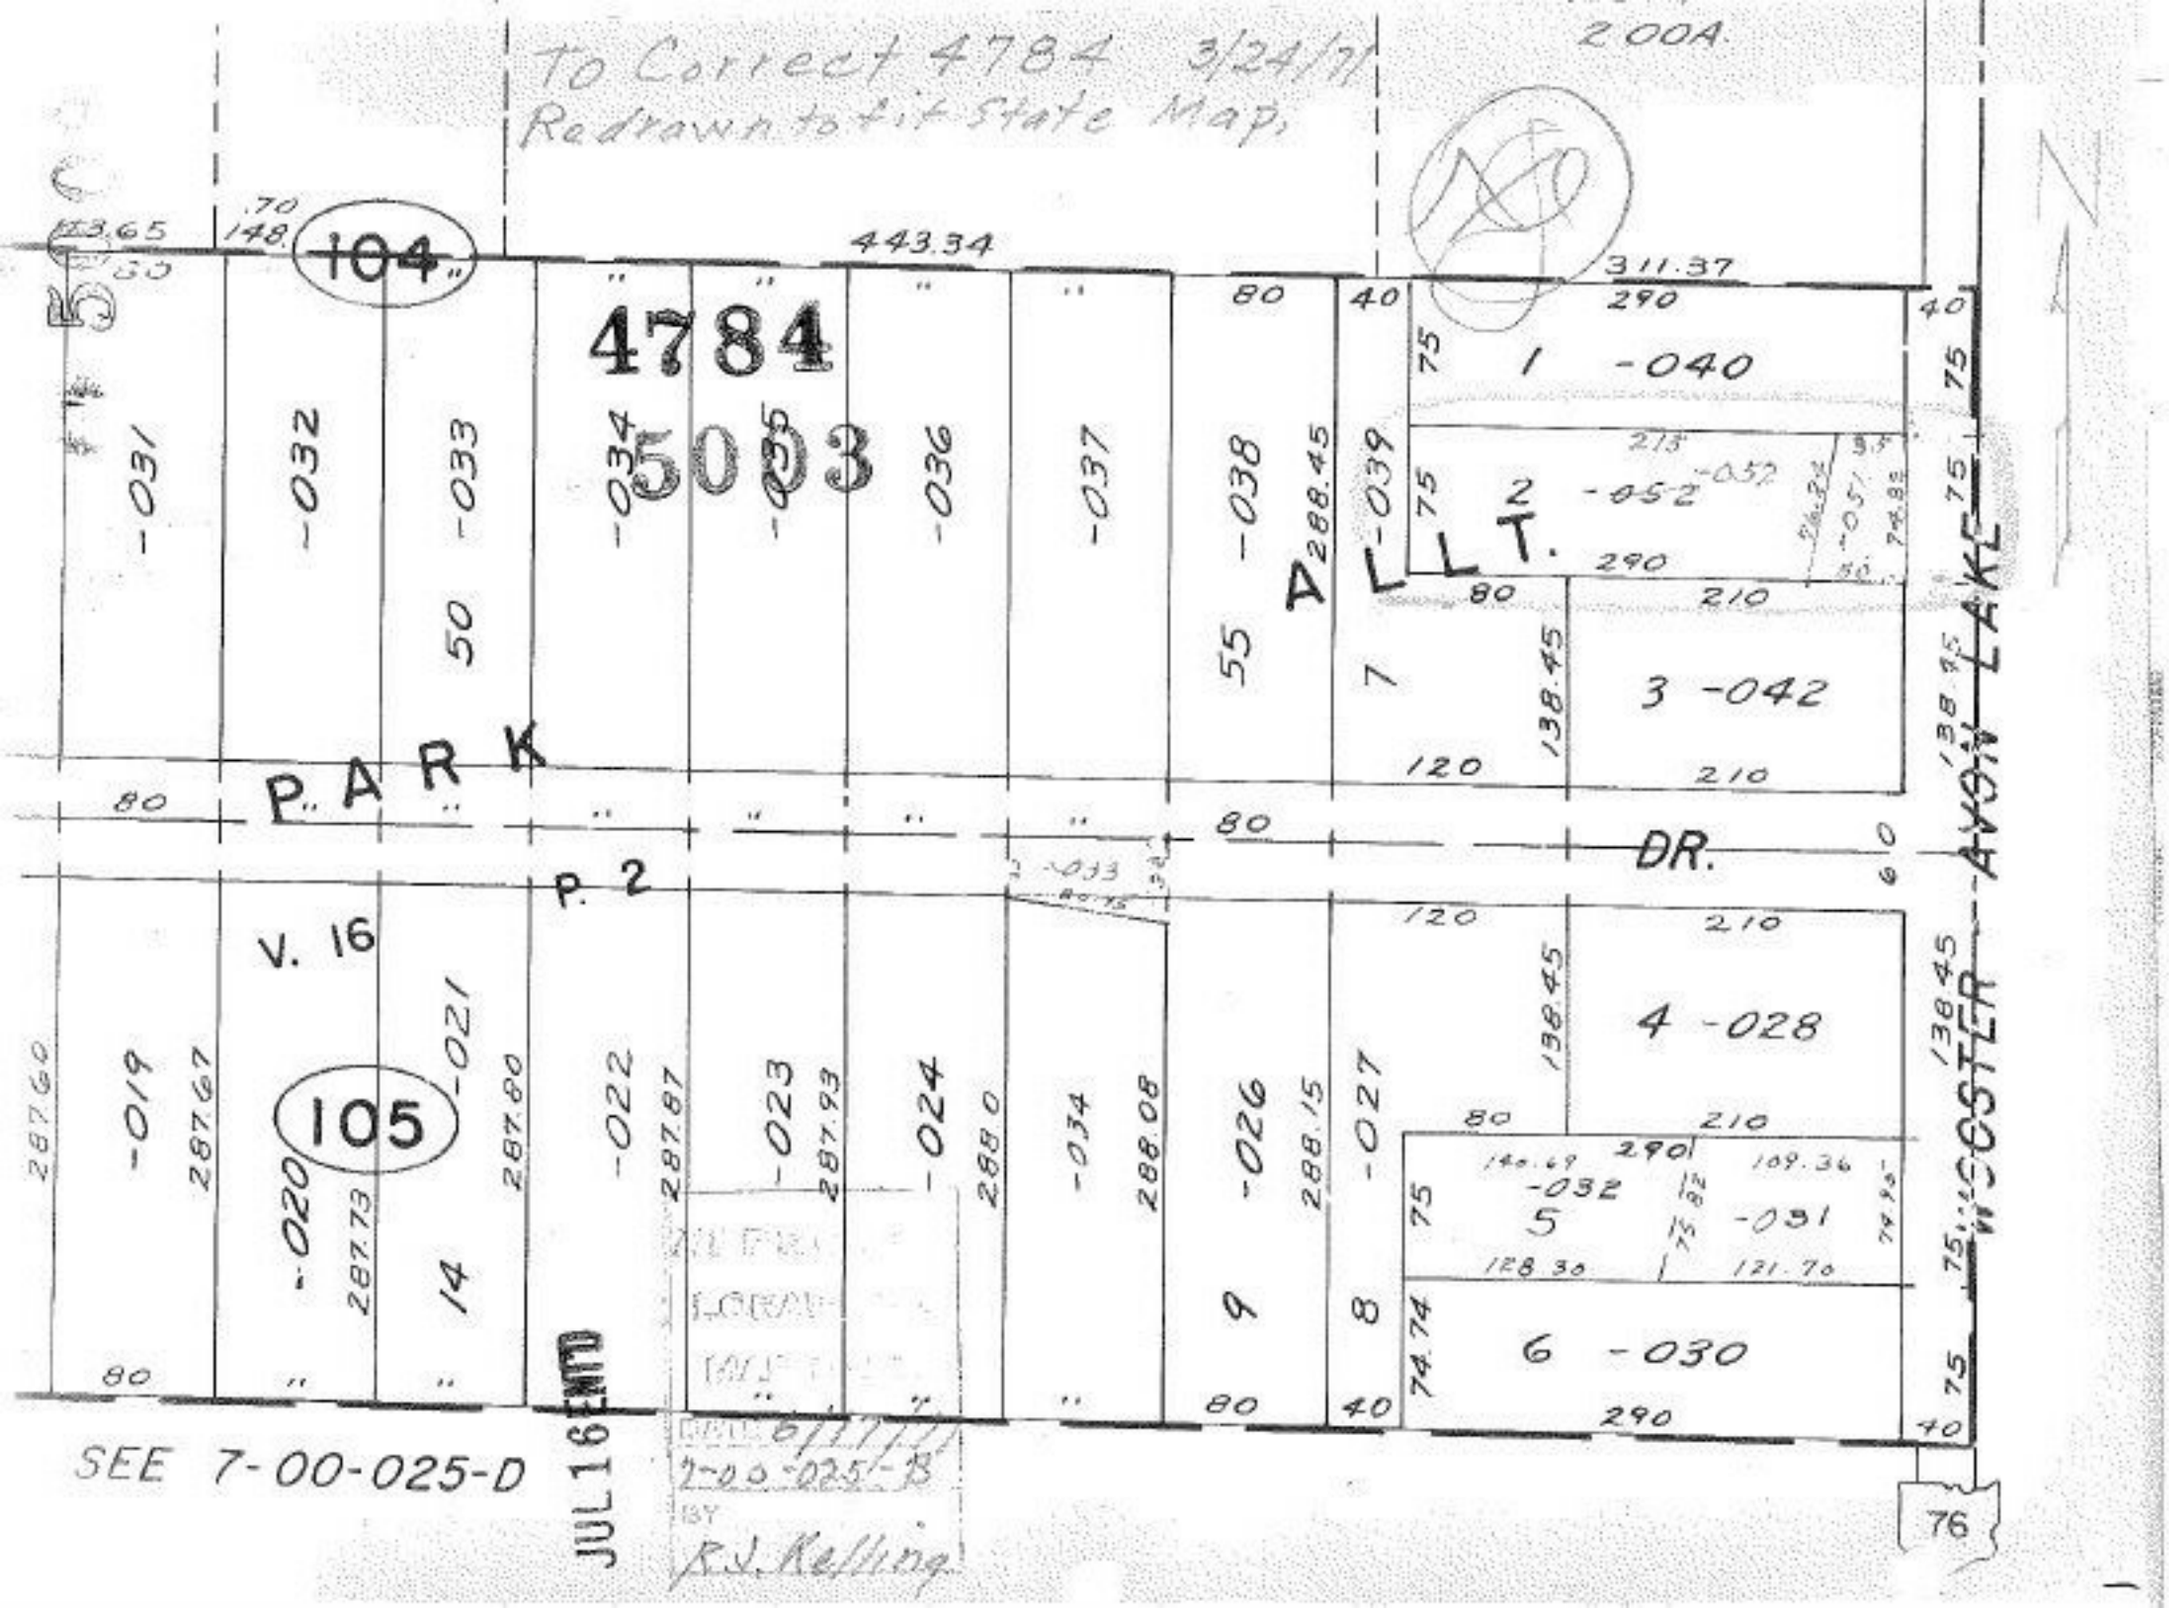
To Correct 4784 3/24/71
Redrawn to fit State Map.
2.00A.
104
105
4784
5003
443.34
311.37
PARK
ALLT.
DR.
P. 2
V. 16
WOOSTER AVON LAKE
1 -040
2 -052
3 -042
4 -028
5 -032
-031
6 -030
-031
-032
-033
-034
-035
-036
-037
-038
-039
-019
-020
-021
-022
-023
-024
-026
-027
-034
50
55
7
14
9
8
SEE 7-00-025-D
JUL 16 ENTD
DATE 6/17/71
7-00-025-B
BY
R.J. Kelling
76