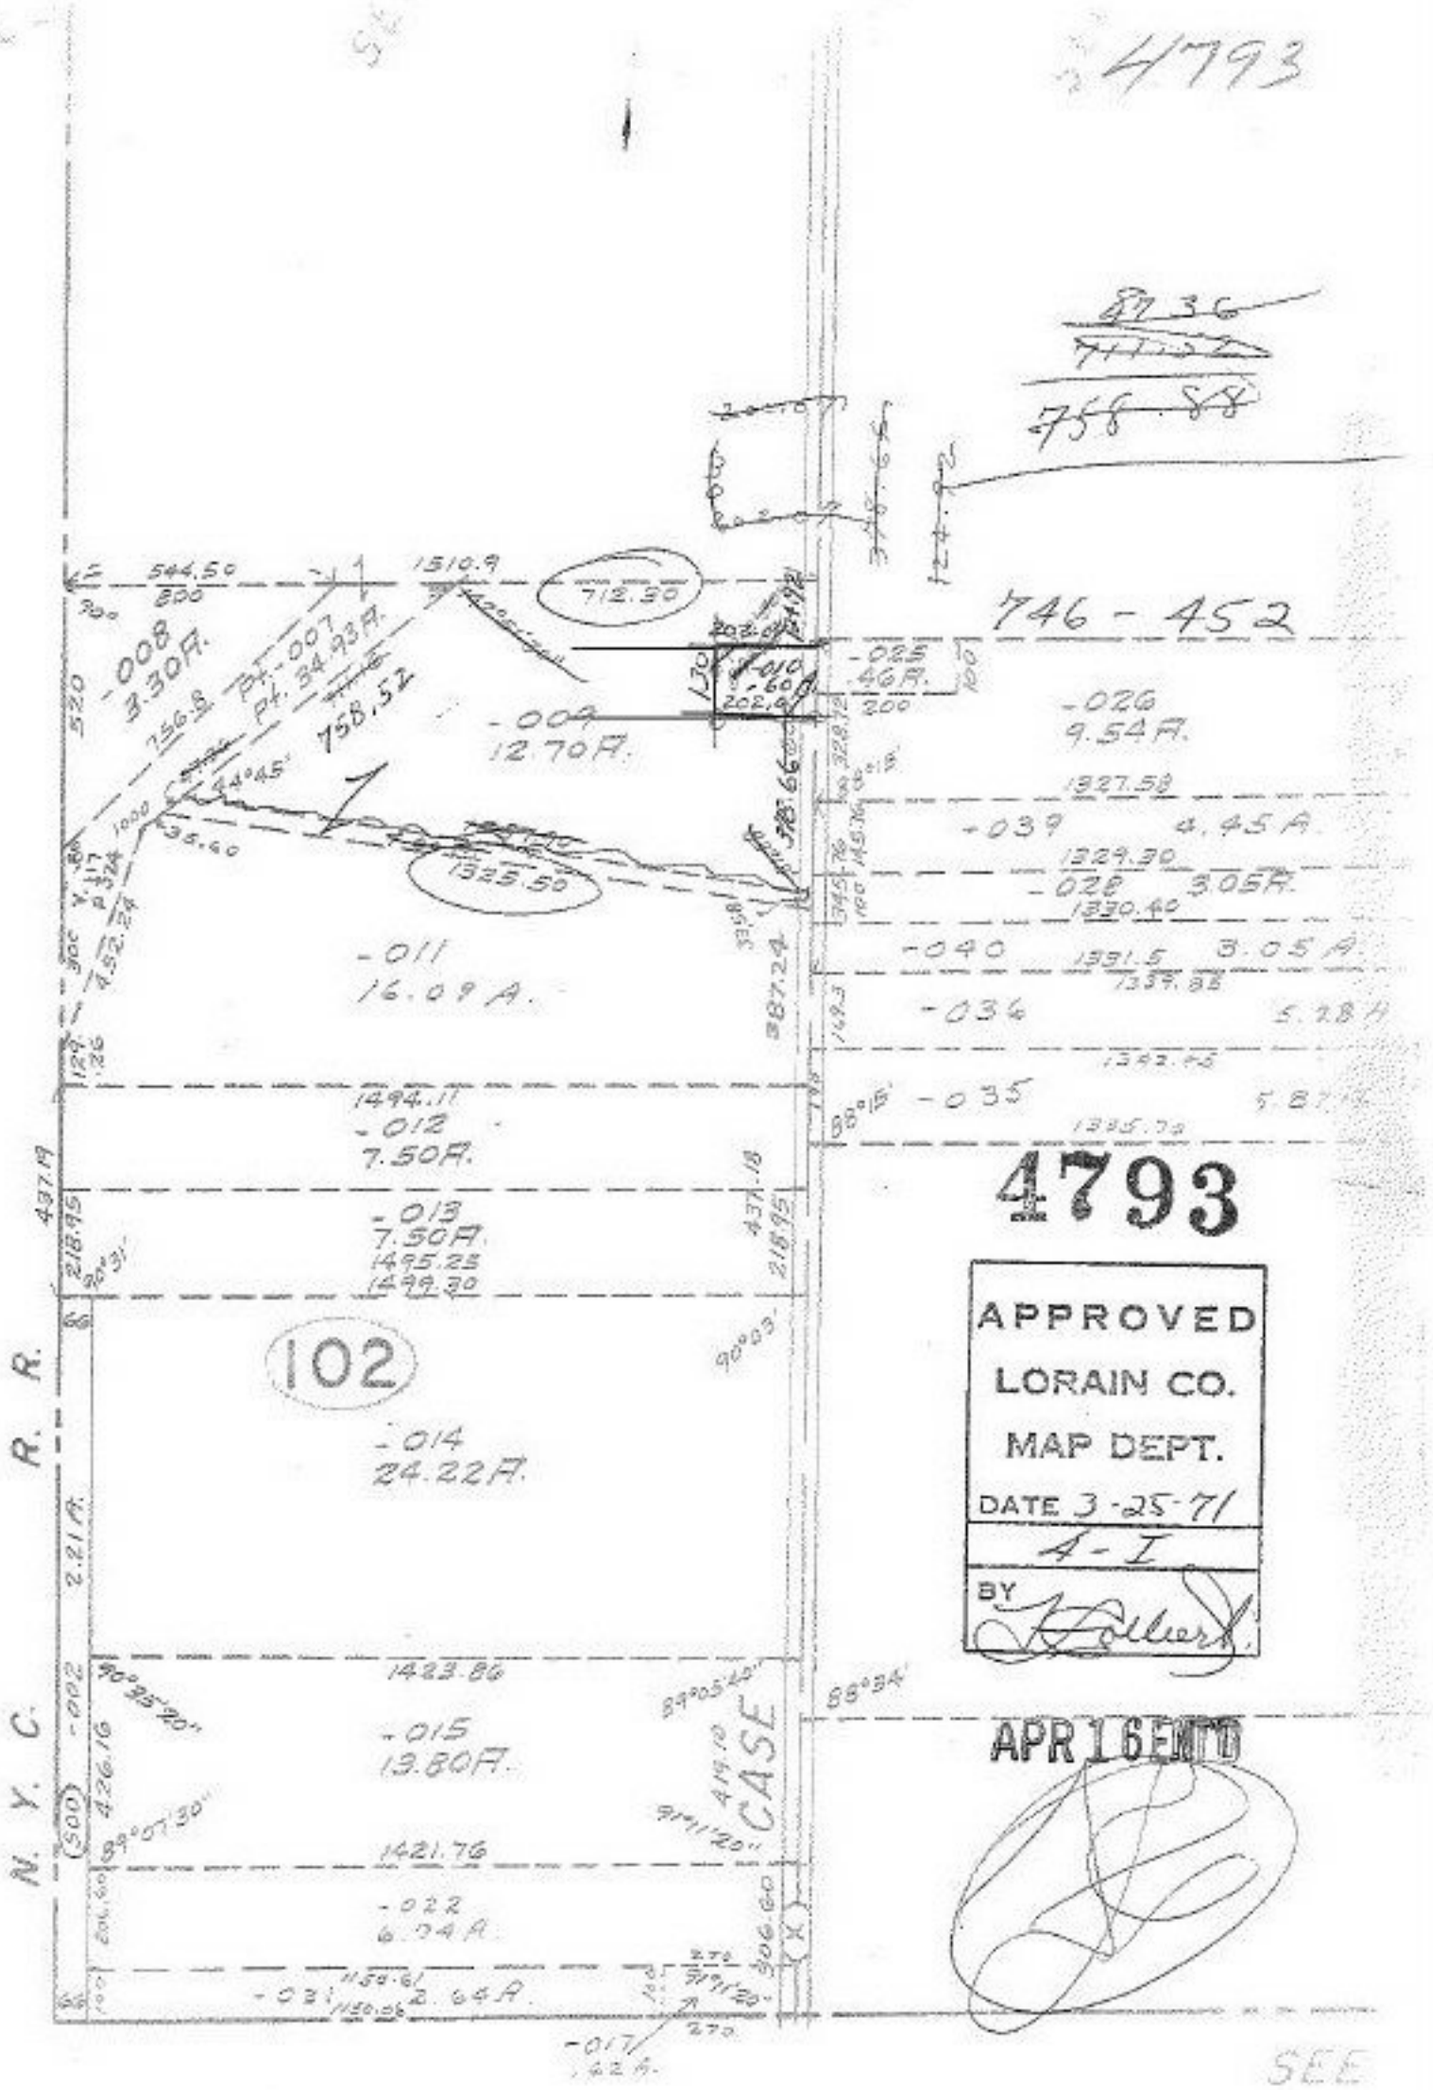
4793
746 - 452
-008
3.30A.
-009
12.70A.
-011
16.09 A.
-012
7.50A.
-013
7.50A.
-014
24.22A.
-015
13.80A.
-022
6.74 A.
-026
9.54A.
-039
4.45 A.
-028
3.05A.
-040
3.05 A.
-036
5.28 A
-035
102
N. Y. C. R. R.
CASE
APPROVED
LORAIN CO.
MAP DEPT.
DATE 3-25-71
4-I
BY
APR 16 ENT'D
SEE