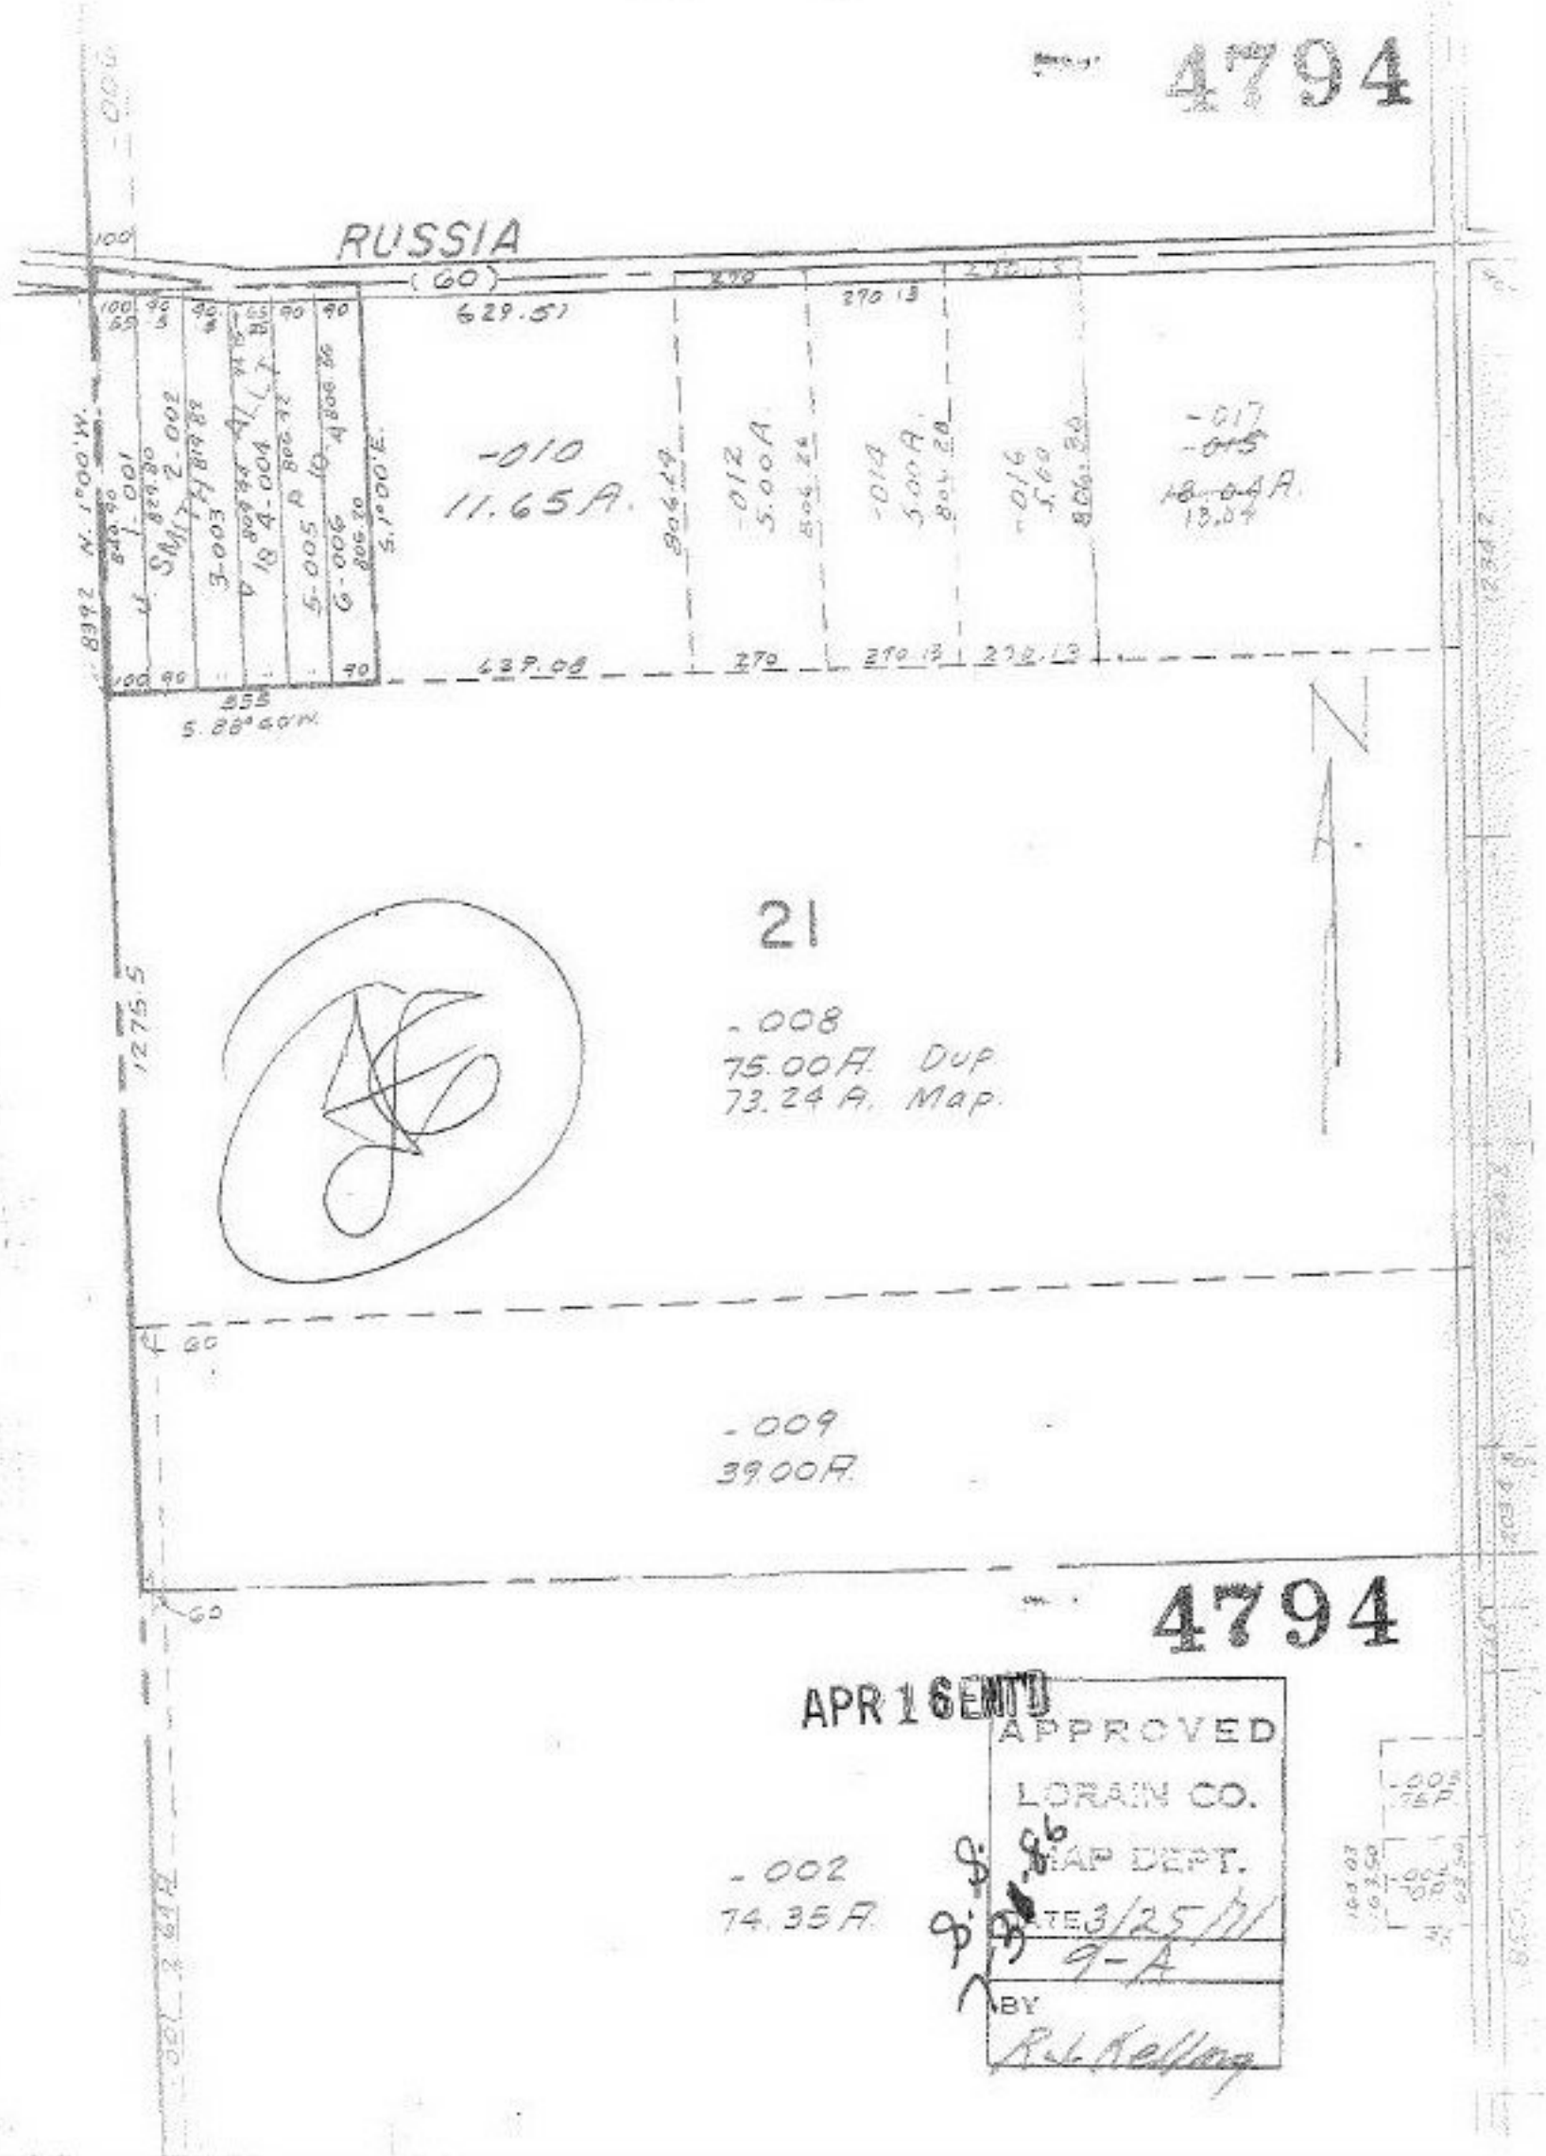
4794
RUSSIA
(60)
629.51
270
270.13
-010
11.65A.
-012
5.00A
-014
5.00A
-016
5.60
-017
-015
18.04A.
13.04
629.08
270
270.13
270.13
N. 1°00'W.
S. 1°00'E.
S. 88°40'W.
21
-008
75.00A. Dup
73.24 A. Map.
1275.5
60
-009
39.00A.
60
4794
APR 16 ENT'D
APPROVED
LORAIN CO.
MAP DEPT.
DATE 3/25/71
9-A
BY
R.L. Kelling
-002
74.35A.