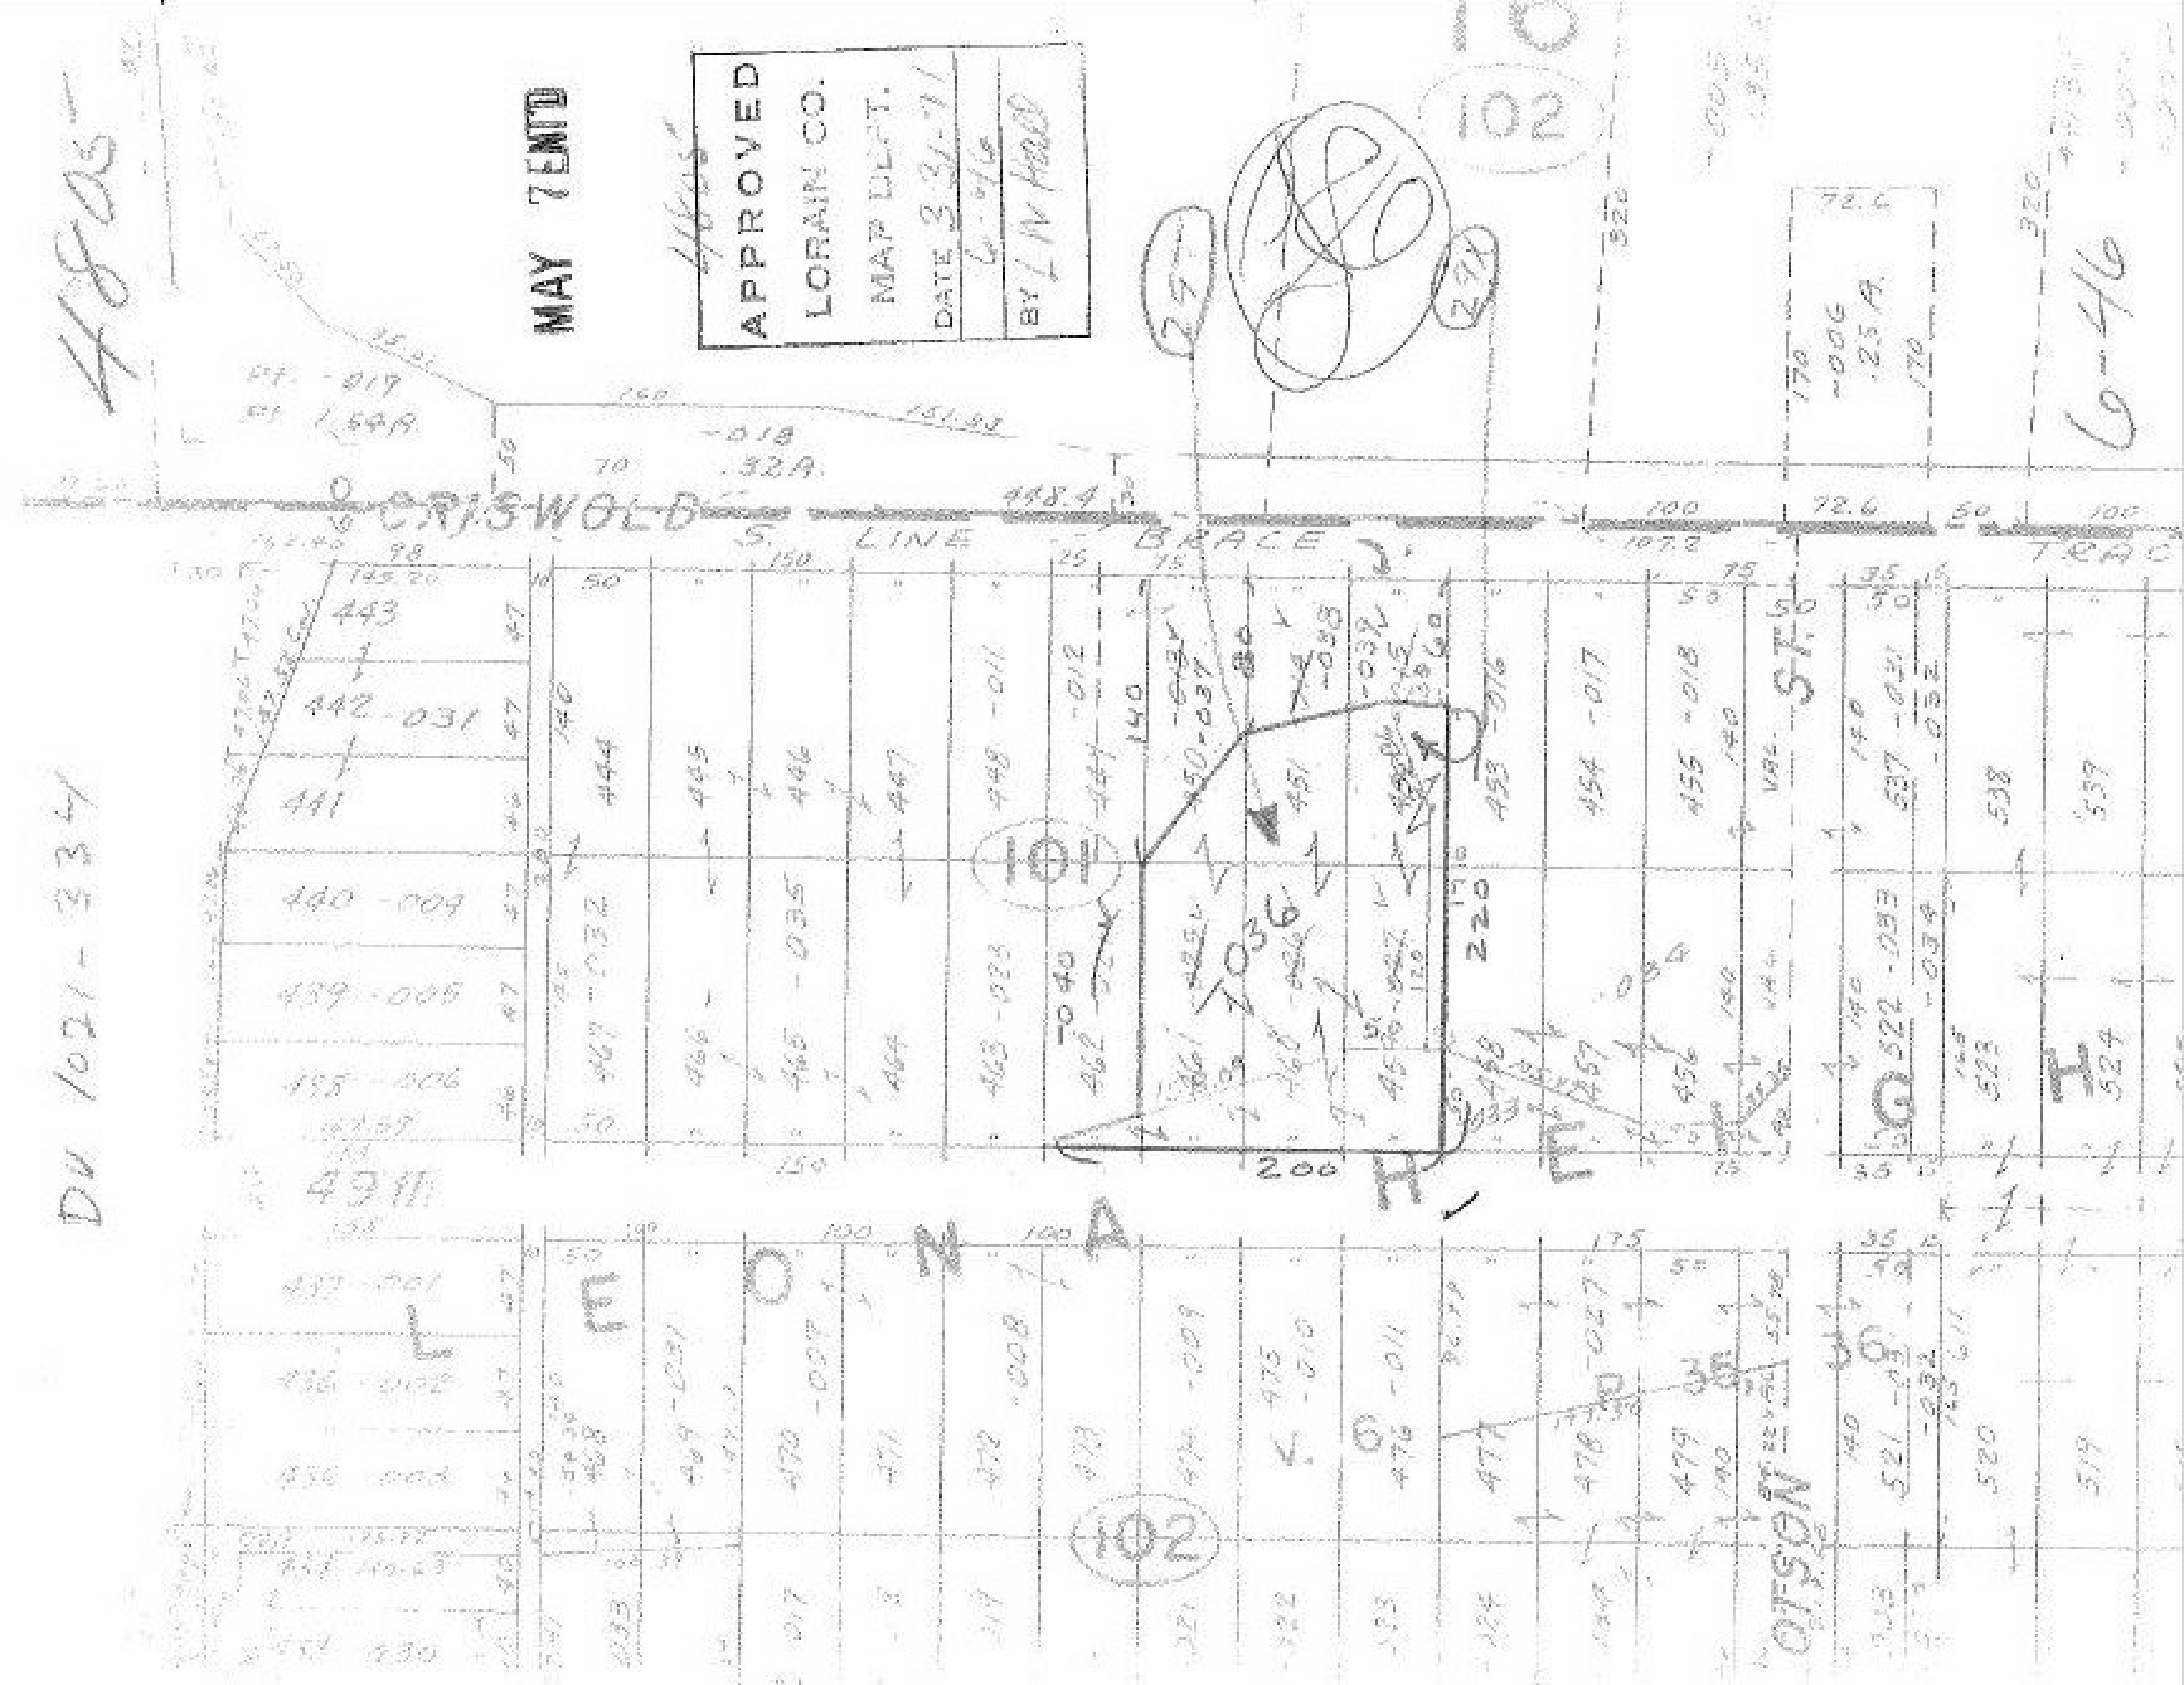

MAY 7 ENTD
APPROVED
LORAIN CO.
MAP DEPT.
DATE 3-31-11
4805
6-46
DV 1021-334
CRISWOLD
S. LINE
BRACE
TRAC
101
102
102
ST.
OTSON