4805

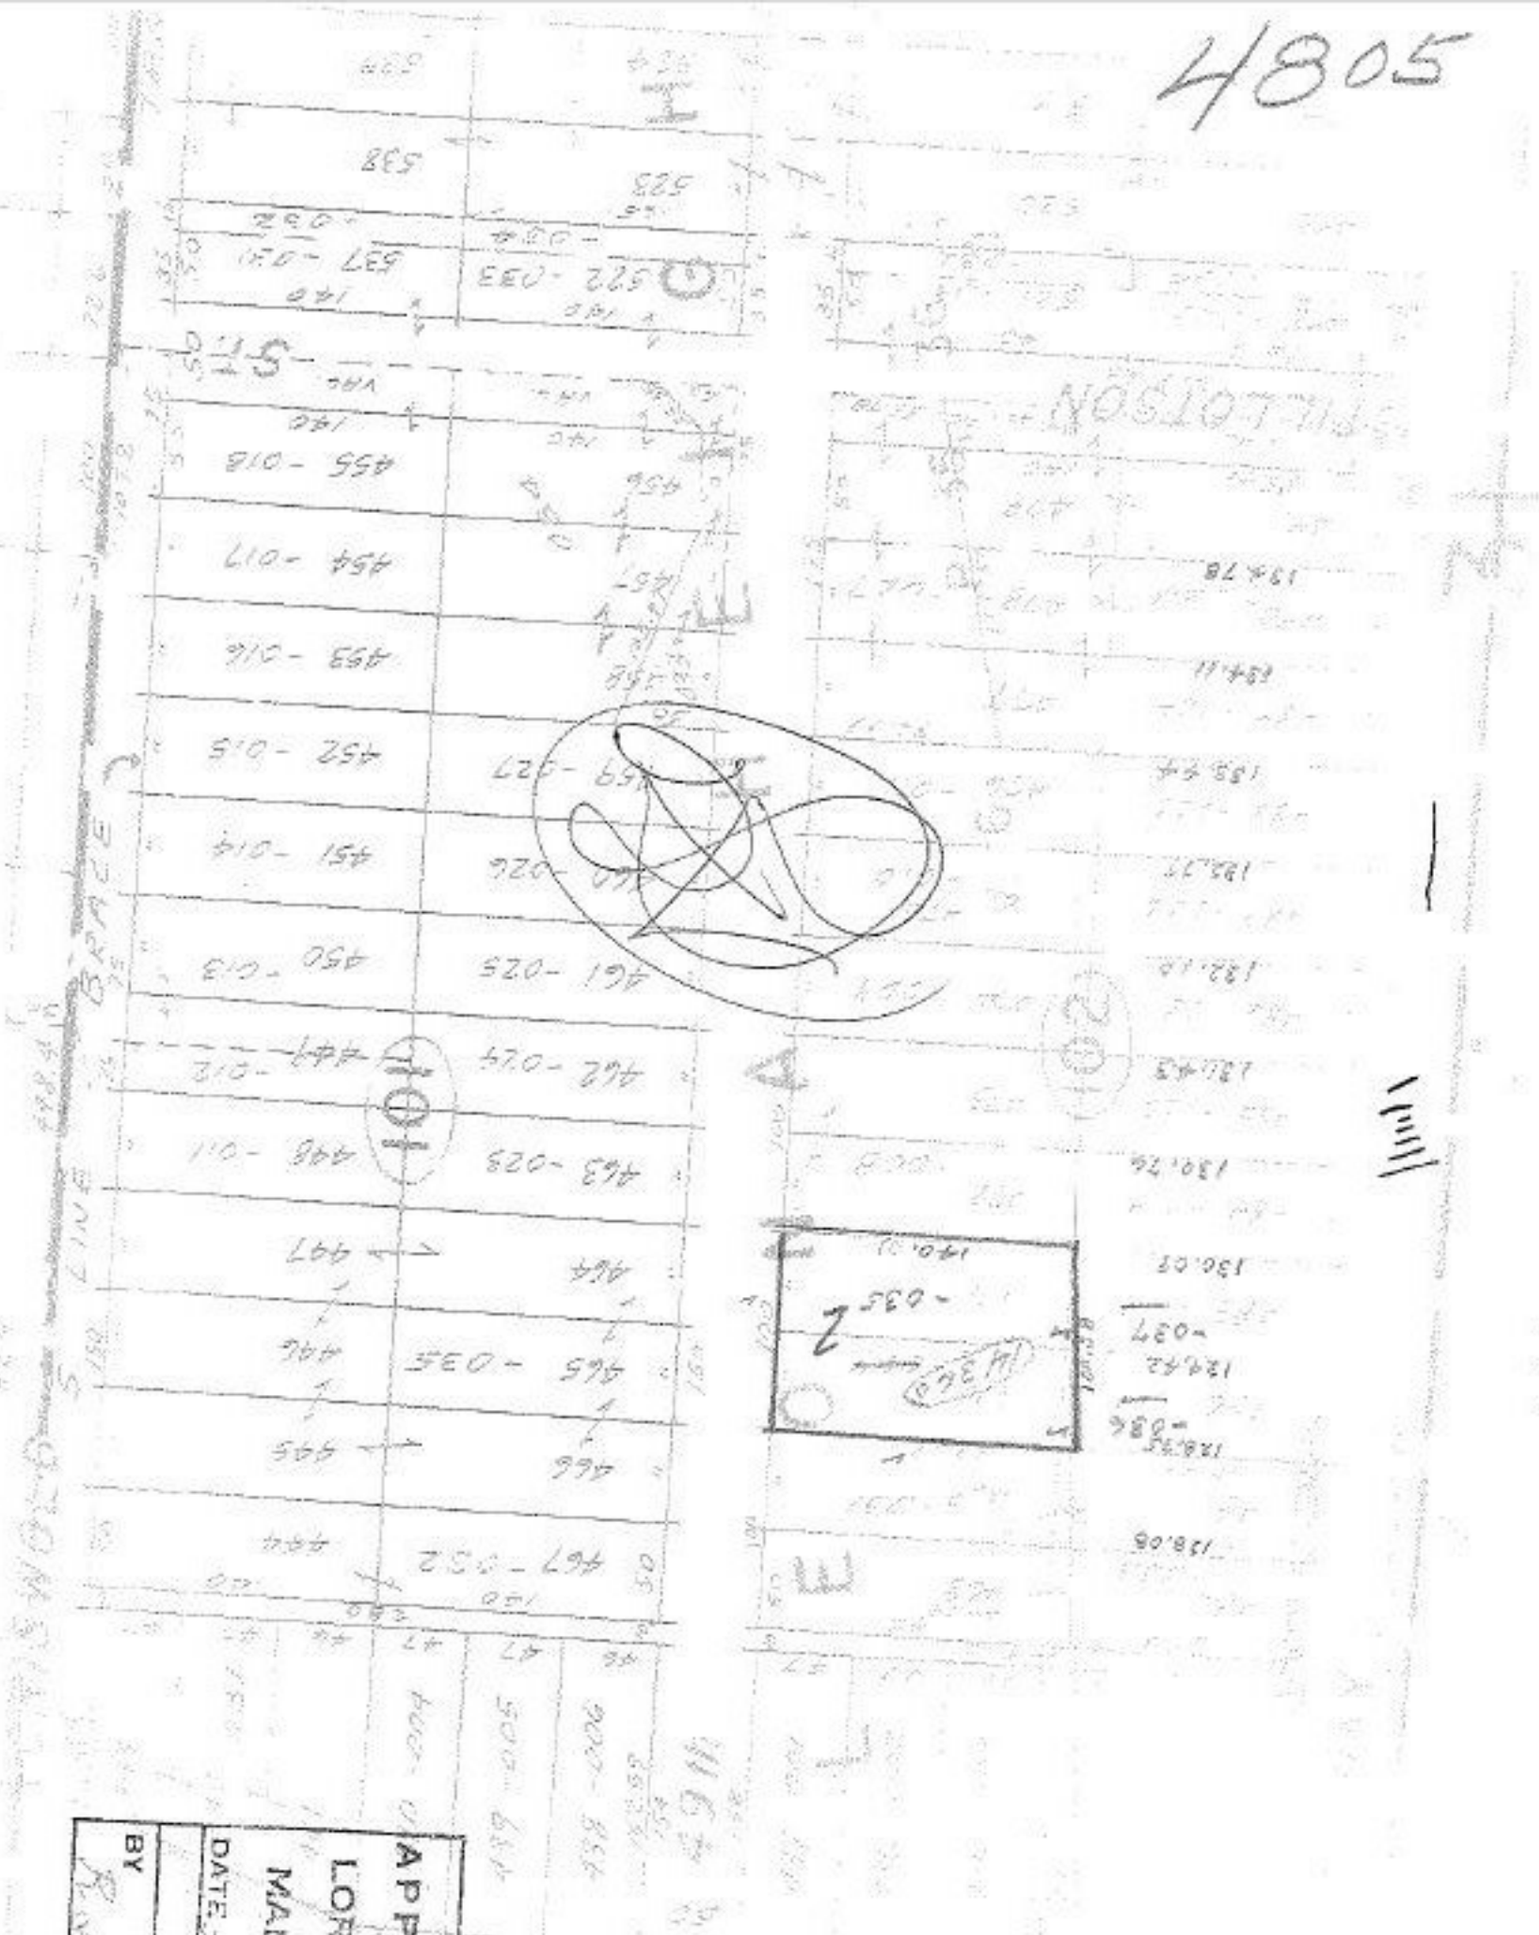

APPROVED
LORAIN CO.
MAP DEPT.
DATE 3/31/71
6-46
BY

MAY 7 ENT'D