4812
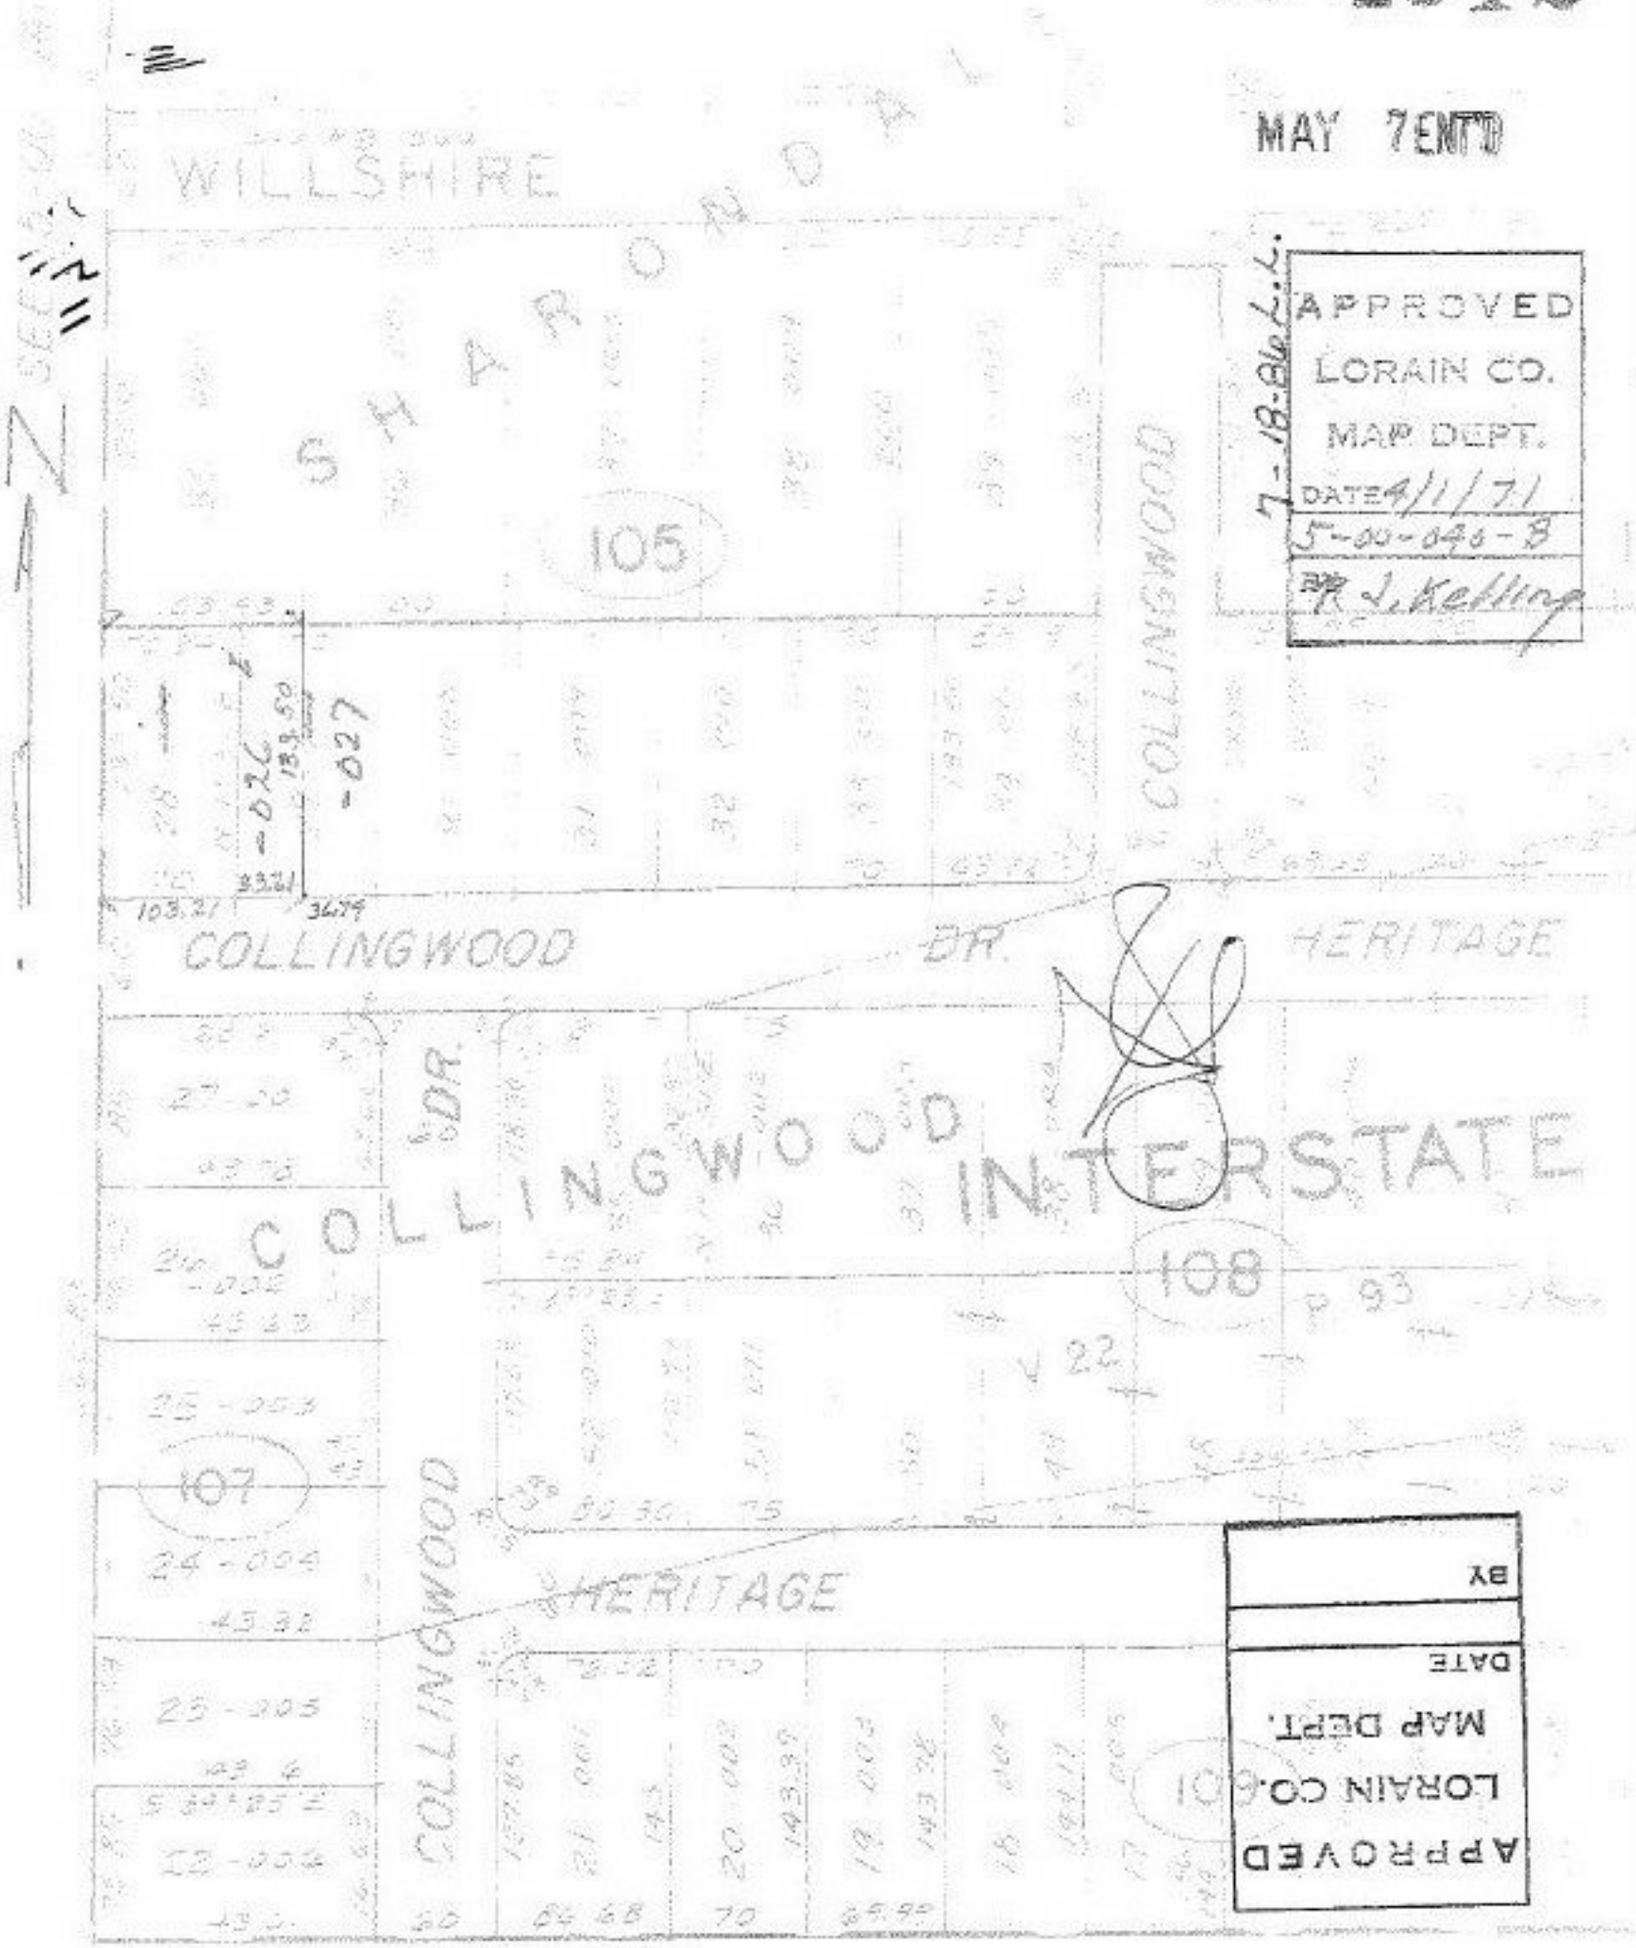
MAY 7 ENT'D