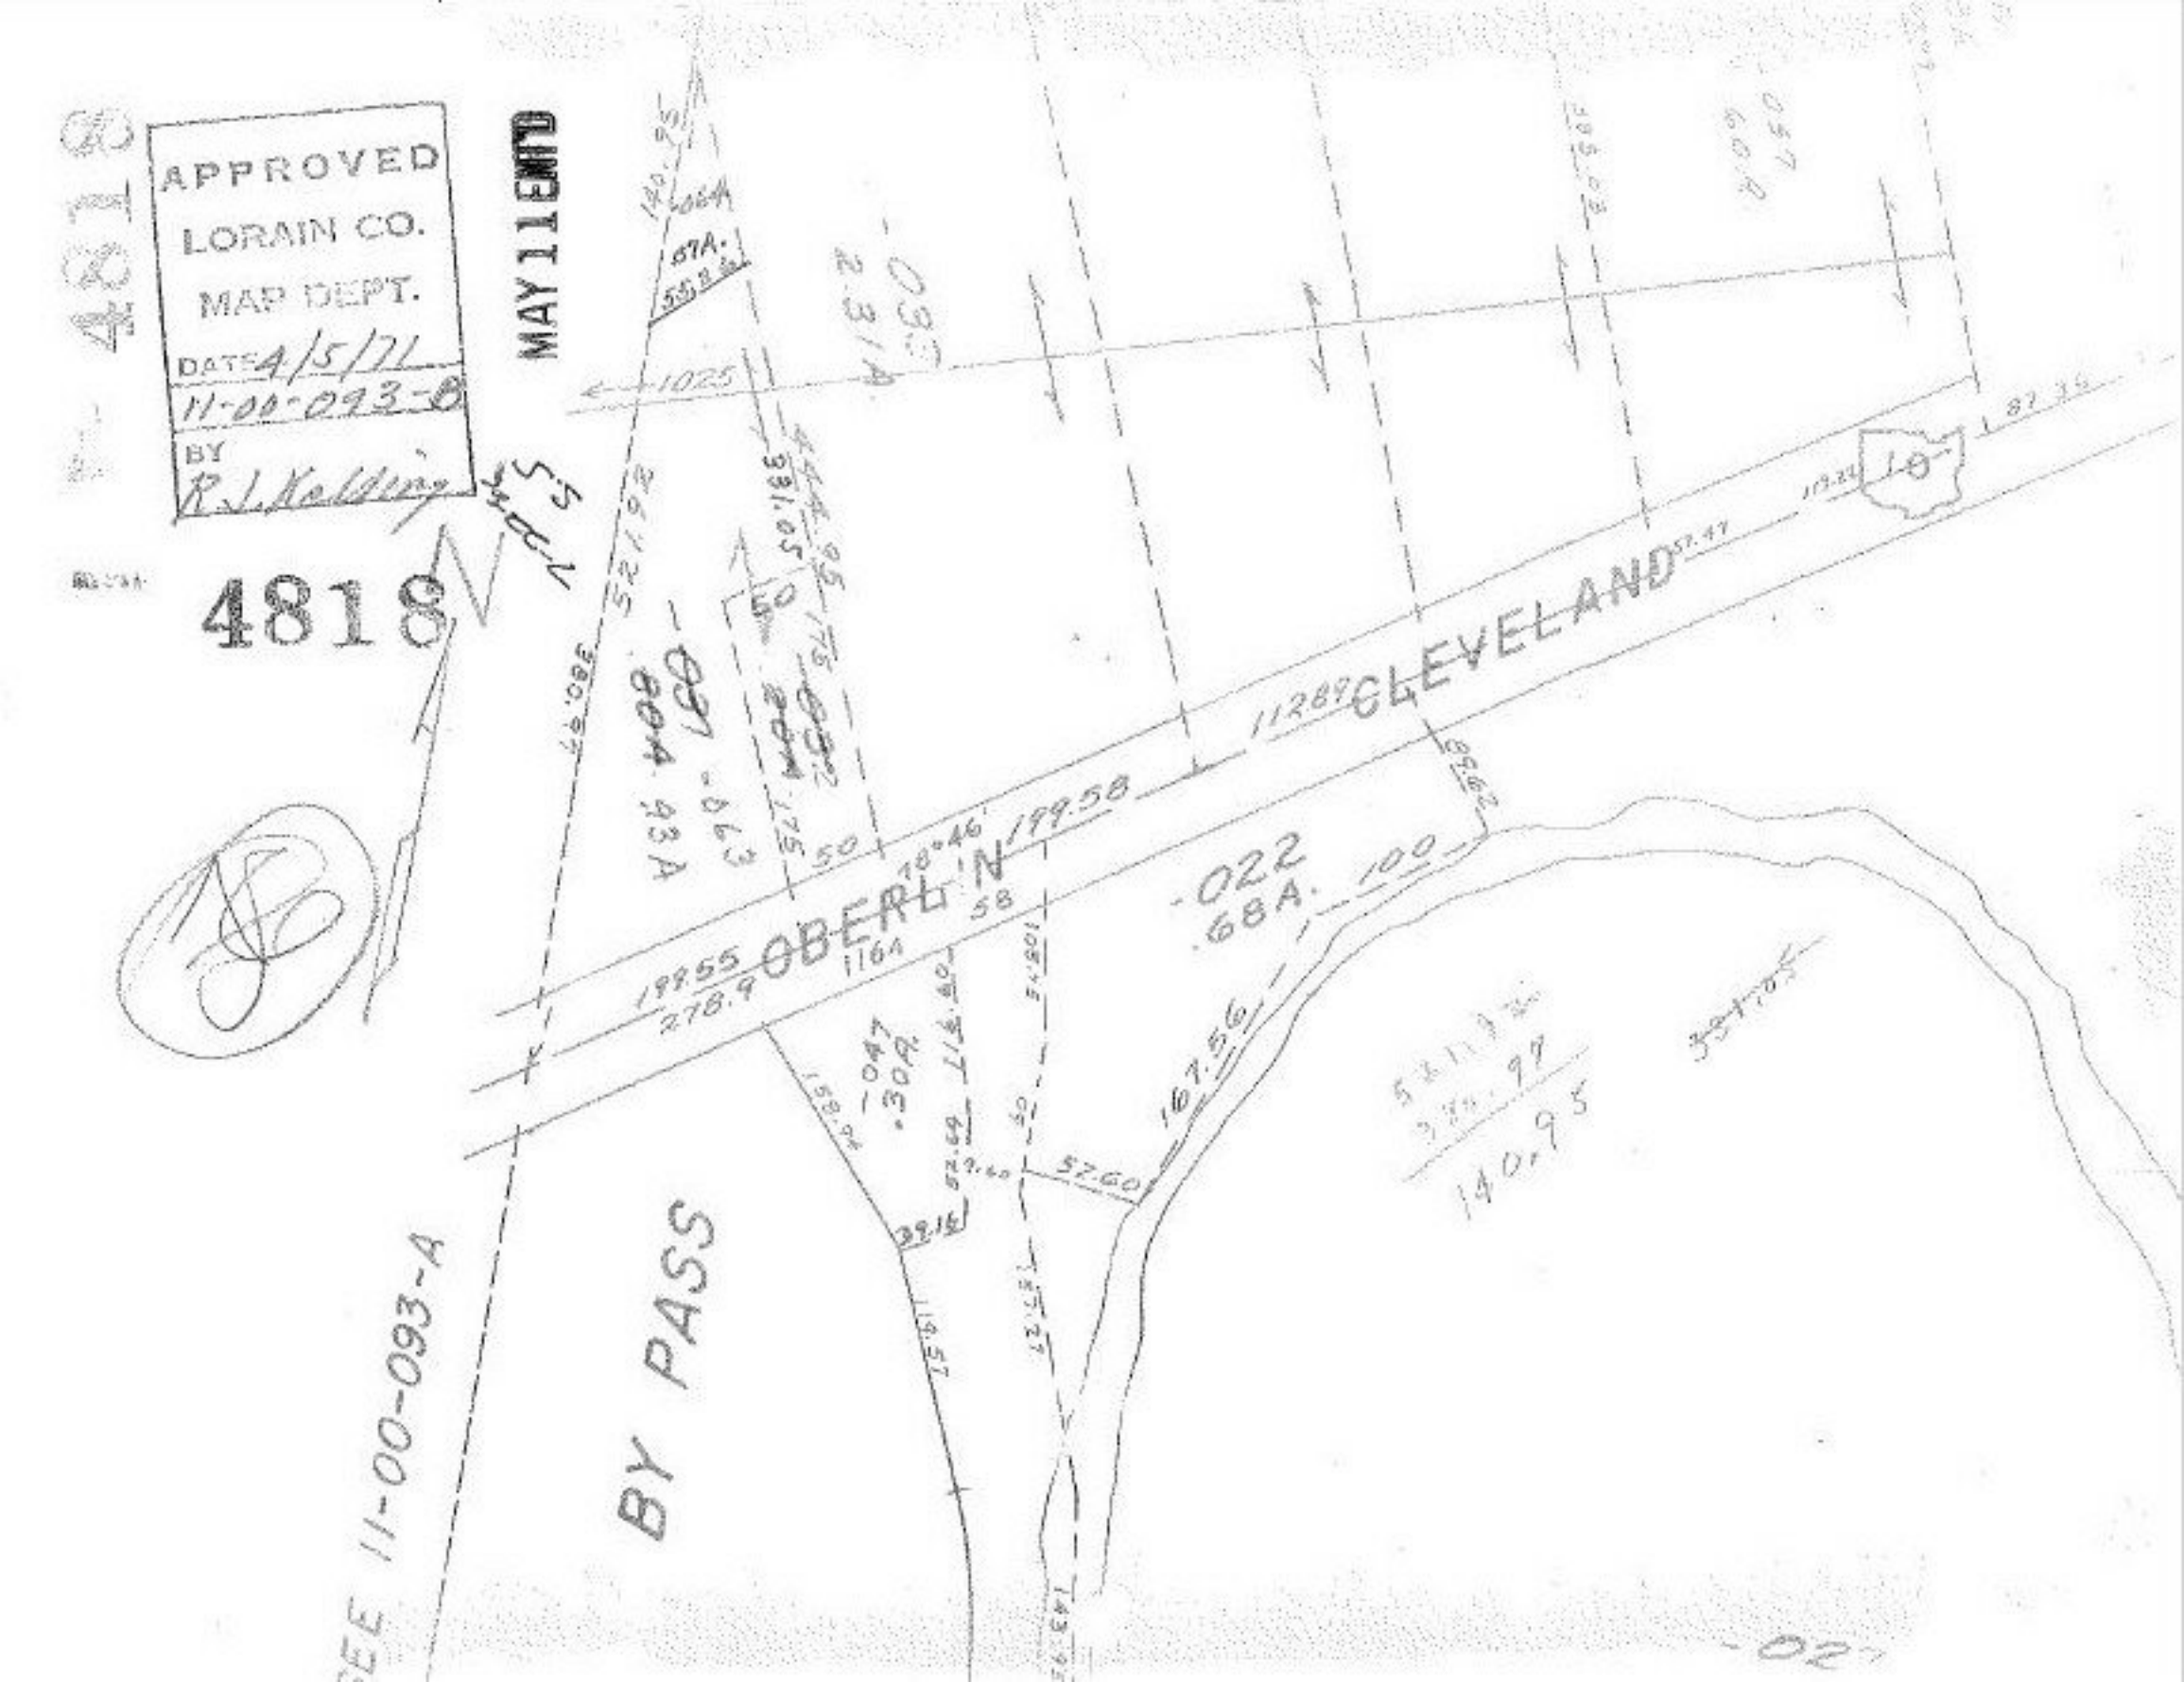
APPROVED
LORAIN CO.
MAP DEPT.
DATE 4/5/71
11-00-093-B
BY R.J. Kelly
MAY 11 EMTD
OBERLIN
CLEVELAND
BY PASS
11-00-093-A
-022
68A.
-093
2.31A
-047
.30A
-043
.93A
