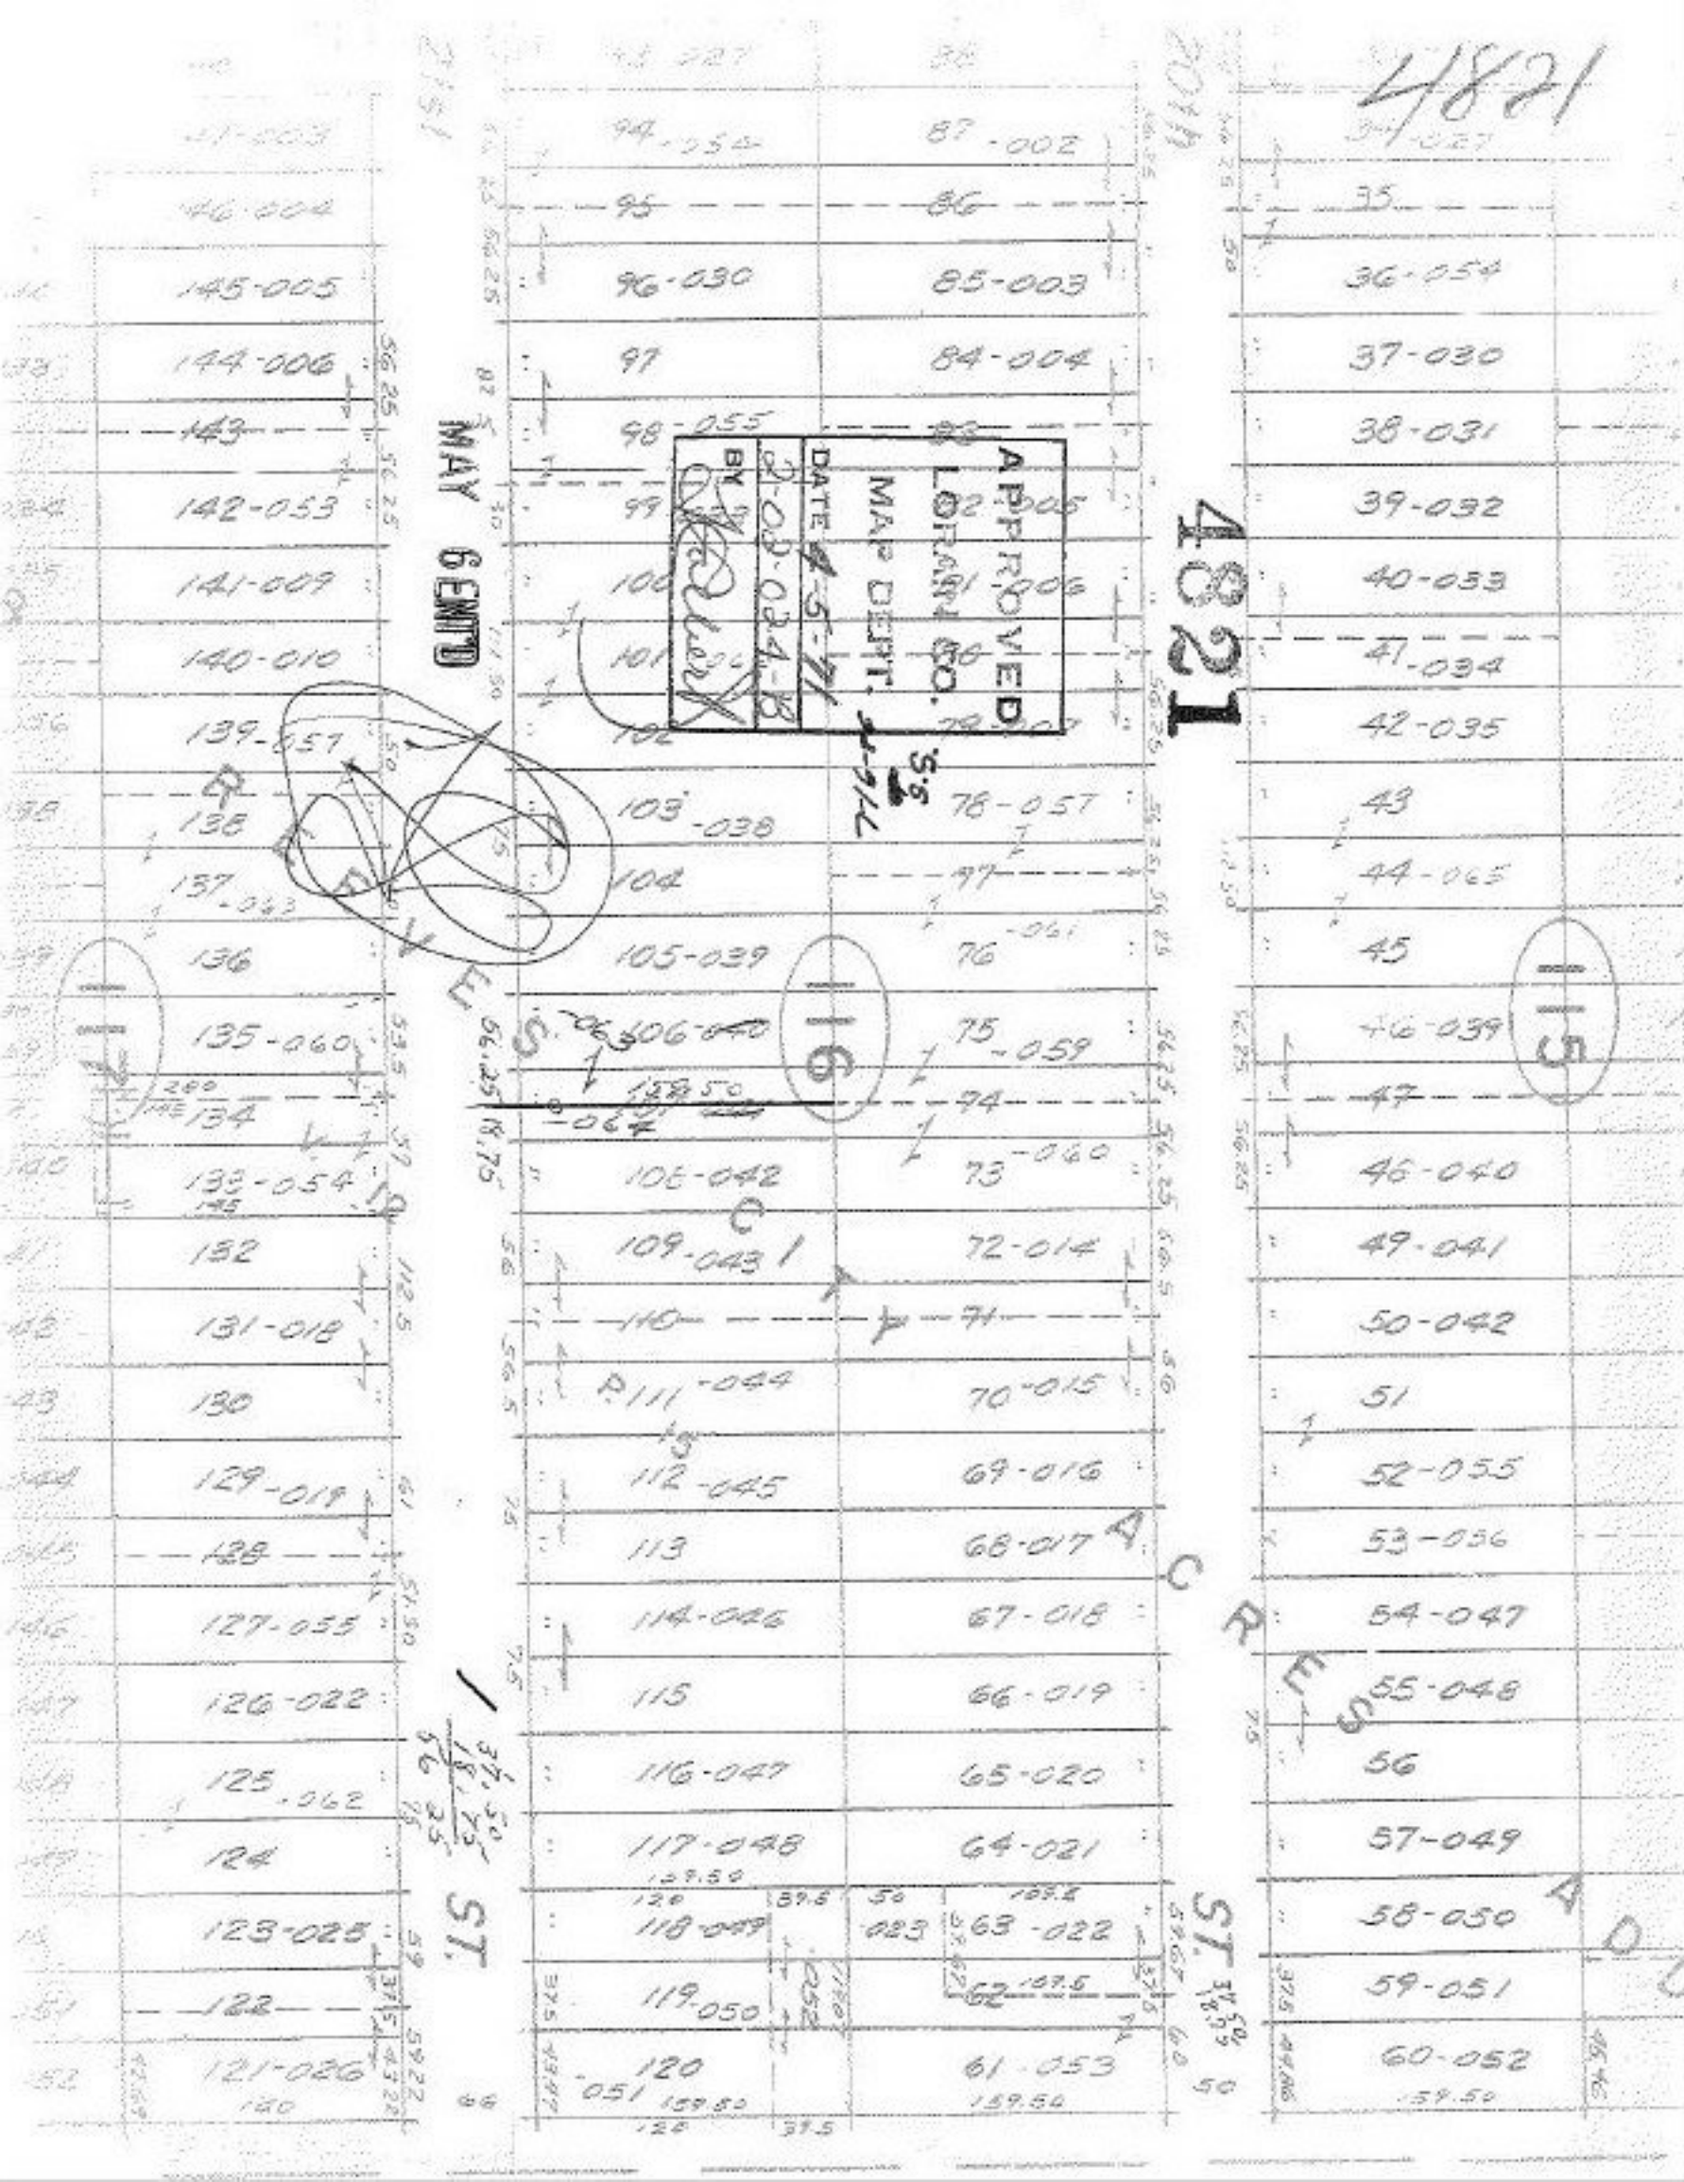
4821
1827
MAY & CMTD
ST.
ACRES
APPROVED
LOT 80
MAP DEPT.
DATE 4-5-71
2-Op-034-B
BY
S.S.
16
15
94-054
87-002
95
86
96-030
85-003
97
84-004
98-055
99
100
101
102
103-038
104
105-039
106-040
107
108-042
109-043
110
111-044
112-045
113
114-046
115
116-047
117-048
118-049
119-050
120-051
145-005
144-006
143
142-053
141-009
140-010
139-057
138
137-063
136
135-060
134
133-054
132
131-018
130
129-019
128
127-055
126-022
125-062
124
123-025
122
121-026
140
35
36-054
37-030
38-031
39-032
40-033
41-034
42-035
43
44-065
45
46-039
47
46-040
49-041
50-042
51
52-055
53-056
54-047
55-048
56
57-049
58-050
59-051
60-052
159.50
78-057
97
76-061
75-059
94
73-060
72-014
71
70-015
69-016
68-017
67-018
66-019
65-020
64-021
63-022
62
61-053
159.50