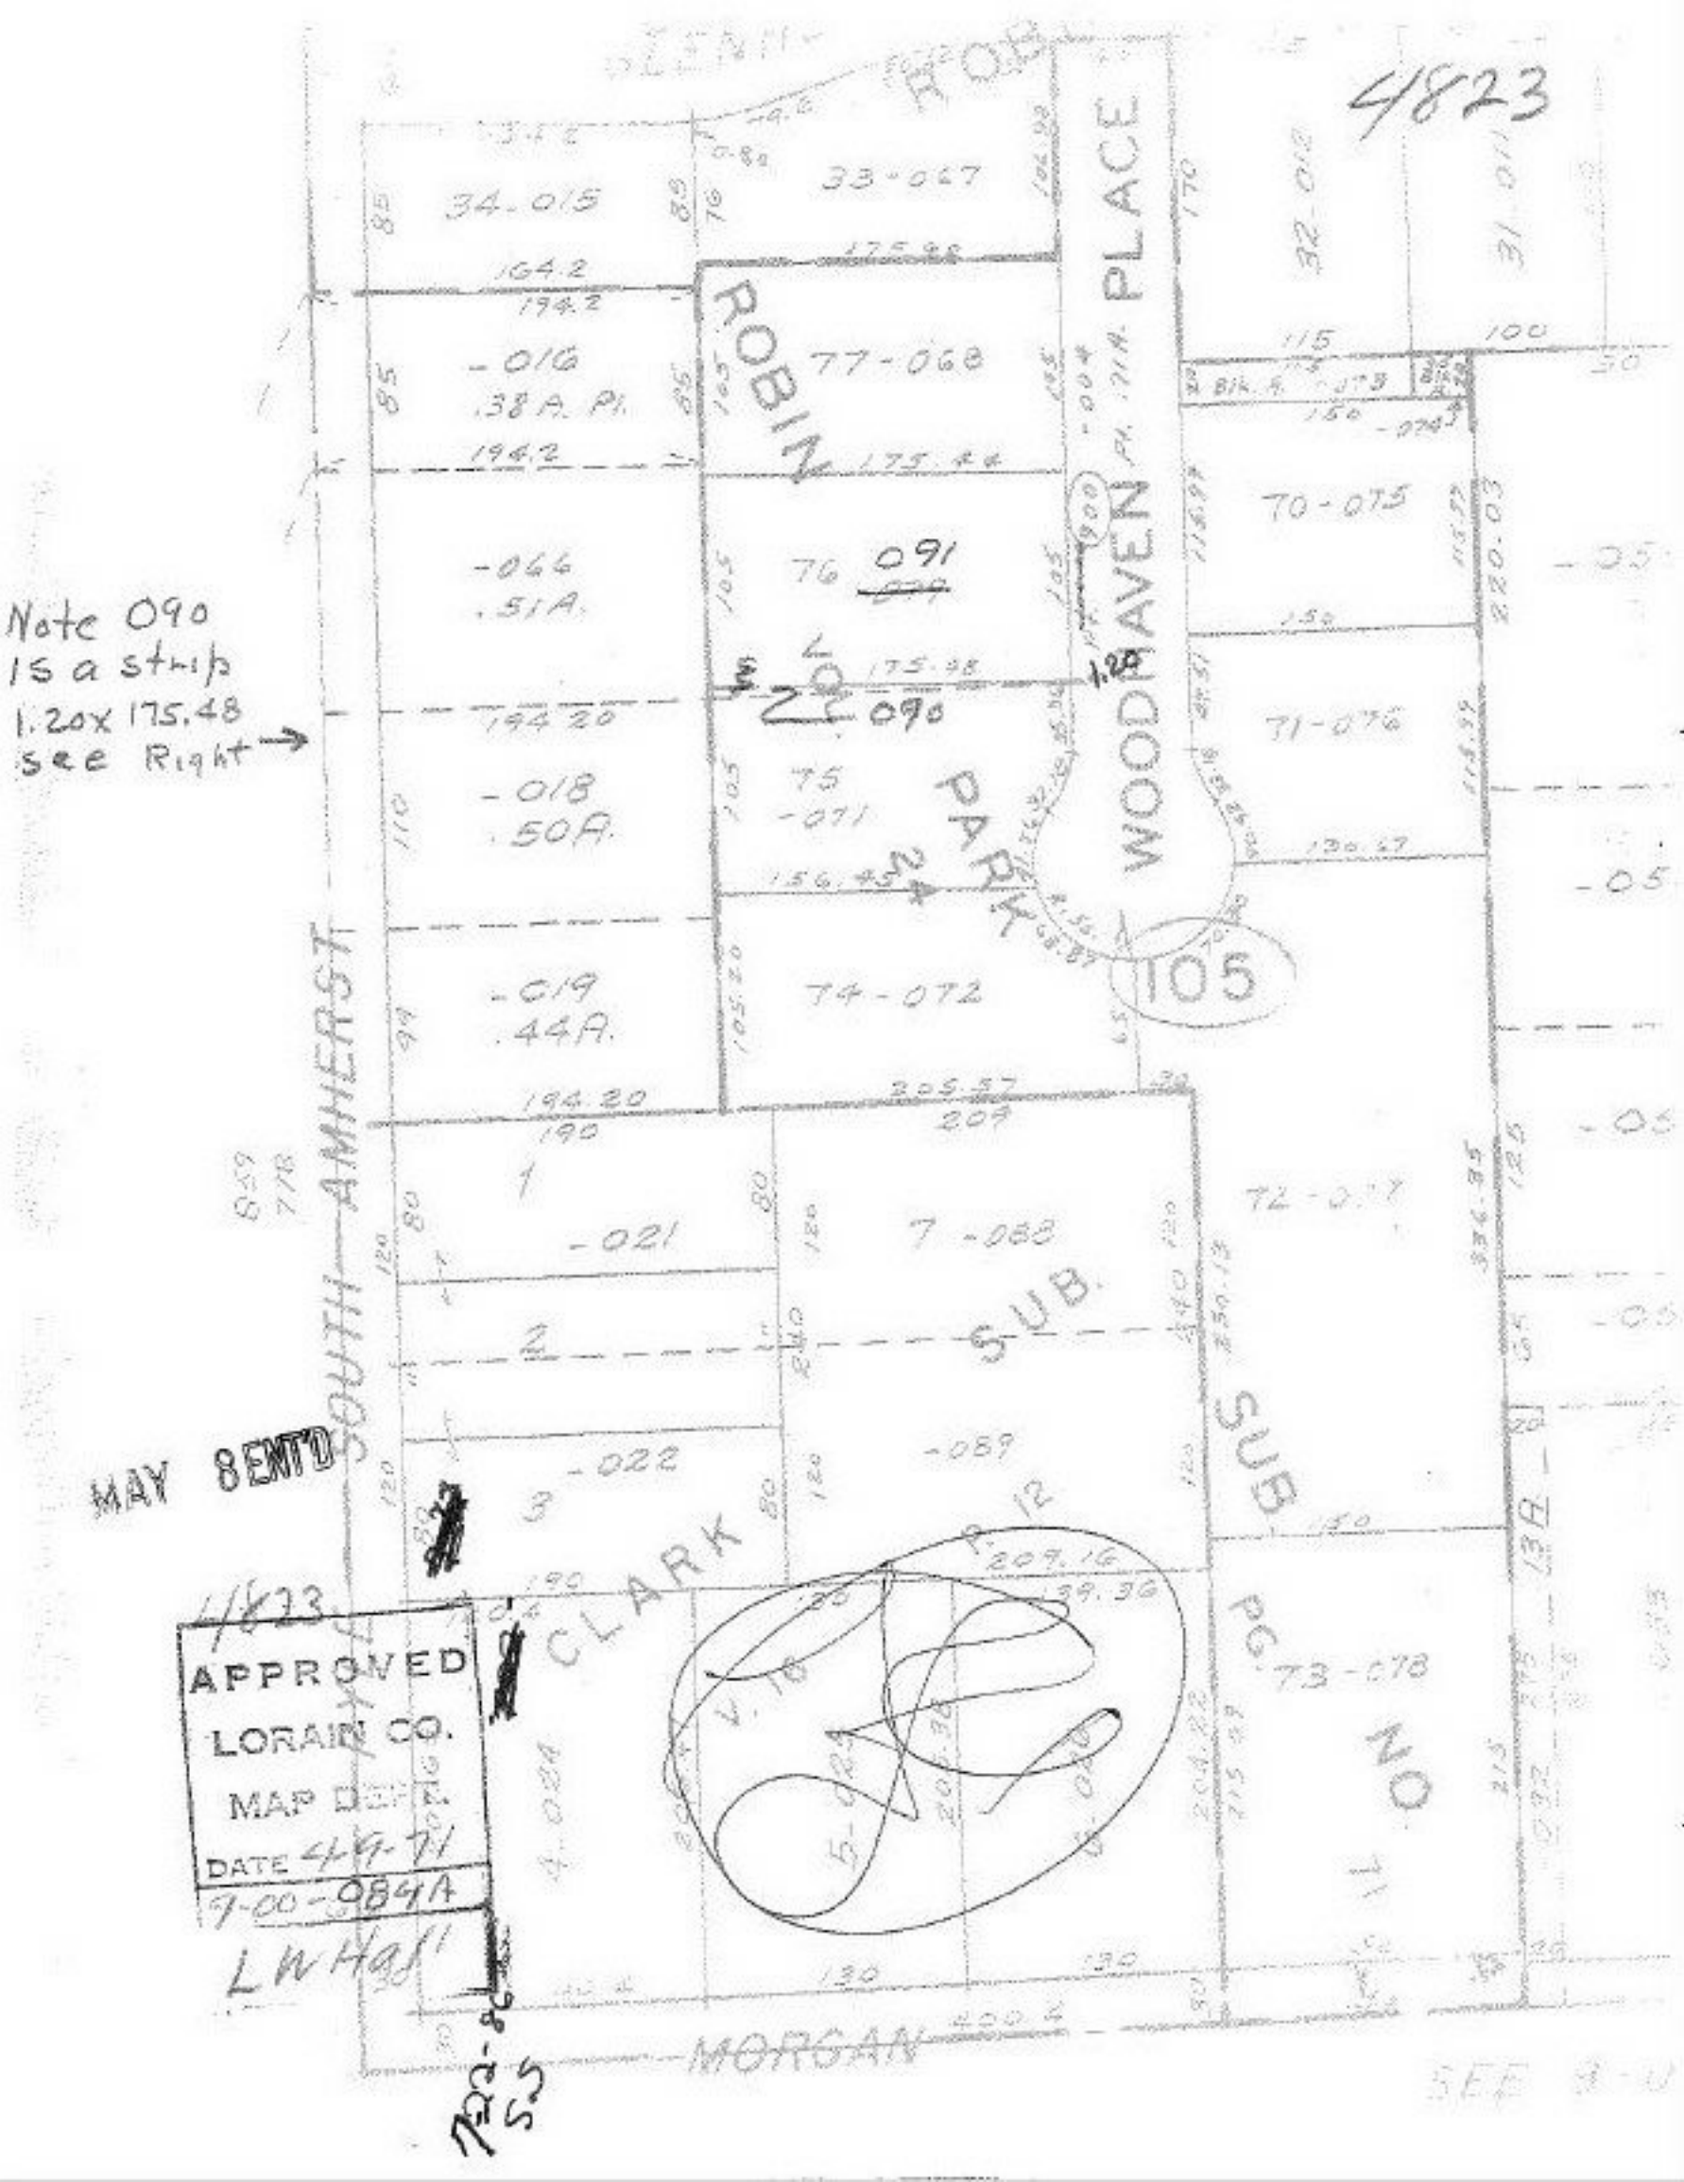
4823
Note 090
is a strip
1.20x 175.48
see Right
ROBIN
PLACE
WOODHAVEN
PARK
SOUTH AMHERST
CLARK
SUB.
SUB.
PG. NO.
MORGAN
105
34-015
33-067
-016
.38 A. Pl.
77-068
-066
.51A.
76 091
090
-018
.50A.
75
-071
-019
.44A.
74-072
70-075
71-076
72-077
73-078
-021
7-088
-022
-089
1
2
3
MAY 8 ENT'D
4823
APPROVED
LORAIN CO.
MAP DEPT.
DATE 4-9-71
9-00-084A
LW Hall
722-86
SS