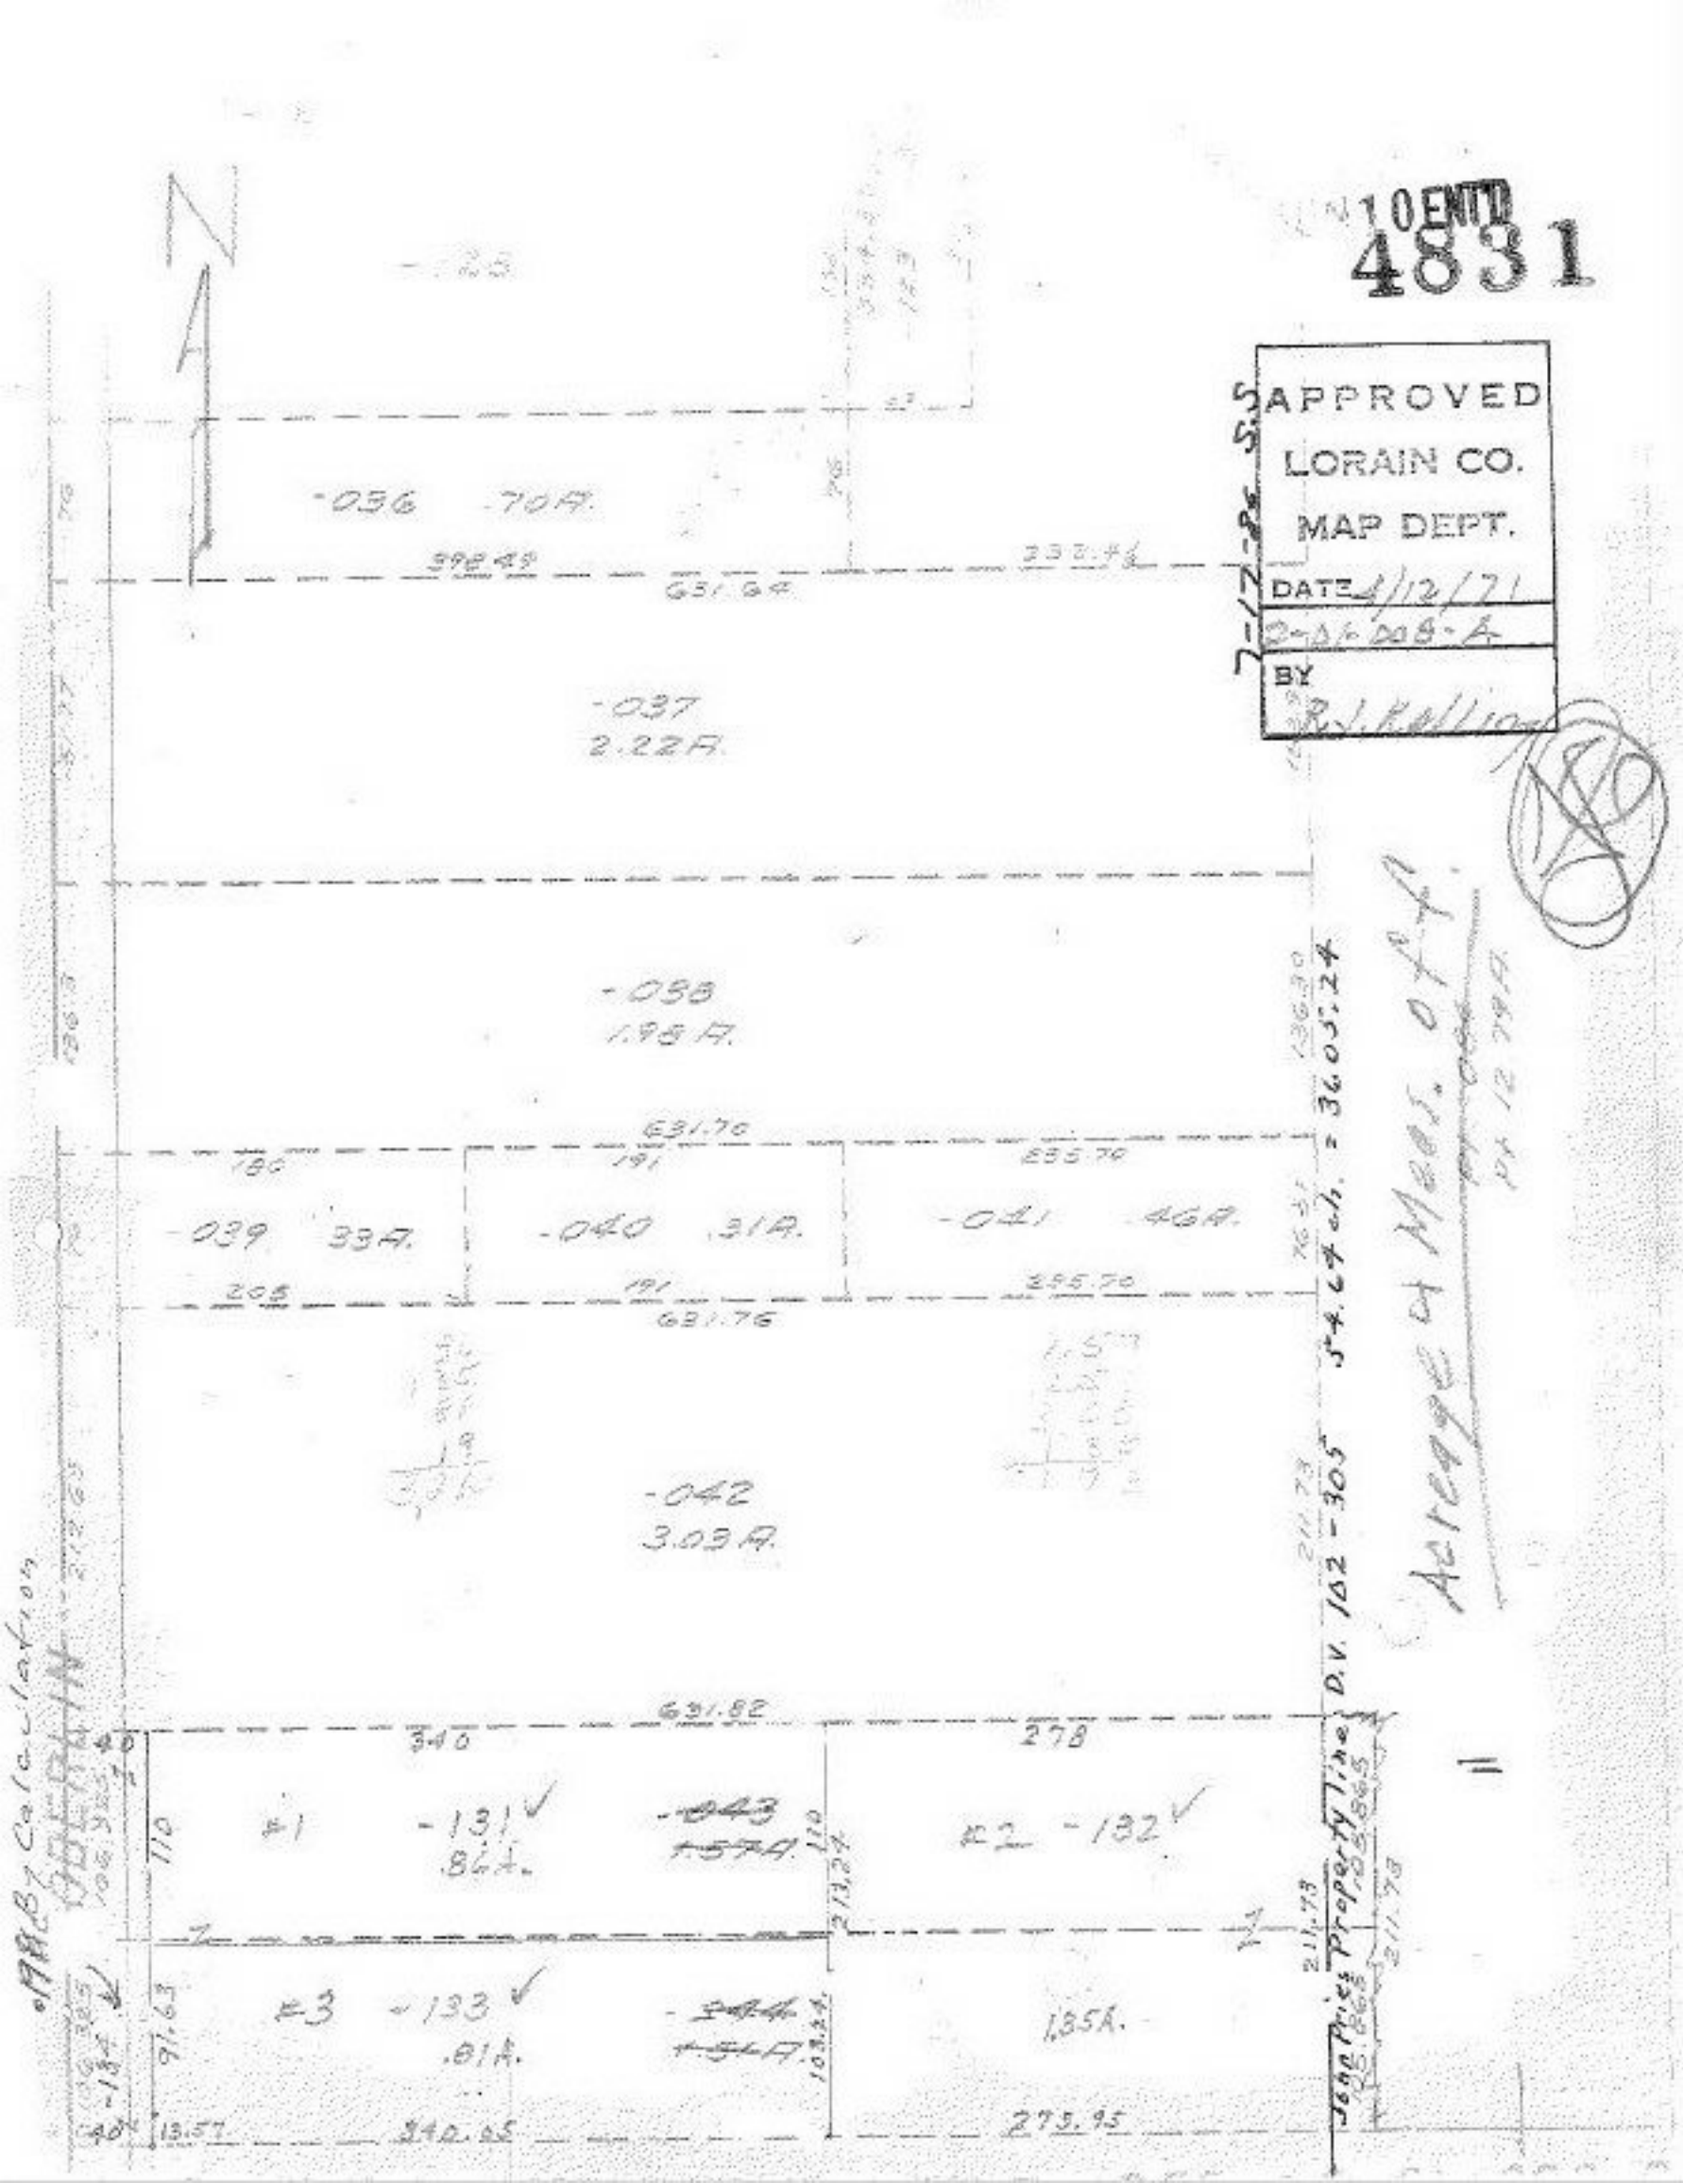
10 ENTD
4831
APPROVED
LORAIN CO.
MAP DEPT.
DATE 4/12/71
2-A-208-A
BY R.J. Kellion
7-12-71 S.S.
-036 .70A.
-037
2.22A.
-038
1.98A.
-039 .33A.
-040 .31A.
-041 .46A.
-042
3.03A.
#1 -131 .84A.
-043 .55A.
#2 -132
#3 -133 .81A.
1.85A.
631.70
631.76
631.82
635.70
340
278
275.95
340.65
211.73
211.24
D.V. 102-305
34.67 ac.
= 36.05.24
Average of Meas. of 4
Adjusted by Calculations
Joan Price's Property Line
R.S. 2865