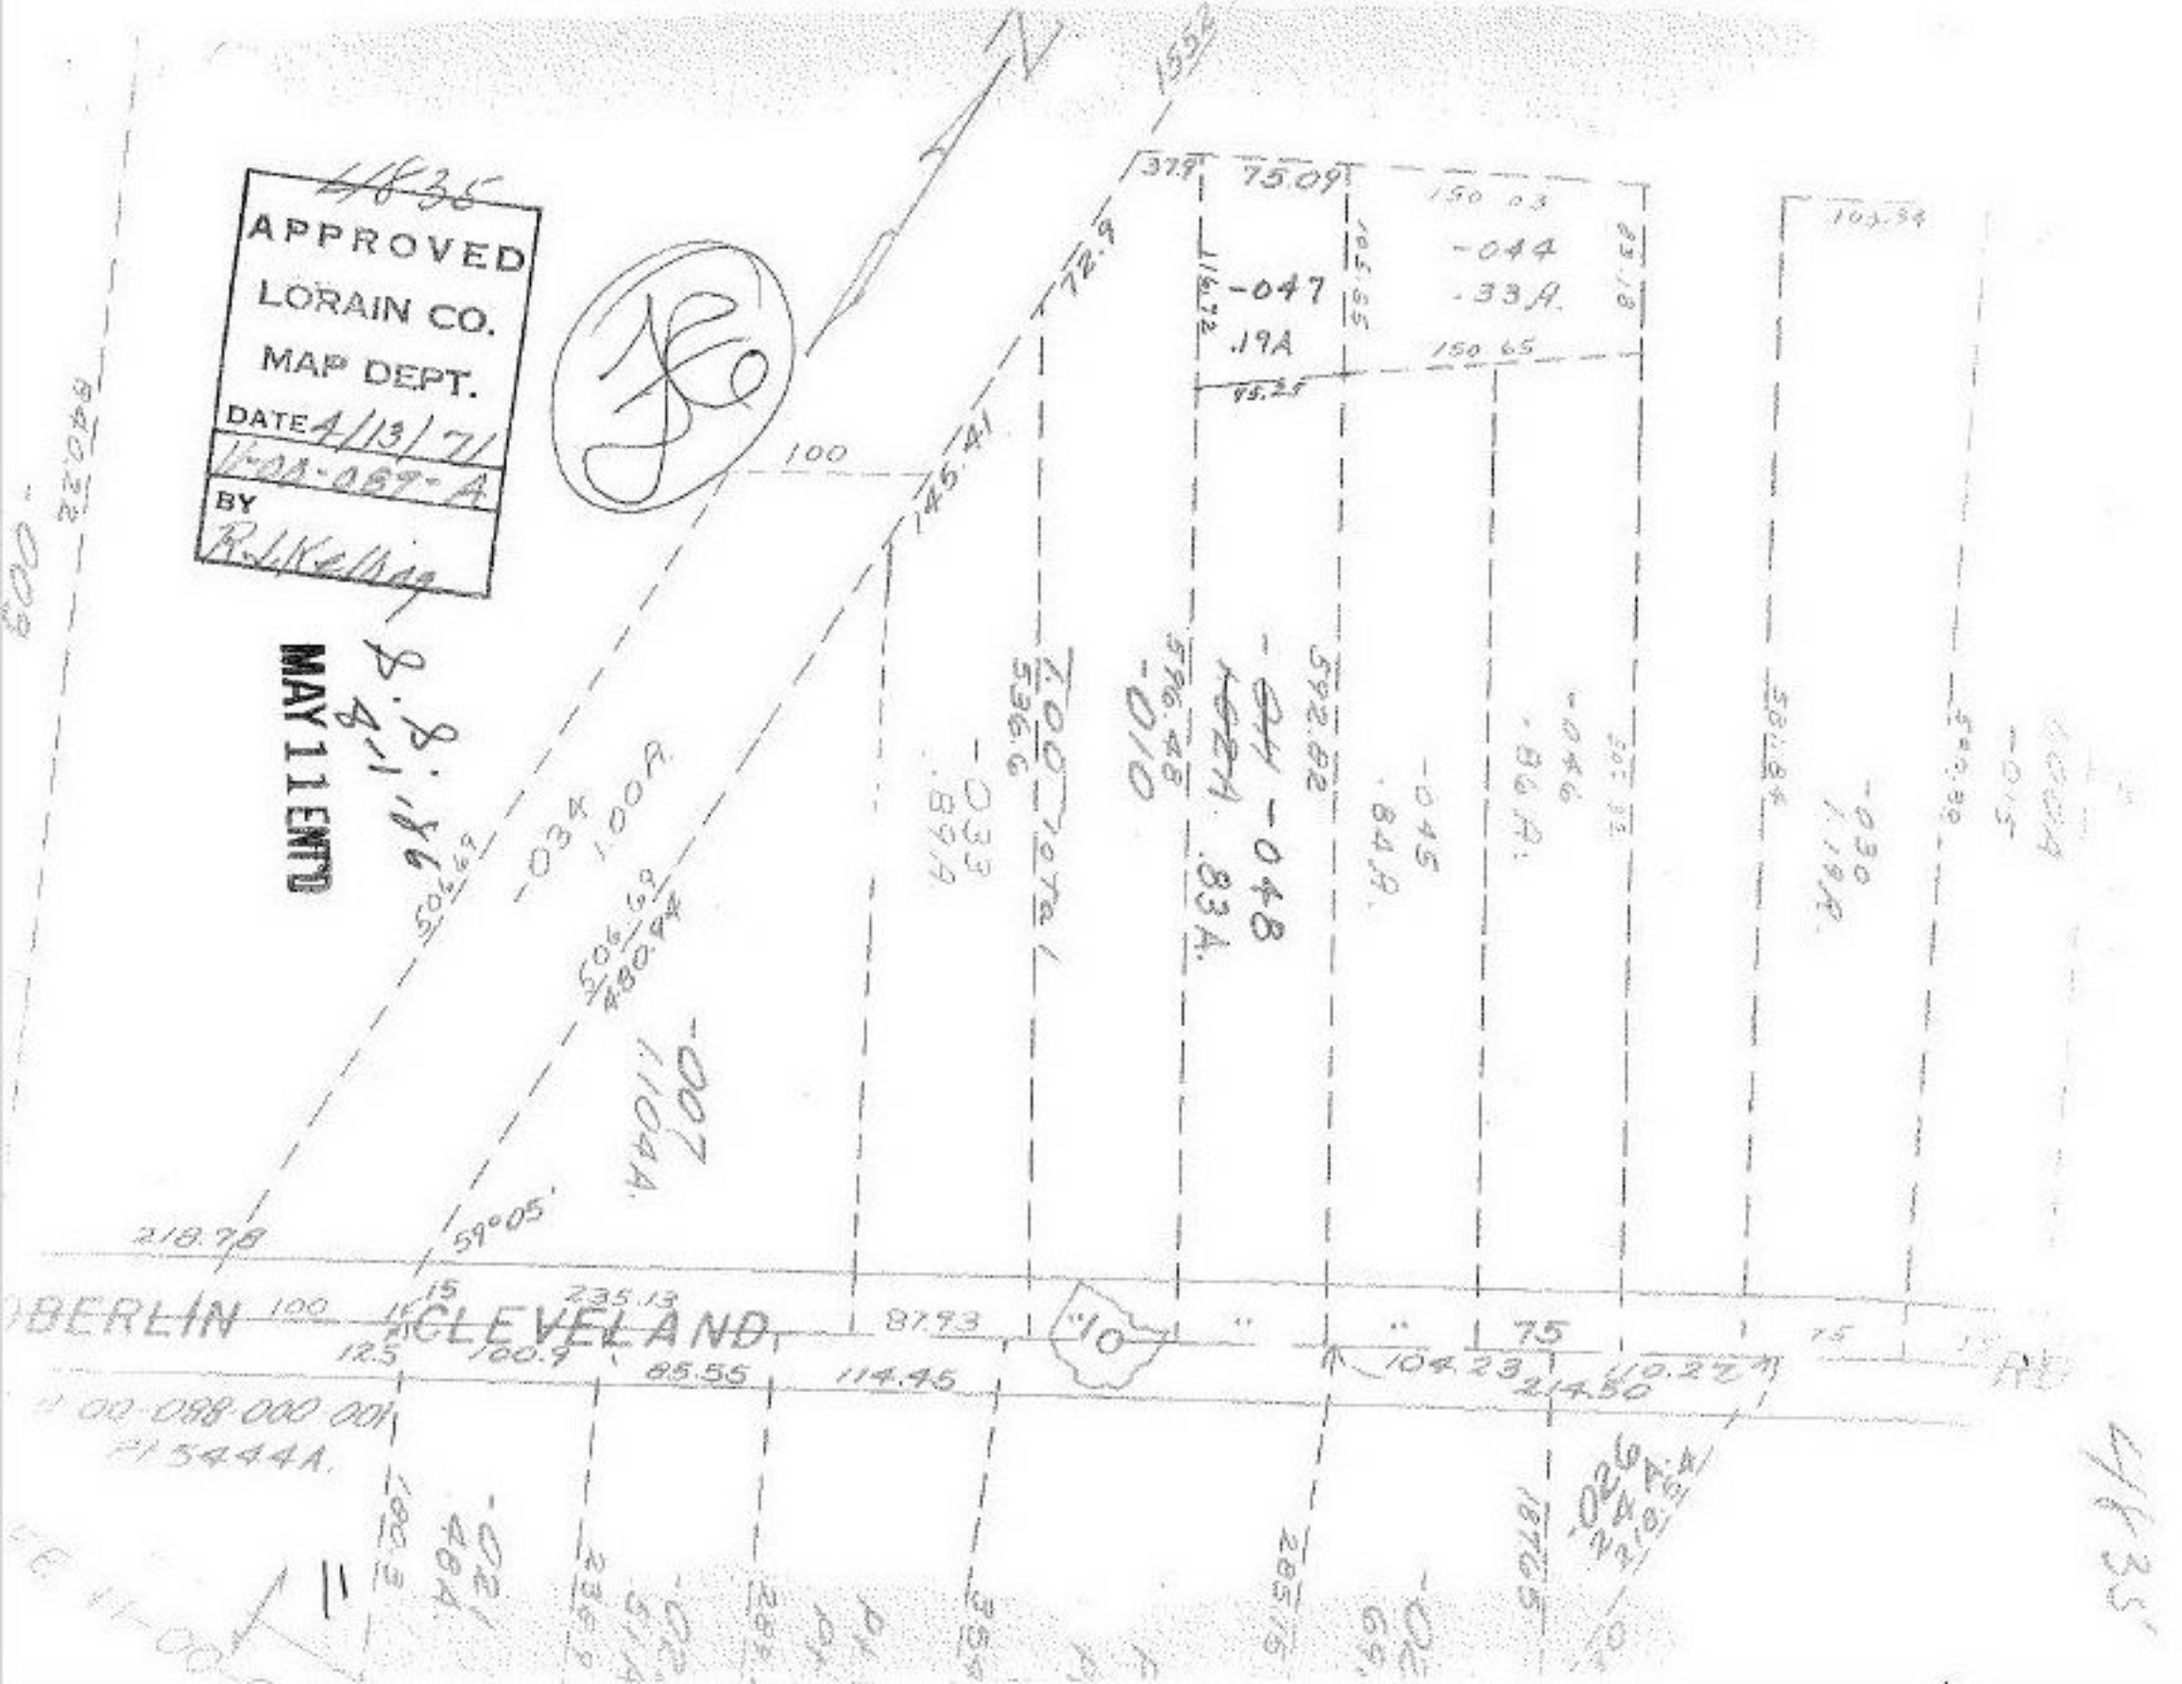
APPROVED
LORAIN CO.
MAP DEPT.
DATE 4/13/71
4-01-057-A
BY
-047
.19A
-044
.33A.
-048
.83A.
-045
.84A.
-046
.86A.
BERLIN
CLEVELAND
100
15
235.13
87.93
75
75
12.5
100.9
85.55
114.45
104.23
214.50
10.22
218.78
59°05'
146.41
72.9
100
75.09
150.03
150.65
95.25
118.72
105.55
10.54
506.69
480.94
506.69
596.22
