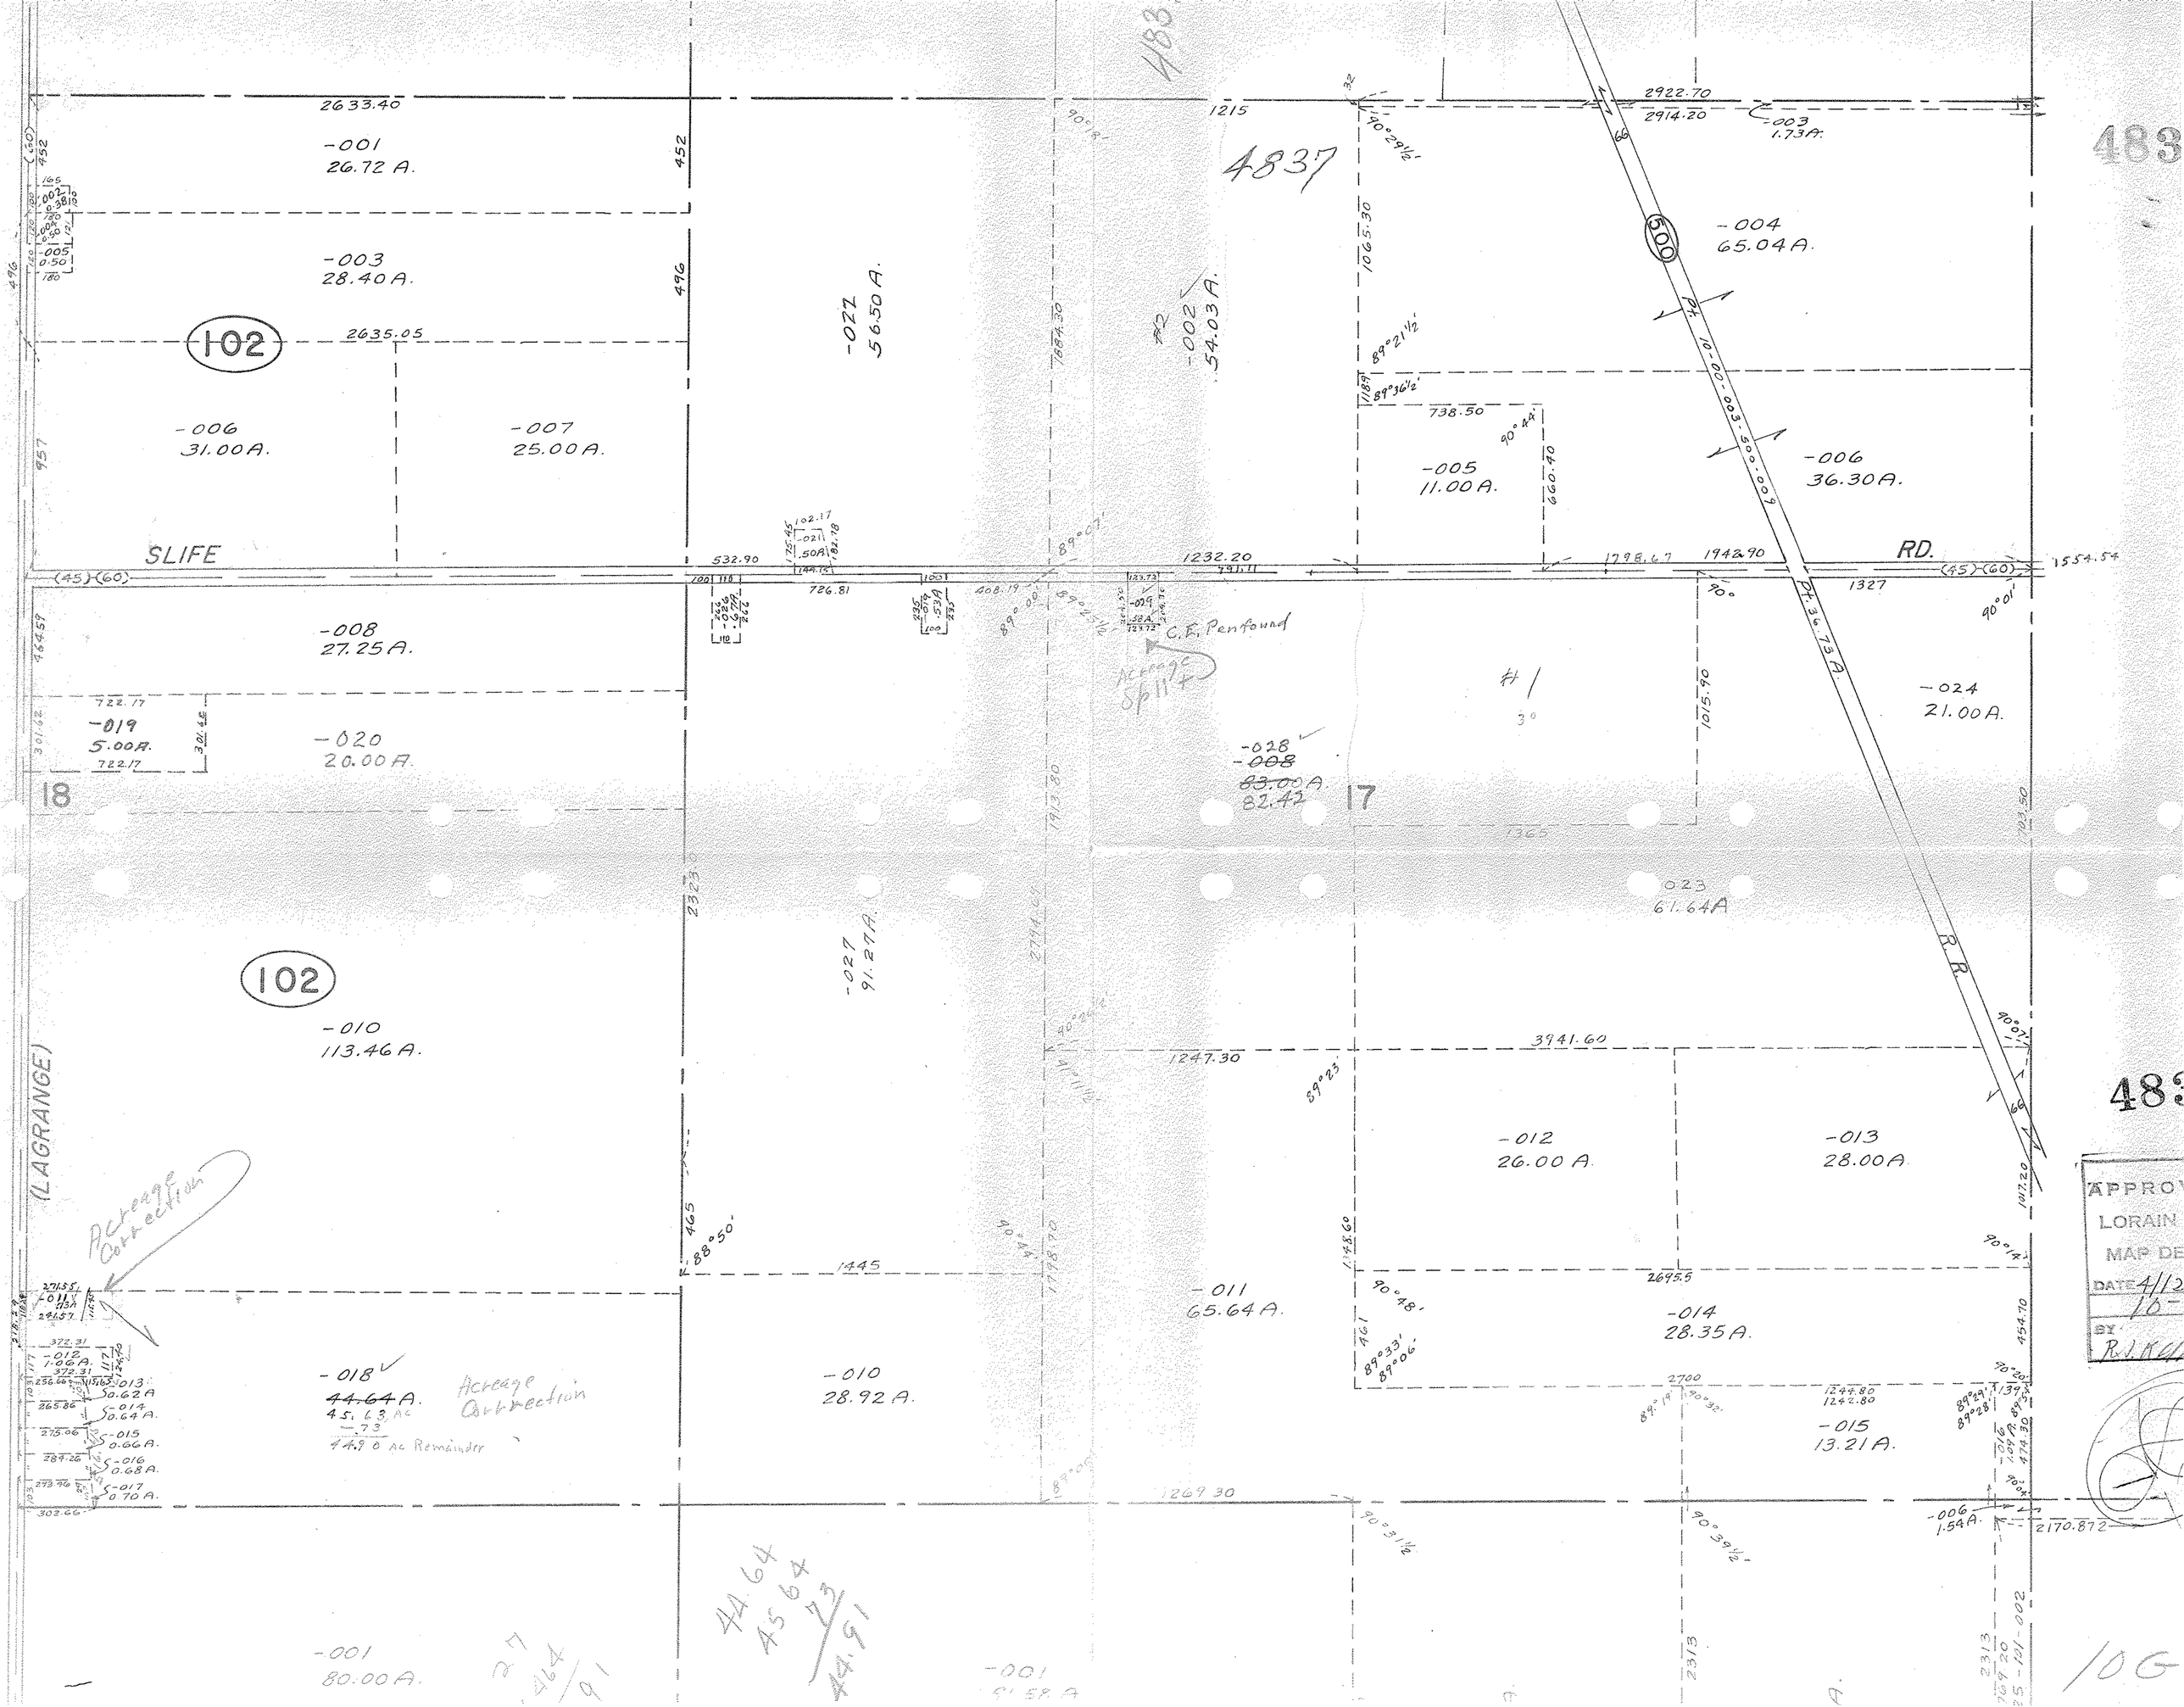

483
4837
2633.40
-001
26.72 A.
-003
28.40 A.
102
2635.05
-006
31.00 A.
-007
25.00 A.
-022
56.50 A.
-002
54.03 A.
1215
2922.70
2914.20
-003
1.73 A.
-004
65.04 A.
500
-005
11.00 A.
-006
36.30 A.
SLIFE
RD.
532.90
1232.20
1798.67
1942.90
1554.54
1327
-008
27.25 A.
-019
5.00 A.
-020
20.00 A.
C.E. Penfound
Acreage Split
-028
~~-008~~
~~83.00~~ A.
82.42
#1
-024
21.00 A.
18
17
-027
91.27 A.
023
61.64 A
102
-010
113.46 A.
(LAGRANGE)
3941.60
1247.30
-012
26.00 A.
-013
28.00 A.
Acreage Correction
-018
~~44.64~~ A.
45.63 Ac
-.73
44.90 Ac Remainder
Acreage Correction
-010
28.92 A.
-011
65.64 A.
-014
28.35 A.
-015
13.21 A.
1269.30
-006
1.54 A.
2170.872
-001
80.00 A.
44.64
45.64
.73
44.91
-001