4842

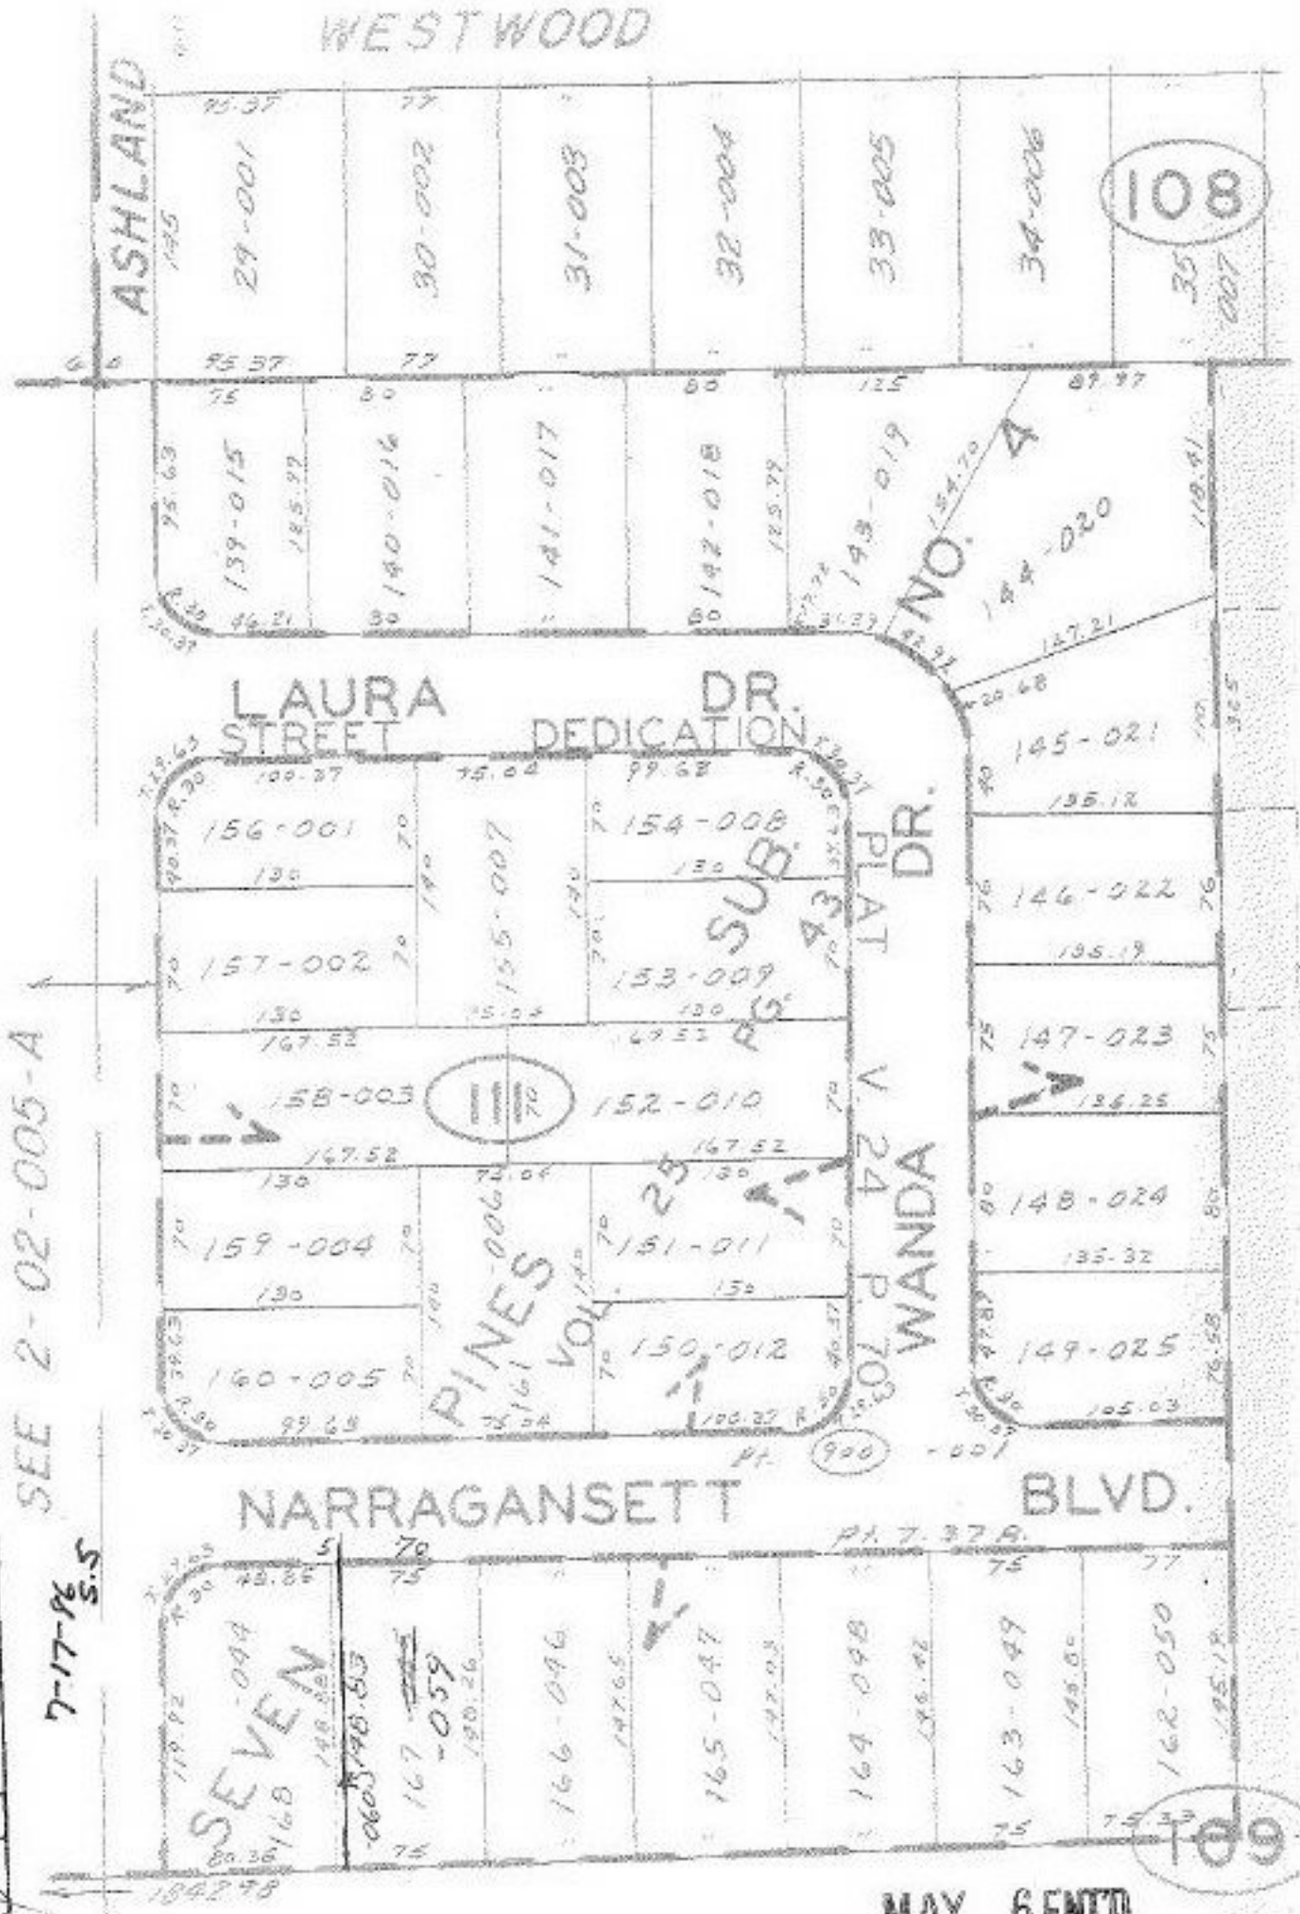

4842

APPROVED
LORAIN CO.
MAP DEPT.
DATE 4-14-71
2-02-005-B
BY

7-17-96 S.S.

MAY 6 ENT'D