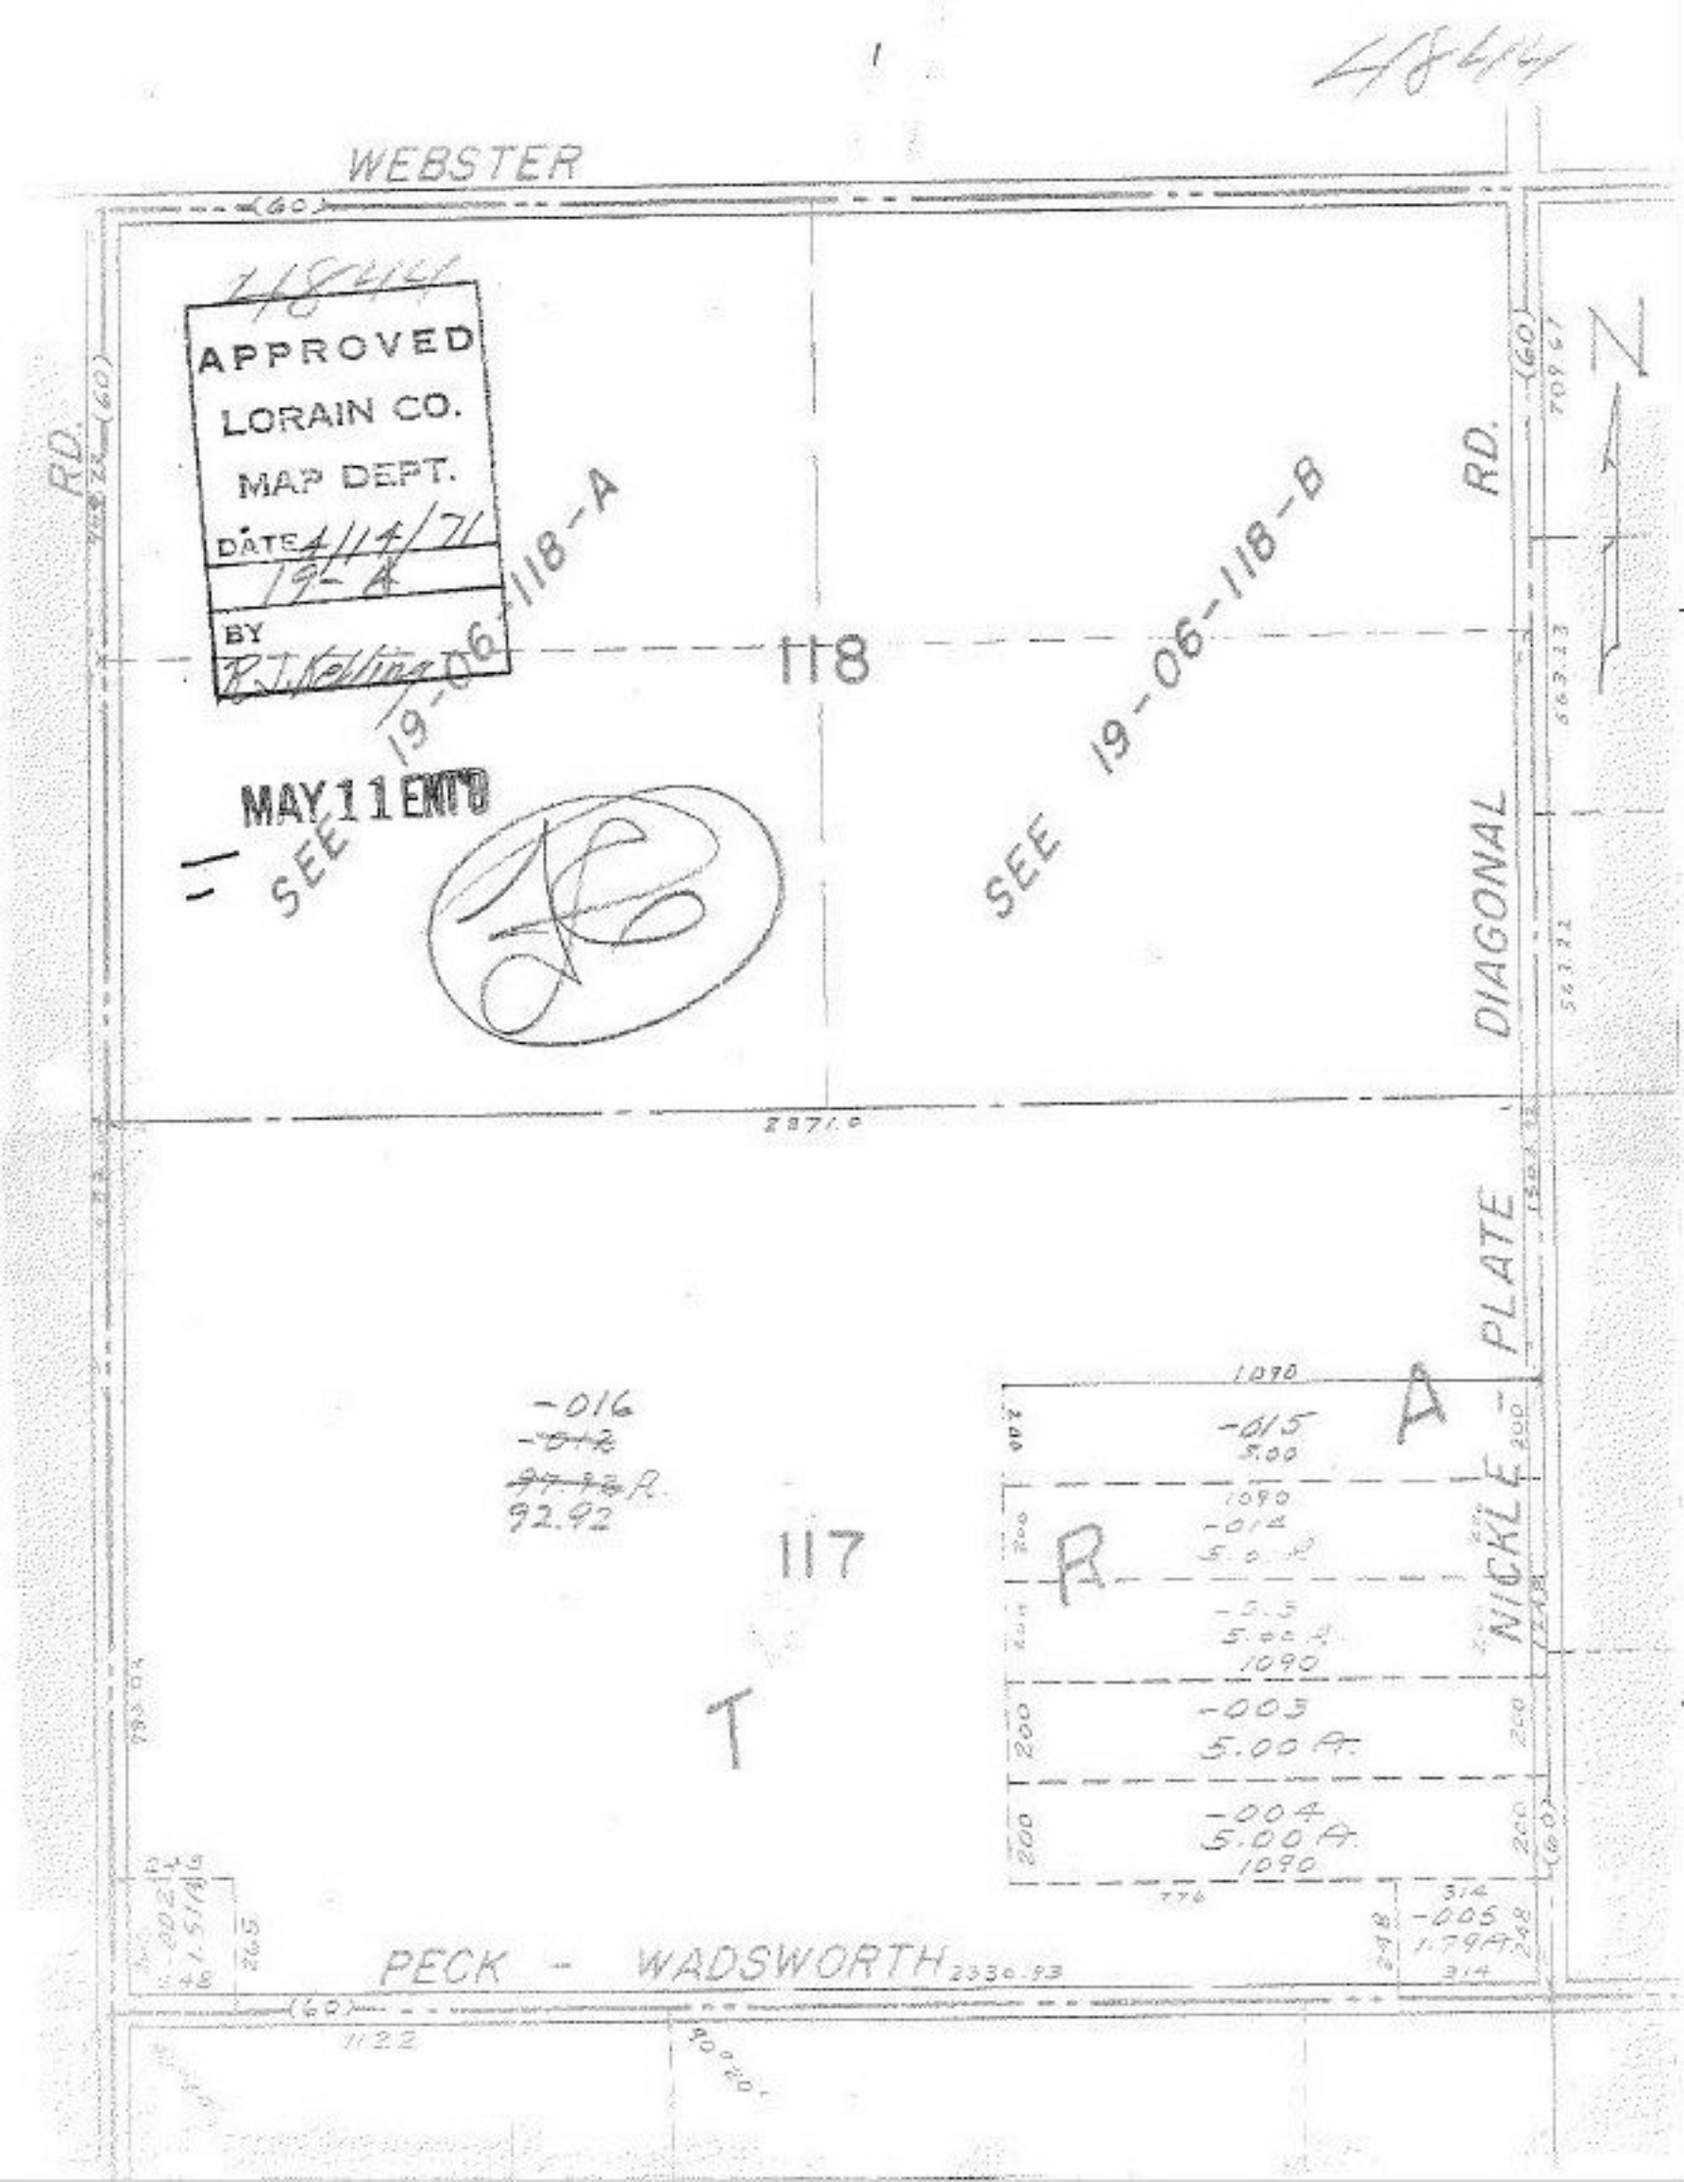

4844
WEBSTER
(60)
APPROVED
LORAIN CO.
MAP DEPT.
DATE 4/14/71
19-A
BY
R.J. Kelling
MAY 11 ENT'D
SEE 19-06-118-A
SEE 19-06-118-B
118
117
RD.
DIAGONAL
RD.
NICKLE PLATE
2871.0
-016
92.92
-015
5.00
-014
-003
5.00 A.
-004
5.00 A.
1090
-005
1.79 A.
PECK - WADSWORTH
2330.93
1122