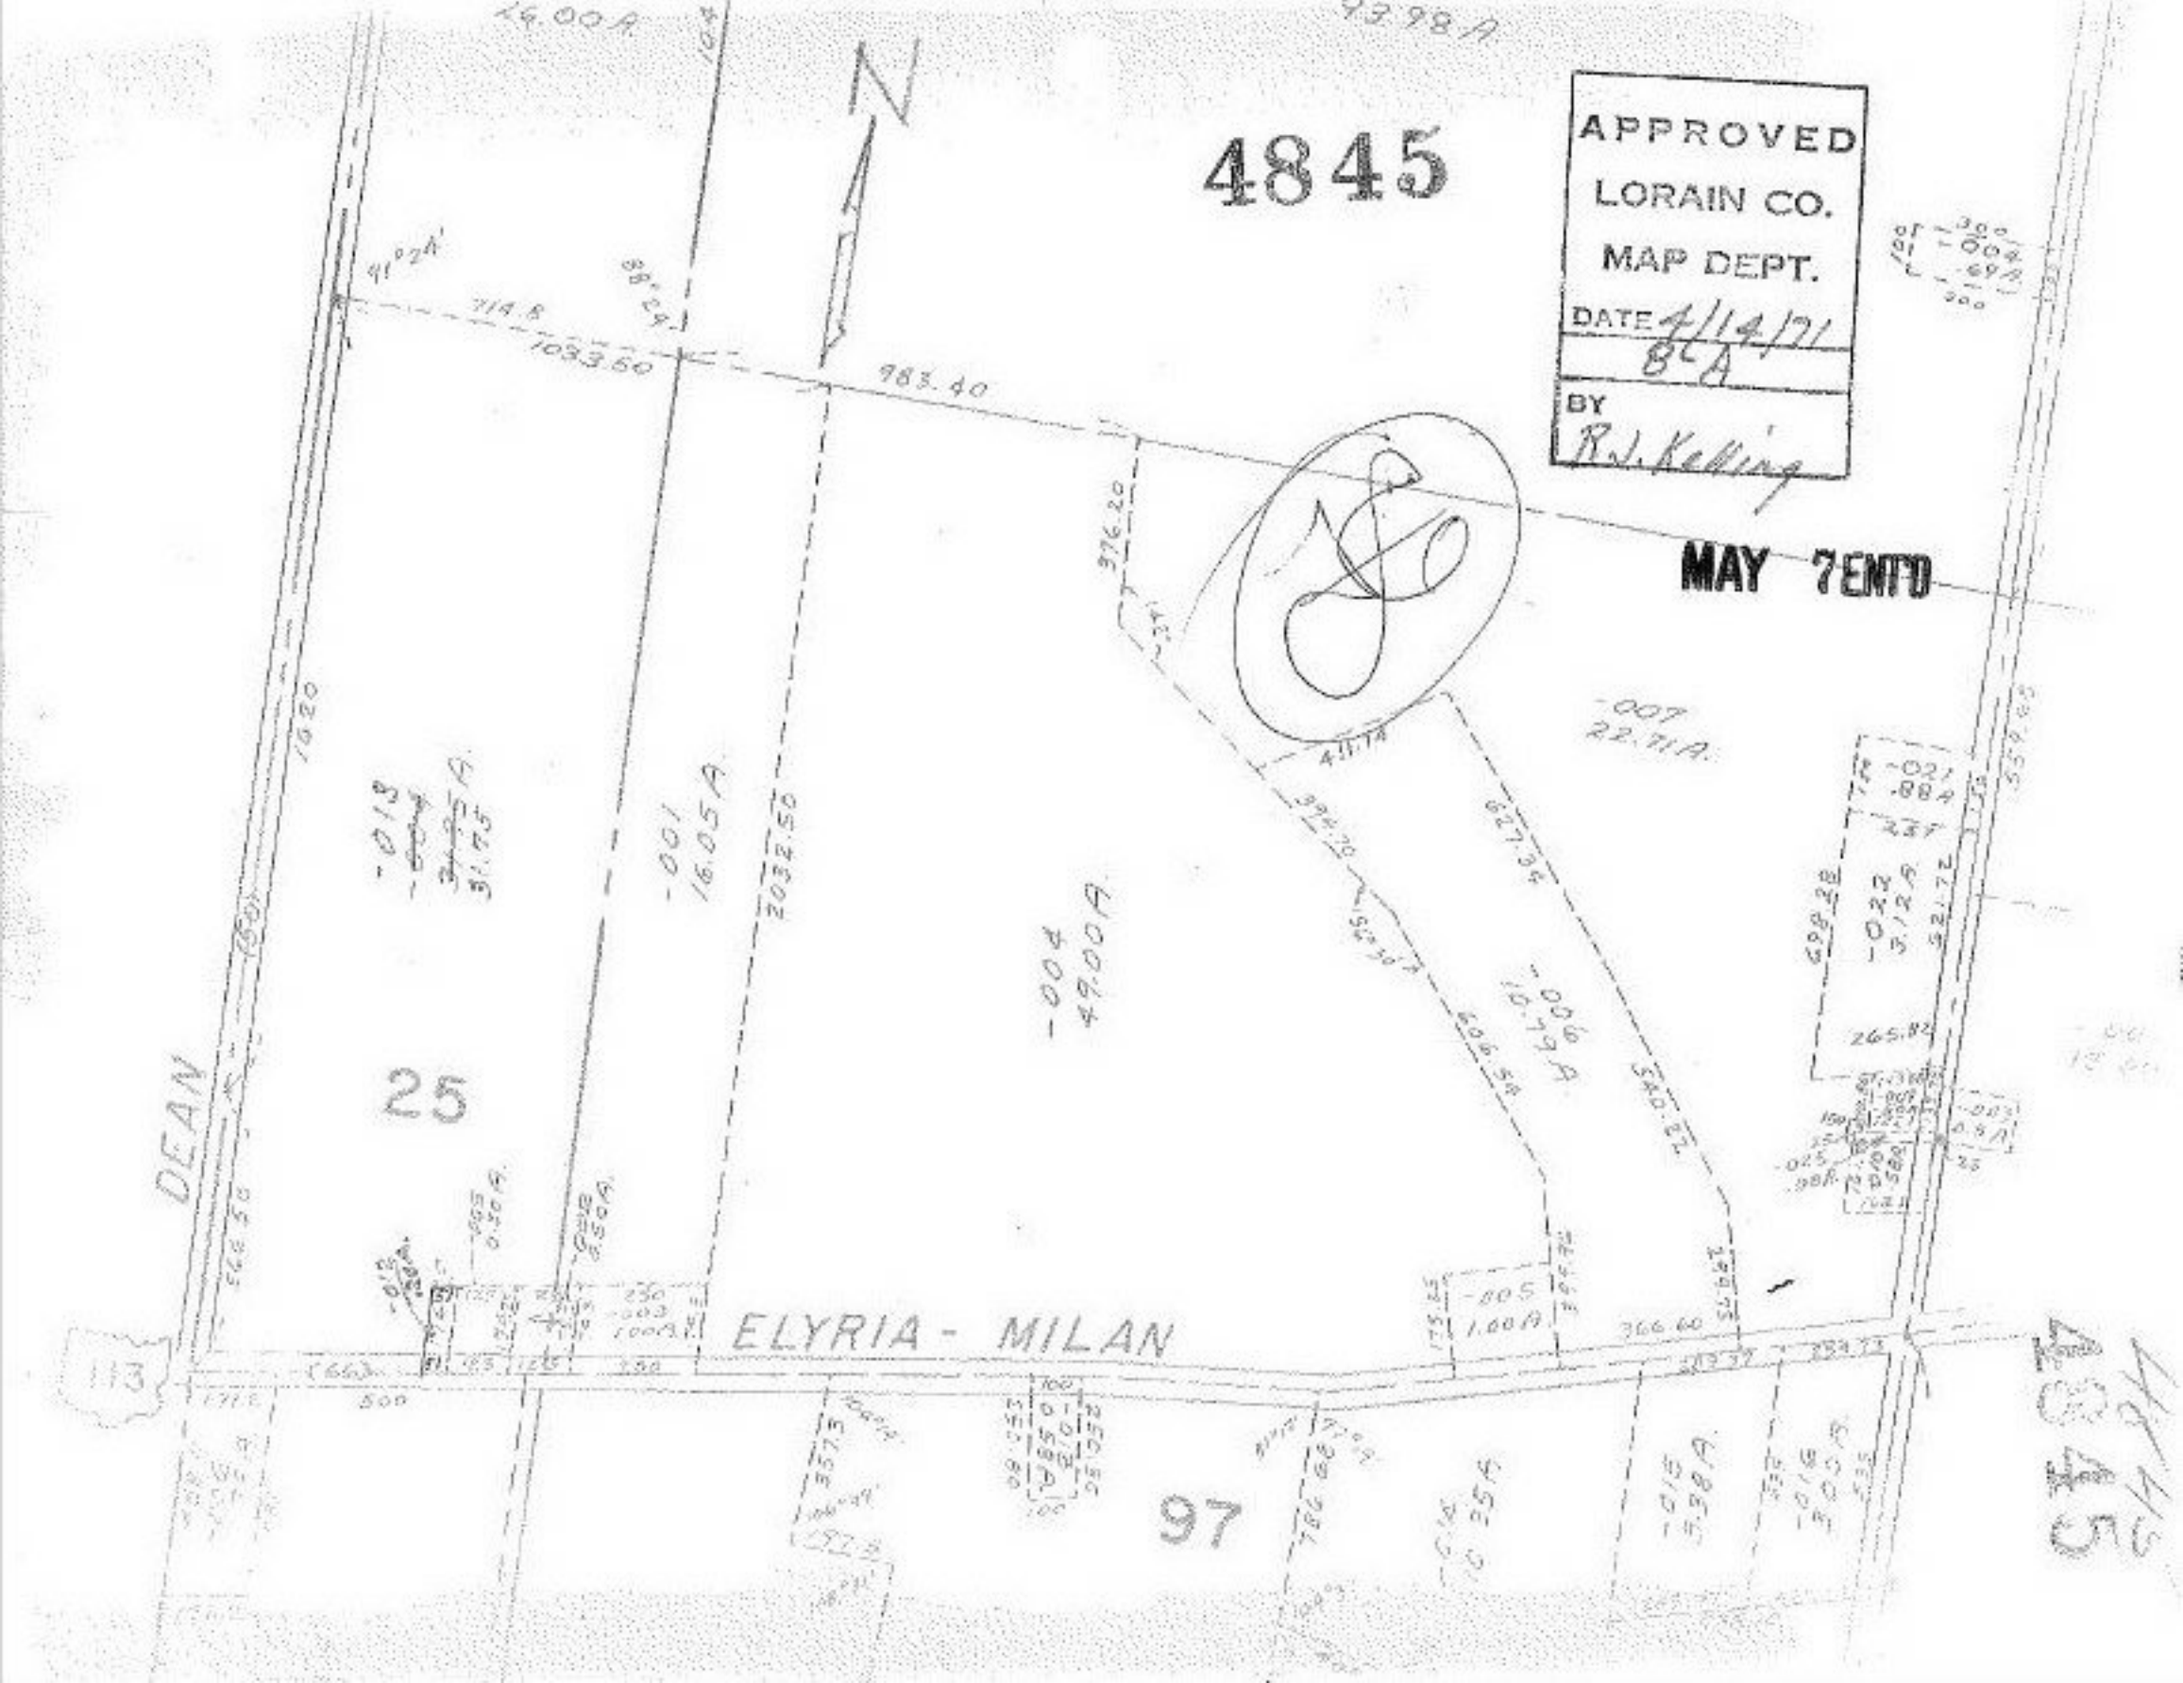
4845
APPROVED
LORAIN CO.
MAP DEPT.
DATE 4/14/71
BY R.J. Kelling
MAY 7 ENT'D
N
DEAN
ELYRIA - MILAN
25
97
113
-004
49.00A
-001
16.05A
-007
22.71A
-006
10.79A
-005
1.00A
-013
31.75A
-022
3.12A
-021
.88A
-015
3.38A
-016
3.00A
983.40
1033.60
714.8
2032.50
376.20
627.34
540.22
366.60
1620
4845