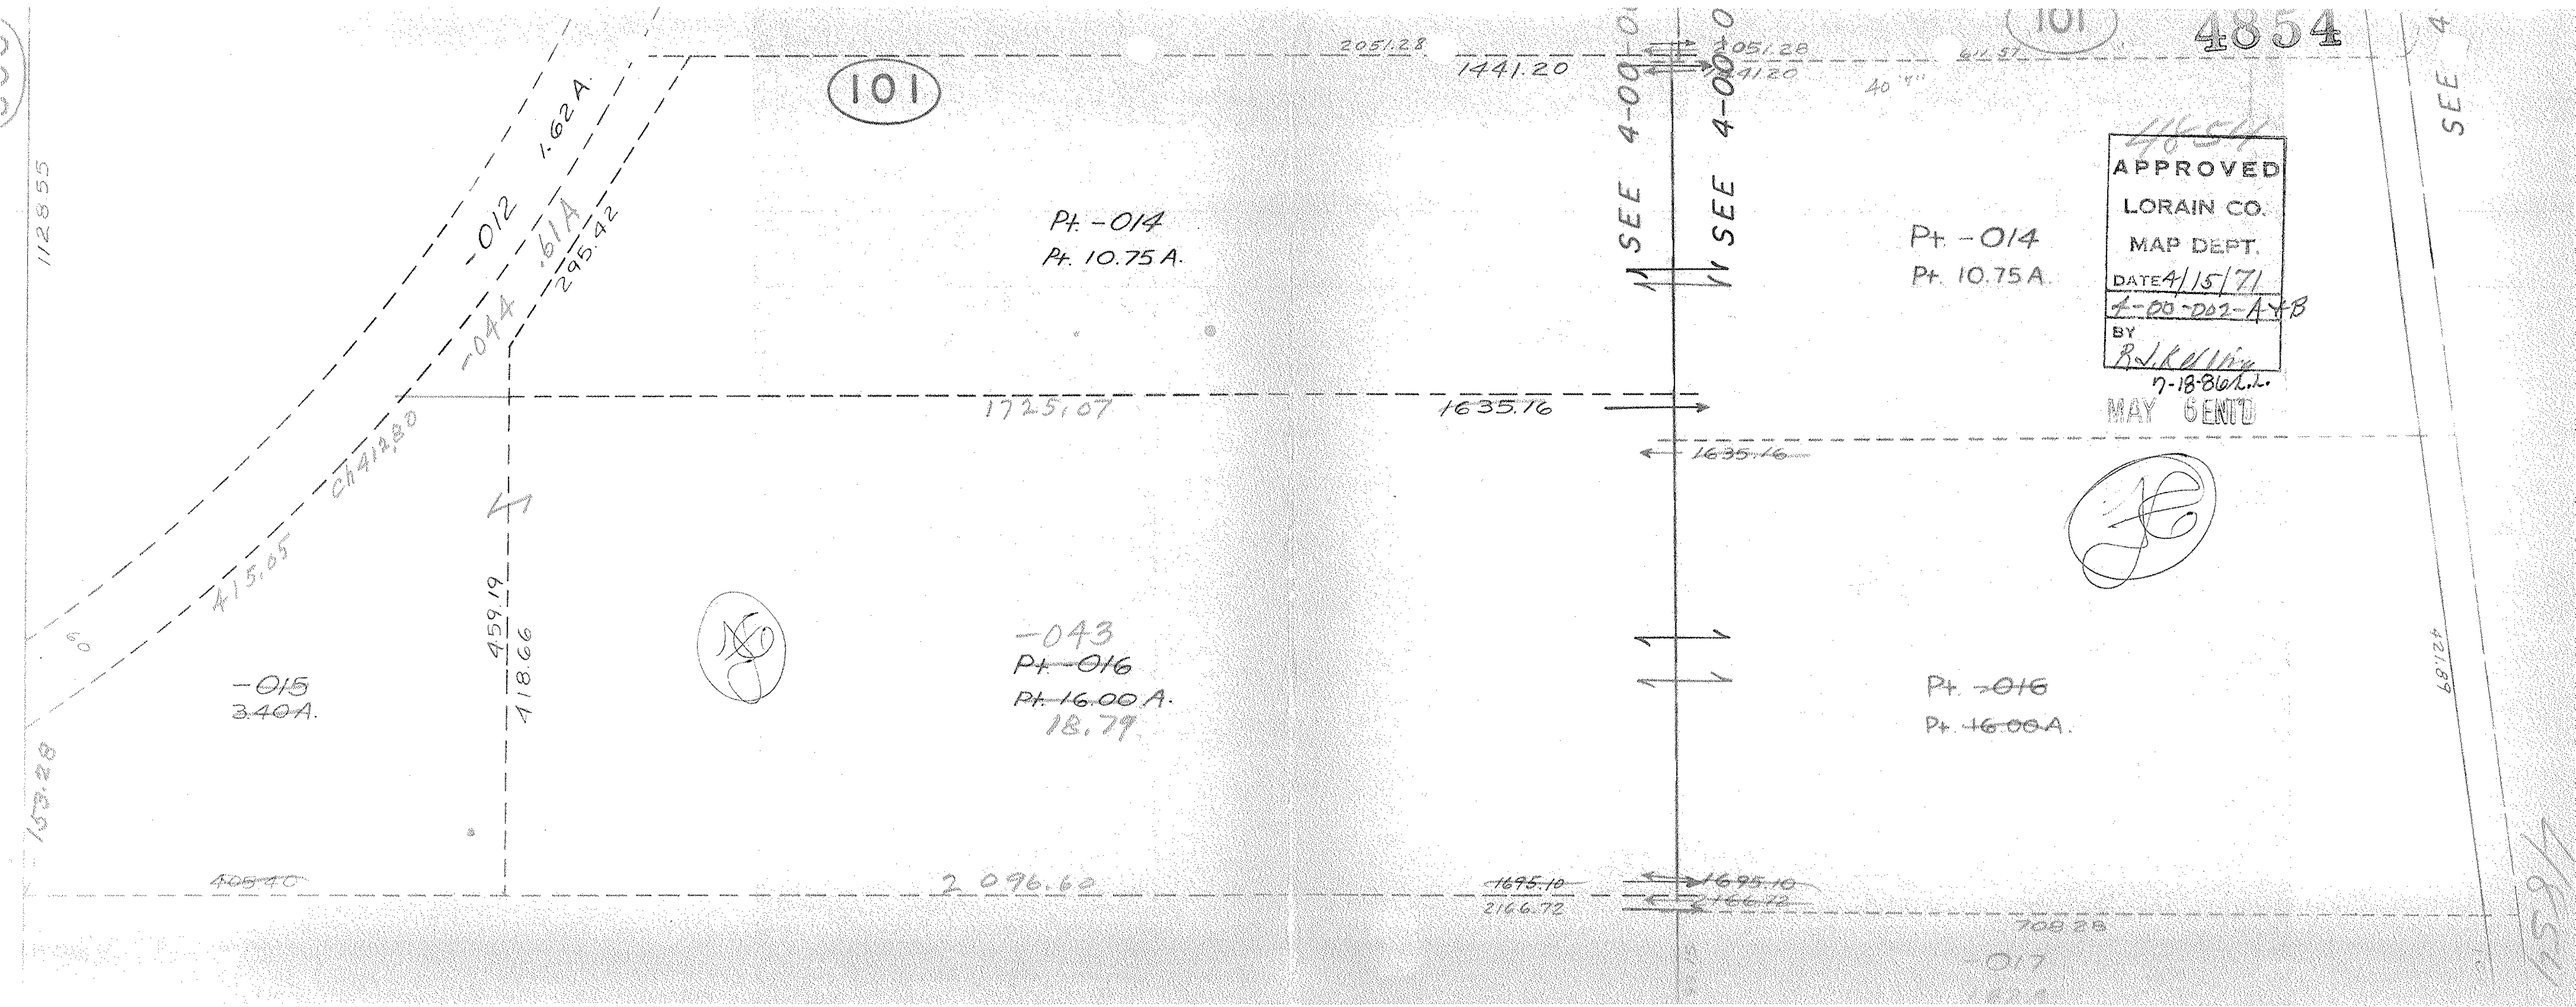

4854
101
2051.28
1441.20
SEE 4-00-0
SEE 4-00-0
SEE 4
APPROVED
LORAIN CO.
MAP DEPT.
DATE 4/15/71
4-00-002-A+B
BY
7-18-86
MAY 6 ENT'D
Pt. -014
Pt. 10.75 A.
Pt. -014
Pt. 10.75 A.
1725.07
1635.16
1635.16
-012
1.62 A.
-044
.61A
295.42
Ch 412.80
415.05
459.19
418.66
-015
3.40 A.
-043
Pt. -016
Pt. 16.00 A.
18.79
Pt. -016
Pt. 16.00 A.
1128.55
153.28
405.40
2 096.60
1695.10
2166.72
1695.10
2166.72
708.28
-017
421.89