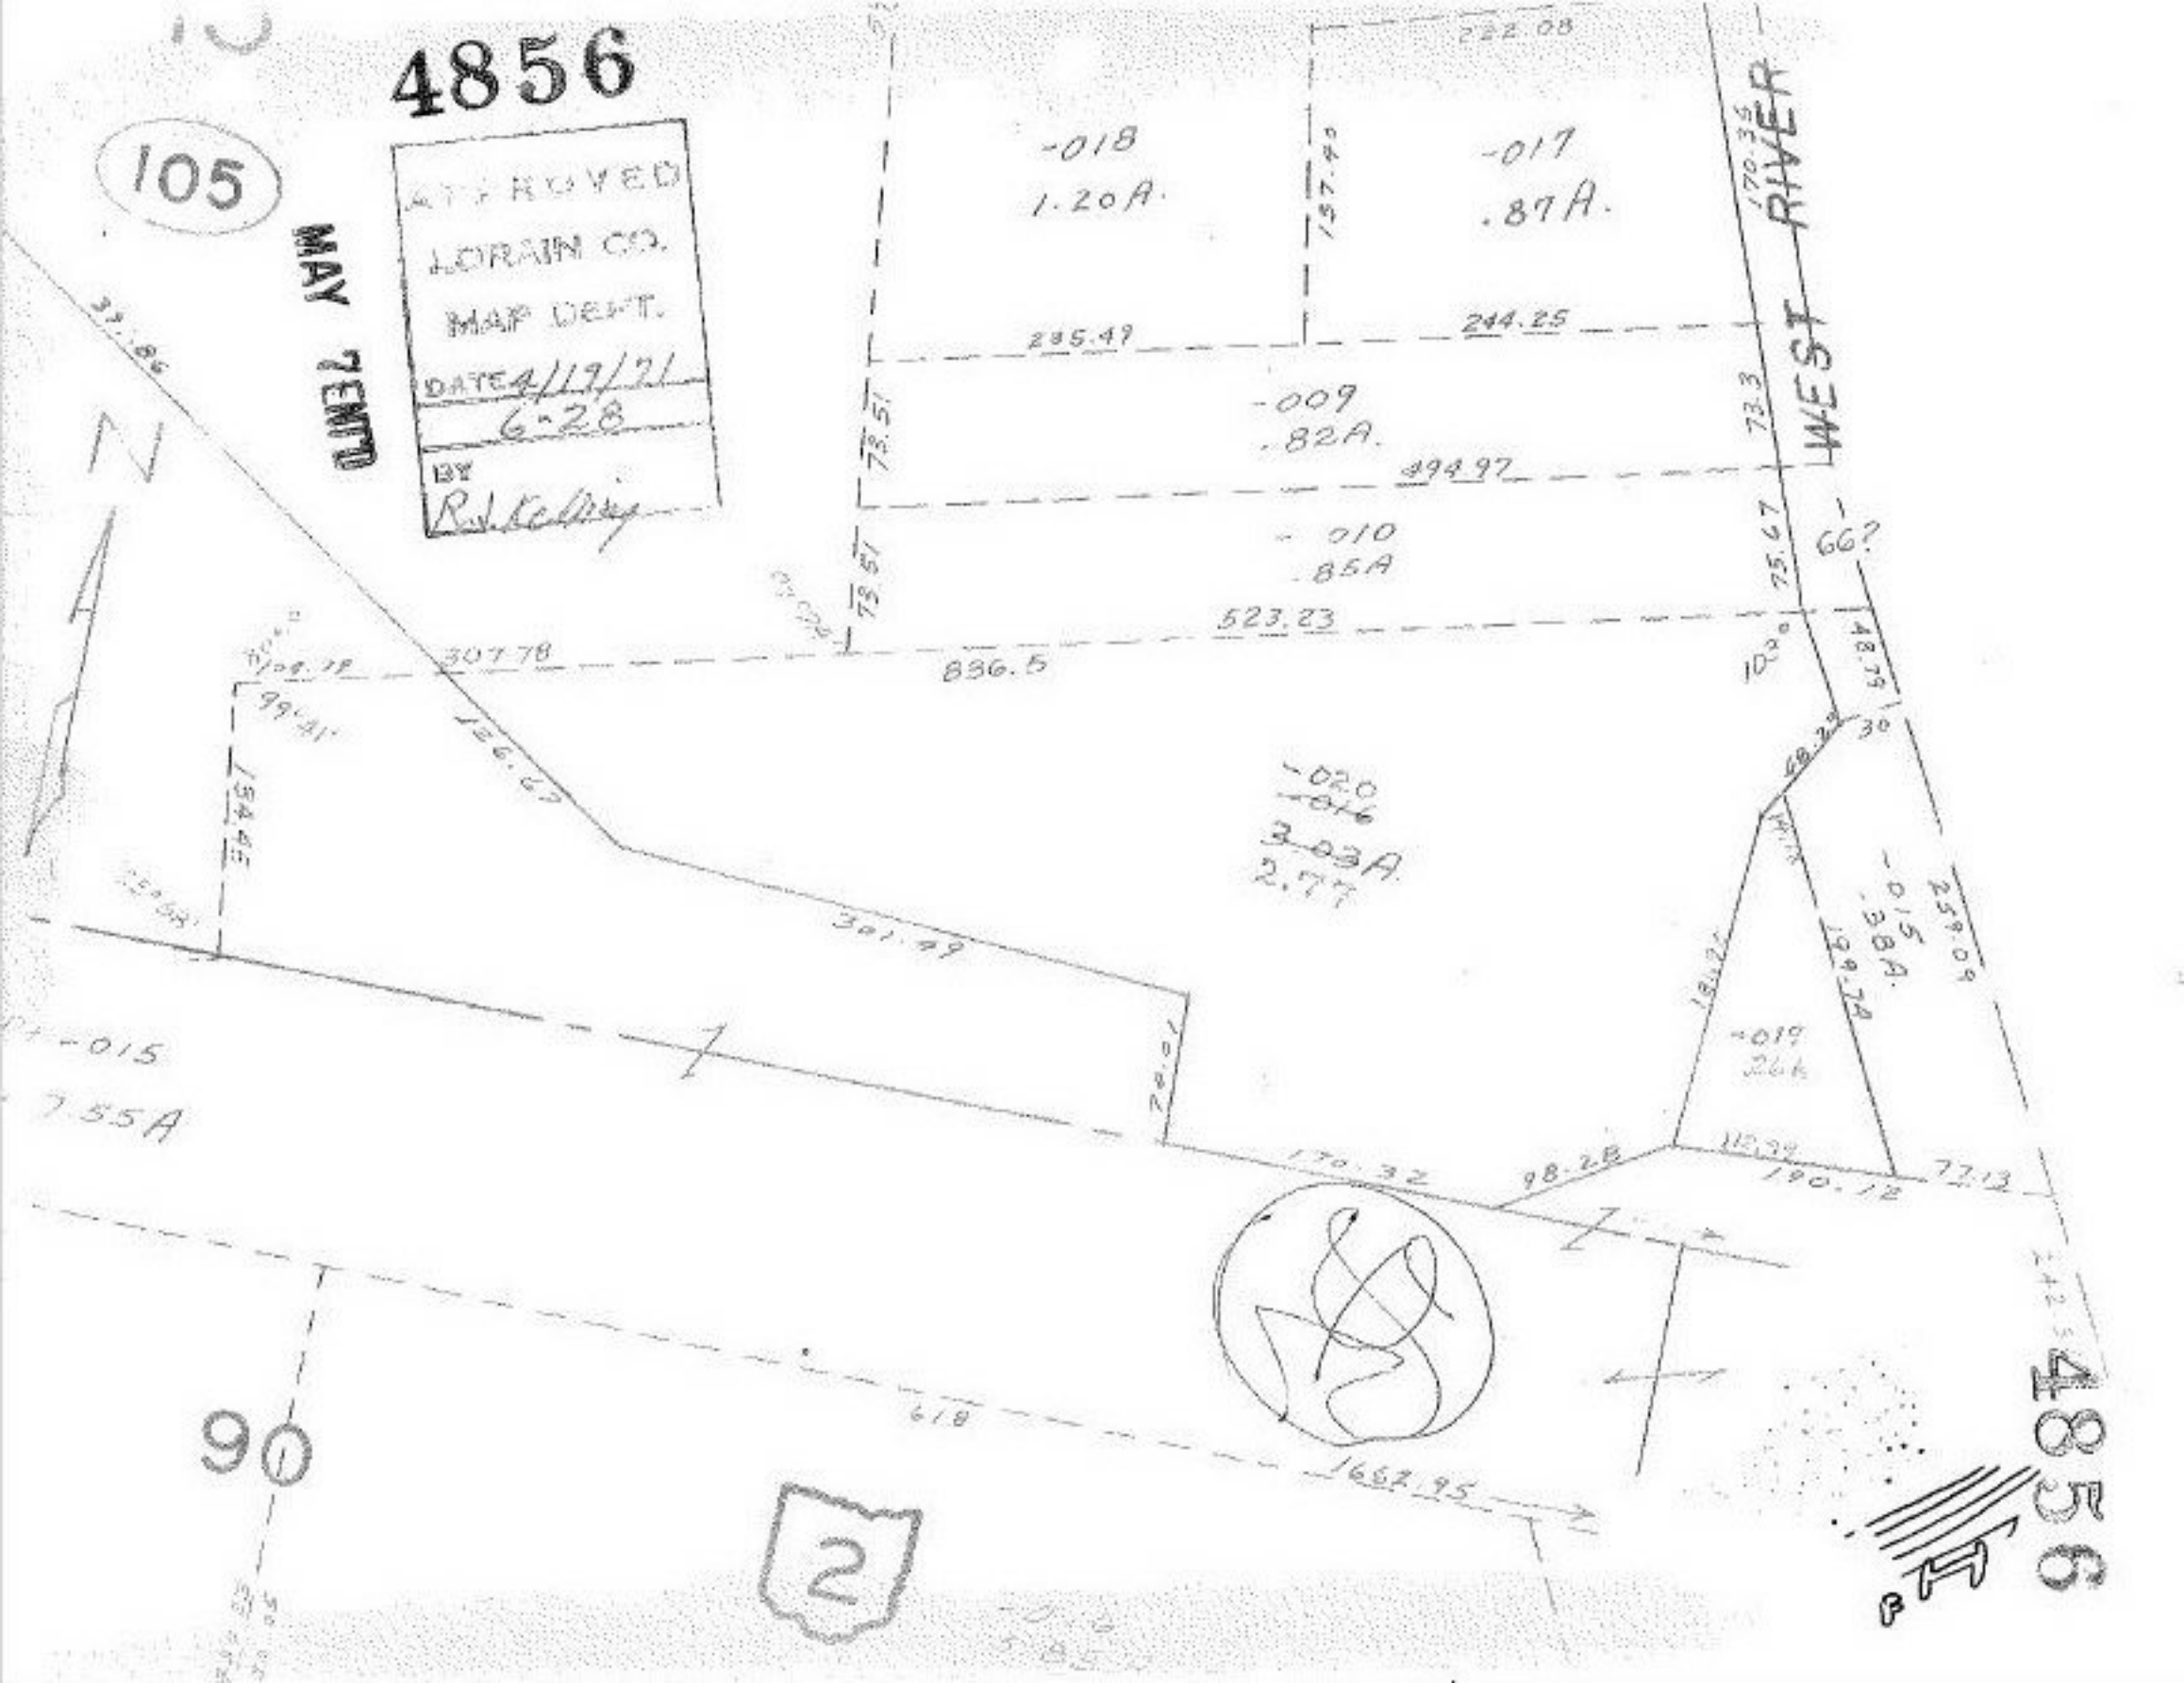
4856
105
MAY 7 ENT'D
APPROVED
LORAIN CO.
MAP DEPT.
DATE 4/19/71
6-28
BY
-018
1.20A.
-017
.87A.
222.08
137.40
170.35
WEST RIVER
235.49
244.25
-009
.82A.
73.51
73.3
494.97
-010
.85A
75.67
66?
523.23
836.5
307.78
126.67
-020
-016
3.03A.
2.77
301.49
-015
.38A.
259.09
-019
26A
-015
7.55A
170.32
98.28
190.12
77.13
618
1662.95
90
2
4856