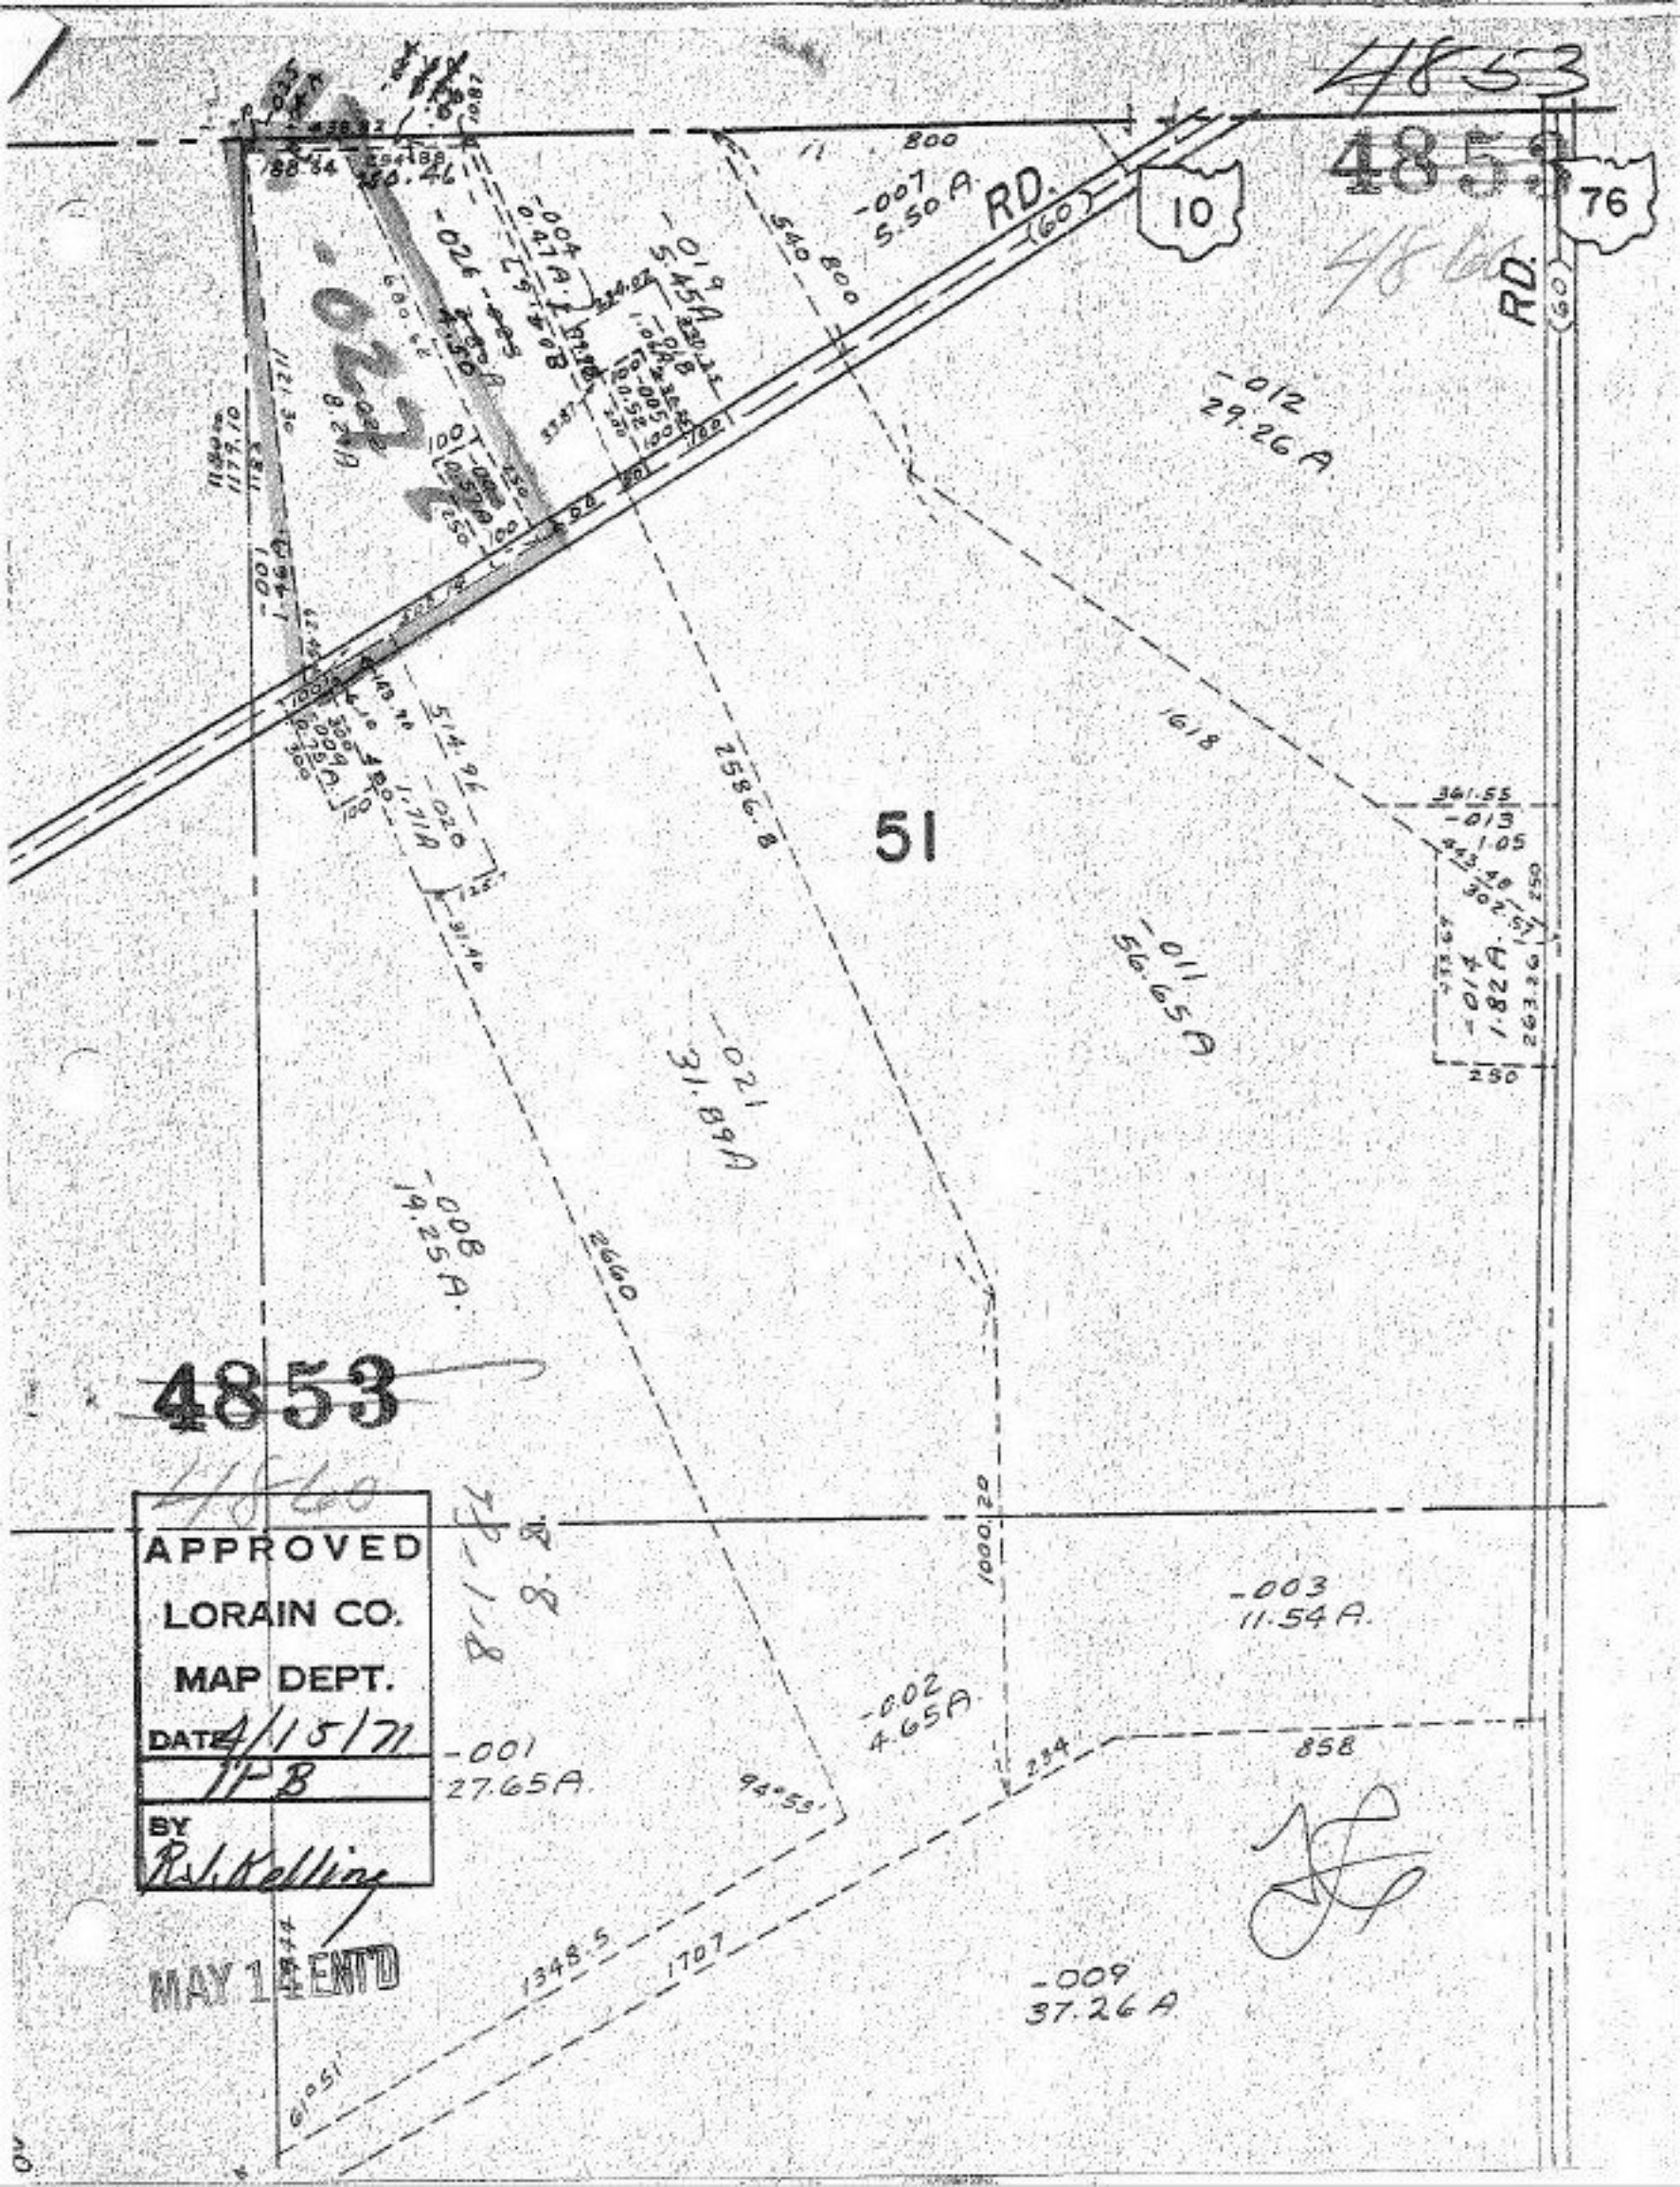
4853
4853
4860
RD.
(60)
10
76
RD.
(60)
-007
5.50 A.
-012
29.26 A.
51
-011
56.65 A
-021
31.89 A
-008
19.25 A.
-003
11.54 A.
-002
4.65 A.
-001
27.65 A.
-009
37.26 A
2586.8
2660
1618
1000.20
858
1348.5
1707
APPROVED
LORAIN CO.
MAP DEPT.
DATE 4/15/71
BY
MAY 14 ENT'D