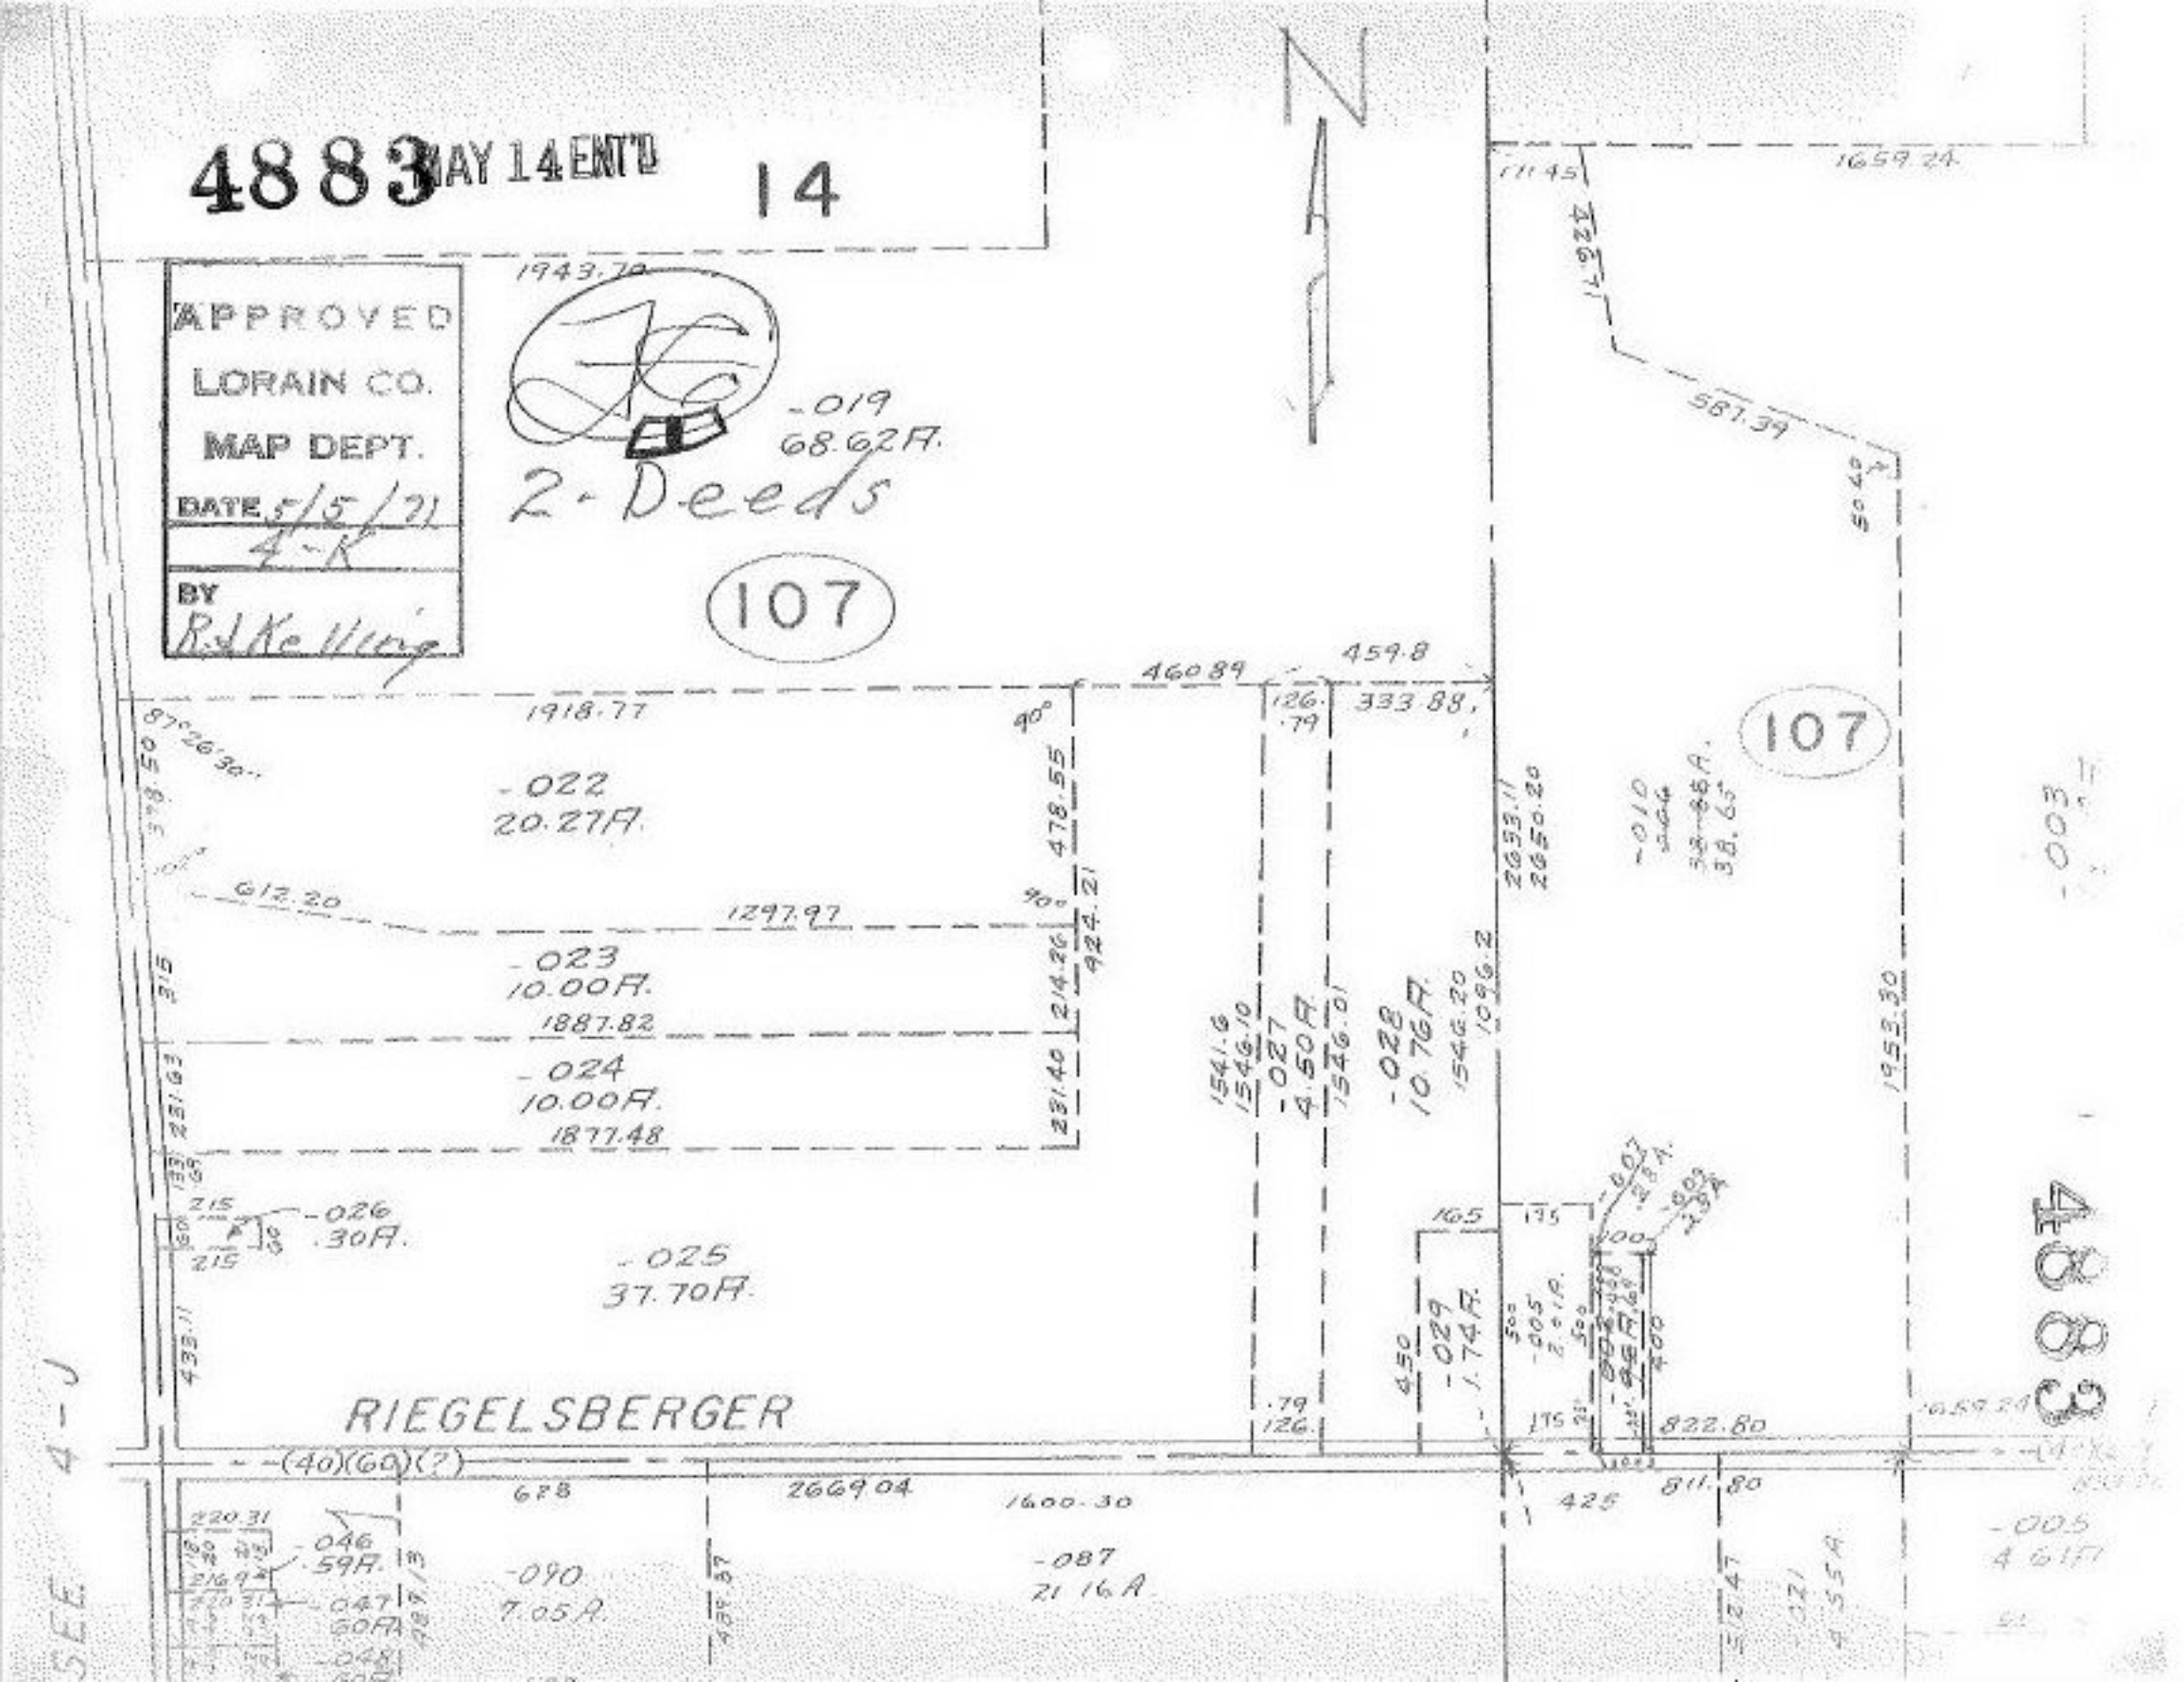
4883
MAY 14 ENT'D
14
APPROVED
LORAIN CO.
MAP DEPT.
4-K
BY
R.J. Kelly
1943.70
-019
68.62A.
2-Deeds
107
1659.24
111.45
1226.71
581.39
50.40
460.89
459.8
126.79
333.88
1918.77
87°26'30"
90°
478.55
-022
20.27A.
612.20
1297.97
924.21
214.26
281.40
-023
10.00A.
1887.82
-024
10.00A.
1877.48
231.63
315
215
-026
.30A.
215
-025
37.70A.
433.11
RIEGELSBERGER
(40)(60)(?)
678
2669.04
1600.30
-090
7.05A.
-087
21.16A.
-046
.59A.
-047
.60A.
-048
2653.11
2650.20
-010
38.66A.
38.63
1952.30
1541.6
1546.10
-027
4.50A.
1546.01
1546.20
1046.2
-028
10.76A.
165
135
-029
1.74A.
450
400
822.80
511.80
425
-005
4.61A.
-021
4.35A.
-003
4884
4-J